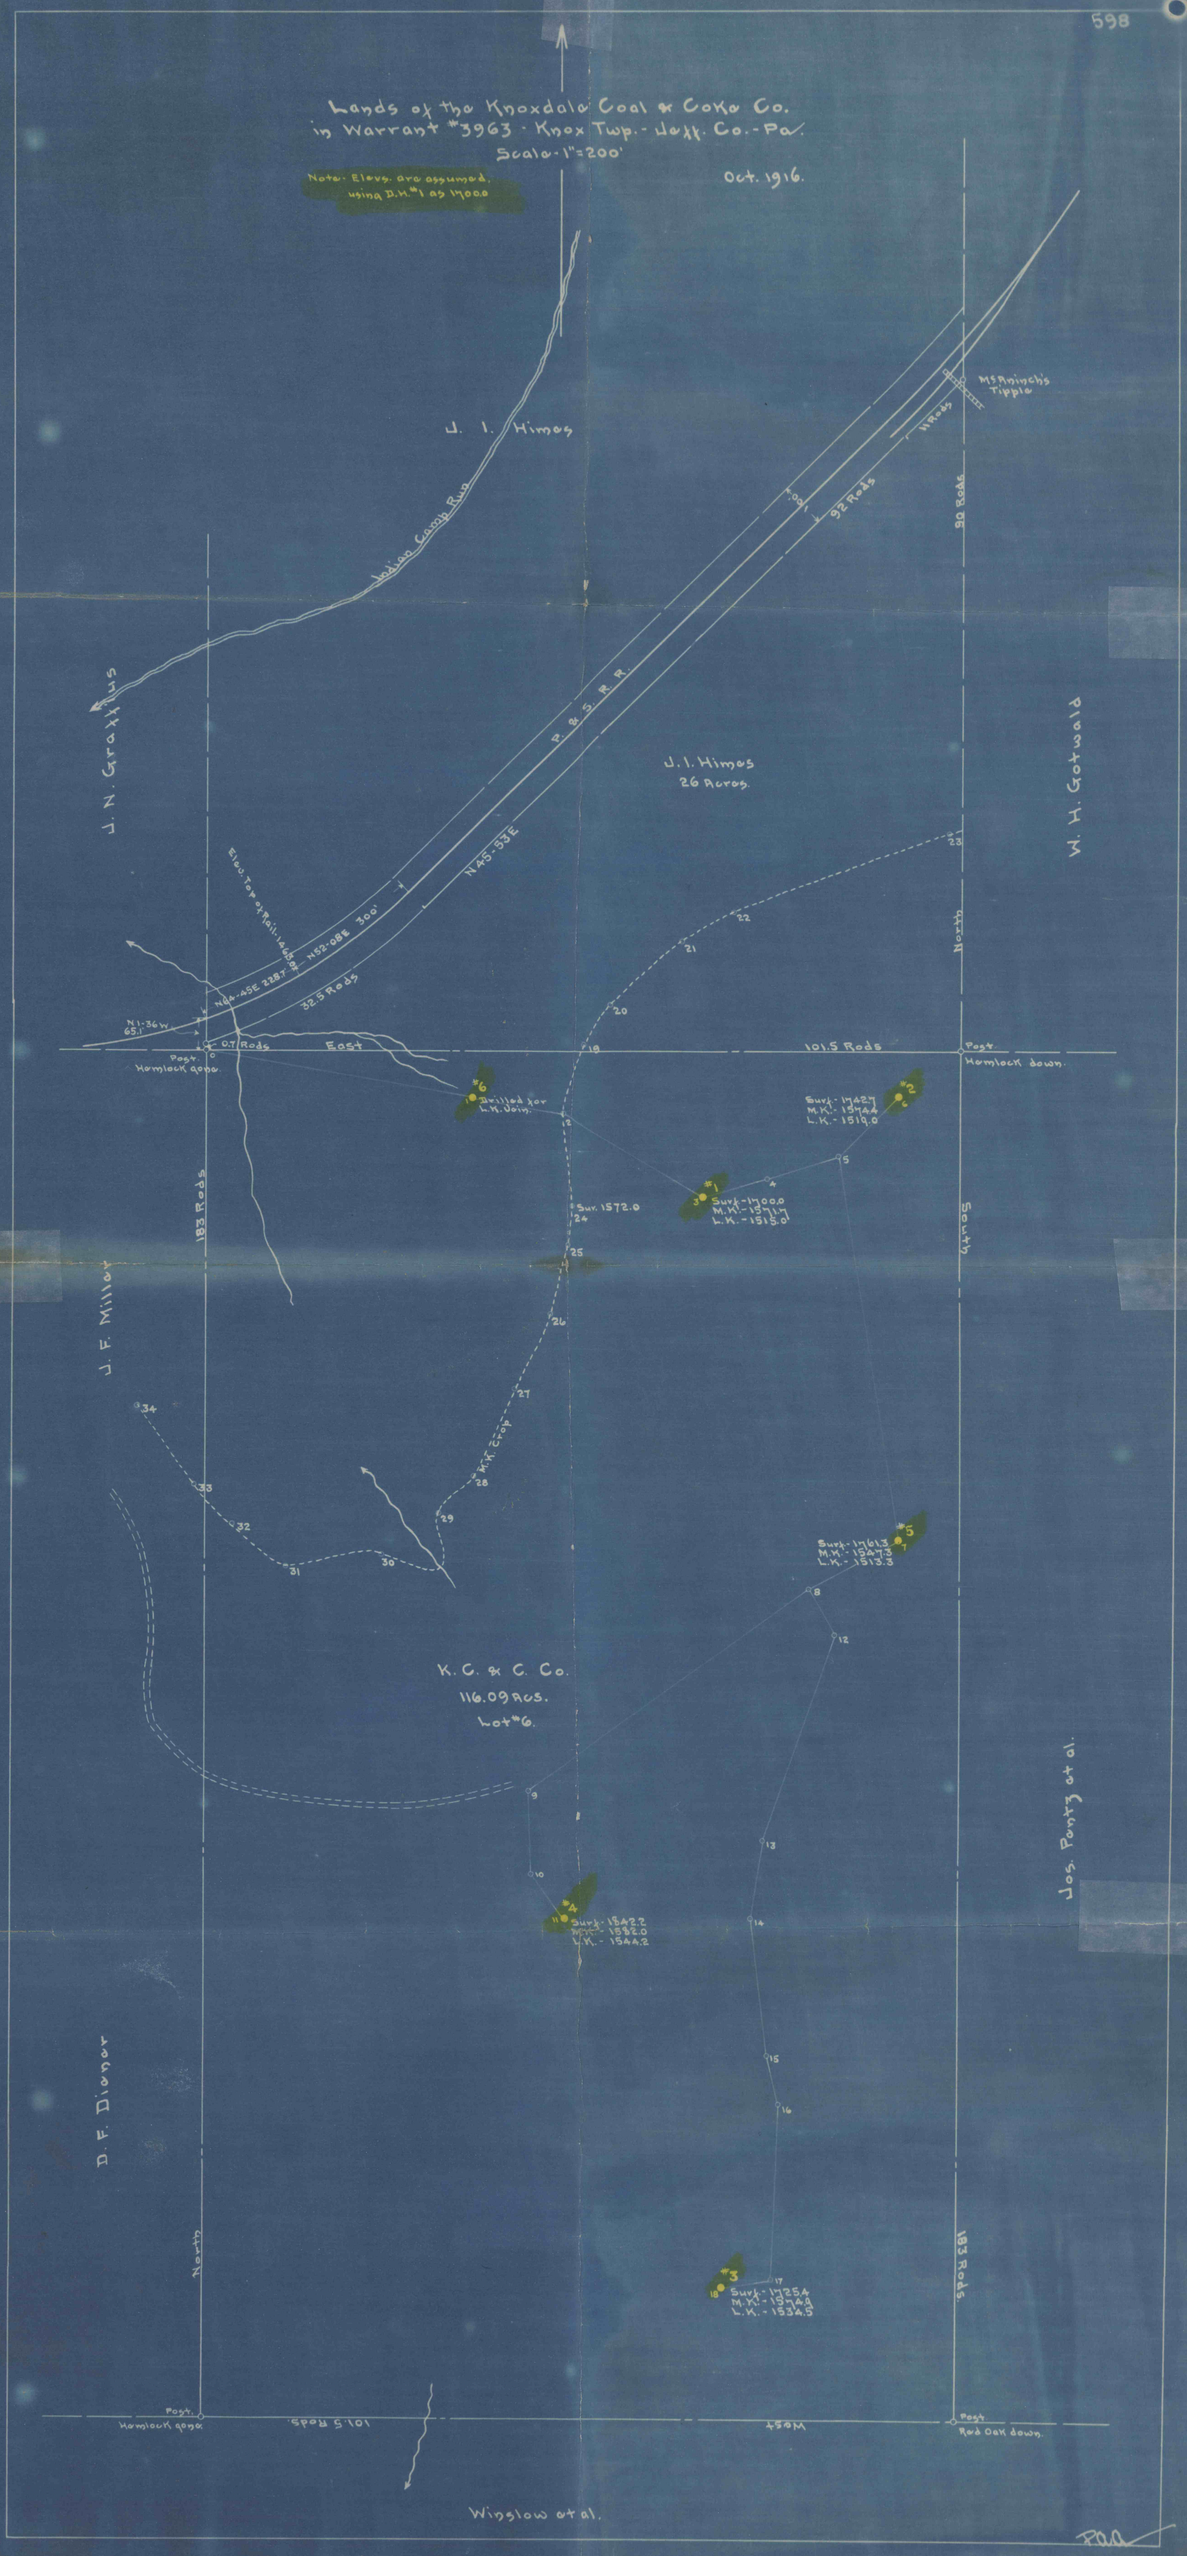
Lands of the Knoxdale Coal & Coke Co.
in Warrant #3963 - Knox Twp. - Jeff. Co. - Pa.
Scale - 1" = 200'
Note - Elevs. are assumed, using D.H. #1 as 1700.0
Oct. 1916.
J. I. Himes
Indian Camp Run
McAninch's Tipple
11 Rods
92 Rods
90 Rods
P. & S. R. R.
J. N. Graffius
J. I. Himes
26 Acres
W. H. Gotwald
N45-53E
Elev. Top of Rail - 1465.0
N52-08E 300'
N44-45E 228.7
32.5 Rods
N1-36W 65.1
0.7 Rods
East
101.5 Rods
Post
Hemlock gone
Post
Hemlock down
North
South
#6
Drilled for L.K. Vein
#2
Surf. - 1742.7
M.K. - 1574.4
L.K. - 1519.0
#1
Surf. - 1700.0
M.K. - 1571.7
L.K. - 1515.0
Sur. 1572.0
183 Rods
J. F. Miller
M.K. Crop
#5
Surf. - 1761.3
M.K. - 1547.3
L.K. - 1513.3
K. C. & C. Co.
116.09 Acs.
Lot #6.
Jos. Pentz et al.
#4
Surf. - 1542.2
M.K. - 1532.0
L.K. - 1544.2
D. F. Diener
#3
Surf. - 1725.4
M.K. - 1574.9
L.K. - 1534.5
North
183 Rods
Post
Hemlock gone
101.5 Rods
West
Post
Red Oak down
Winslow et al.