


PHILIP SMATHERS

J. H. BUSH

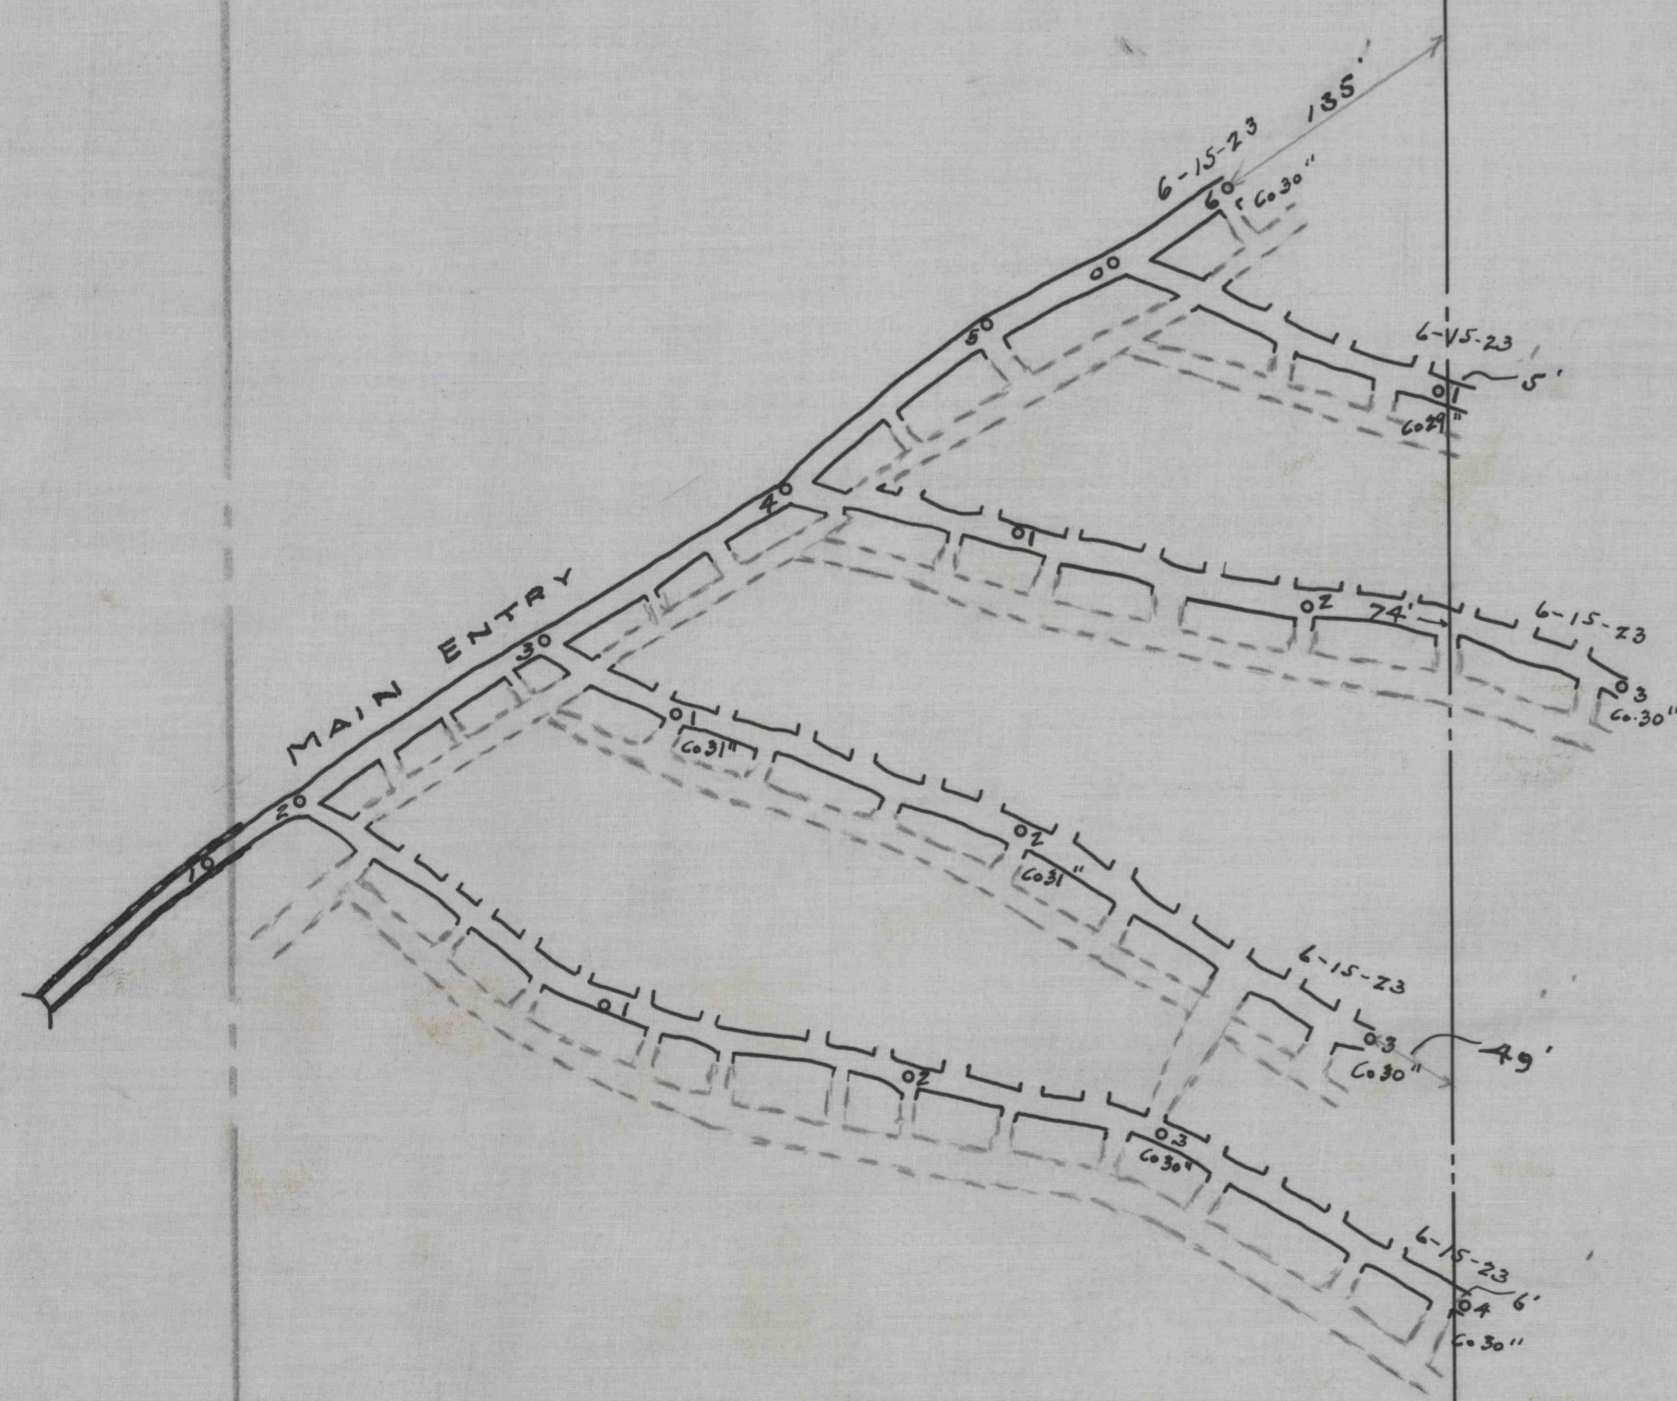

MAUK COAL CO. MINE

Showing Workings on  
PHILIP SMATHERS AND J. H. BUSH

1" = 100'  
6-15-23

J. S. Scott, Engr  
Brookville Office of H. M. Kanarr