


2000.0 North

1000.0 North

0.0 North

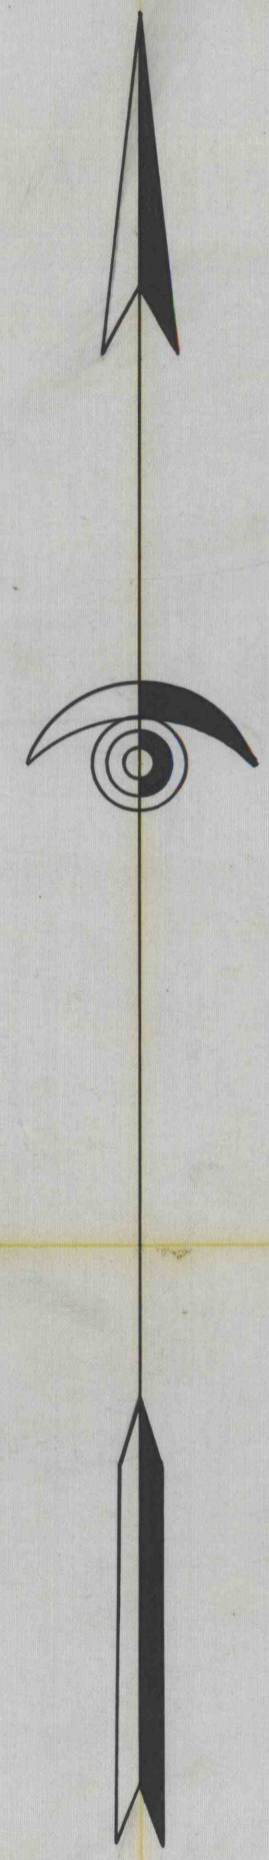

BISHOP

WYANT


SWAN COAL CO.
situated near
Knexdale, Knex Twp., Jeff. Co., Pa.

Scale 1"=100'

H.M. Konarr Eng'r.
Punxsutanney Pa.

EXTENT

MARY & MARIE BISHOP

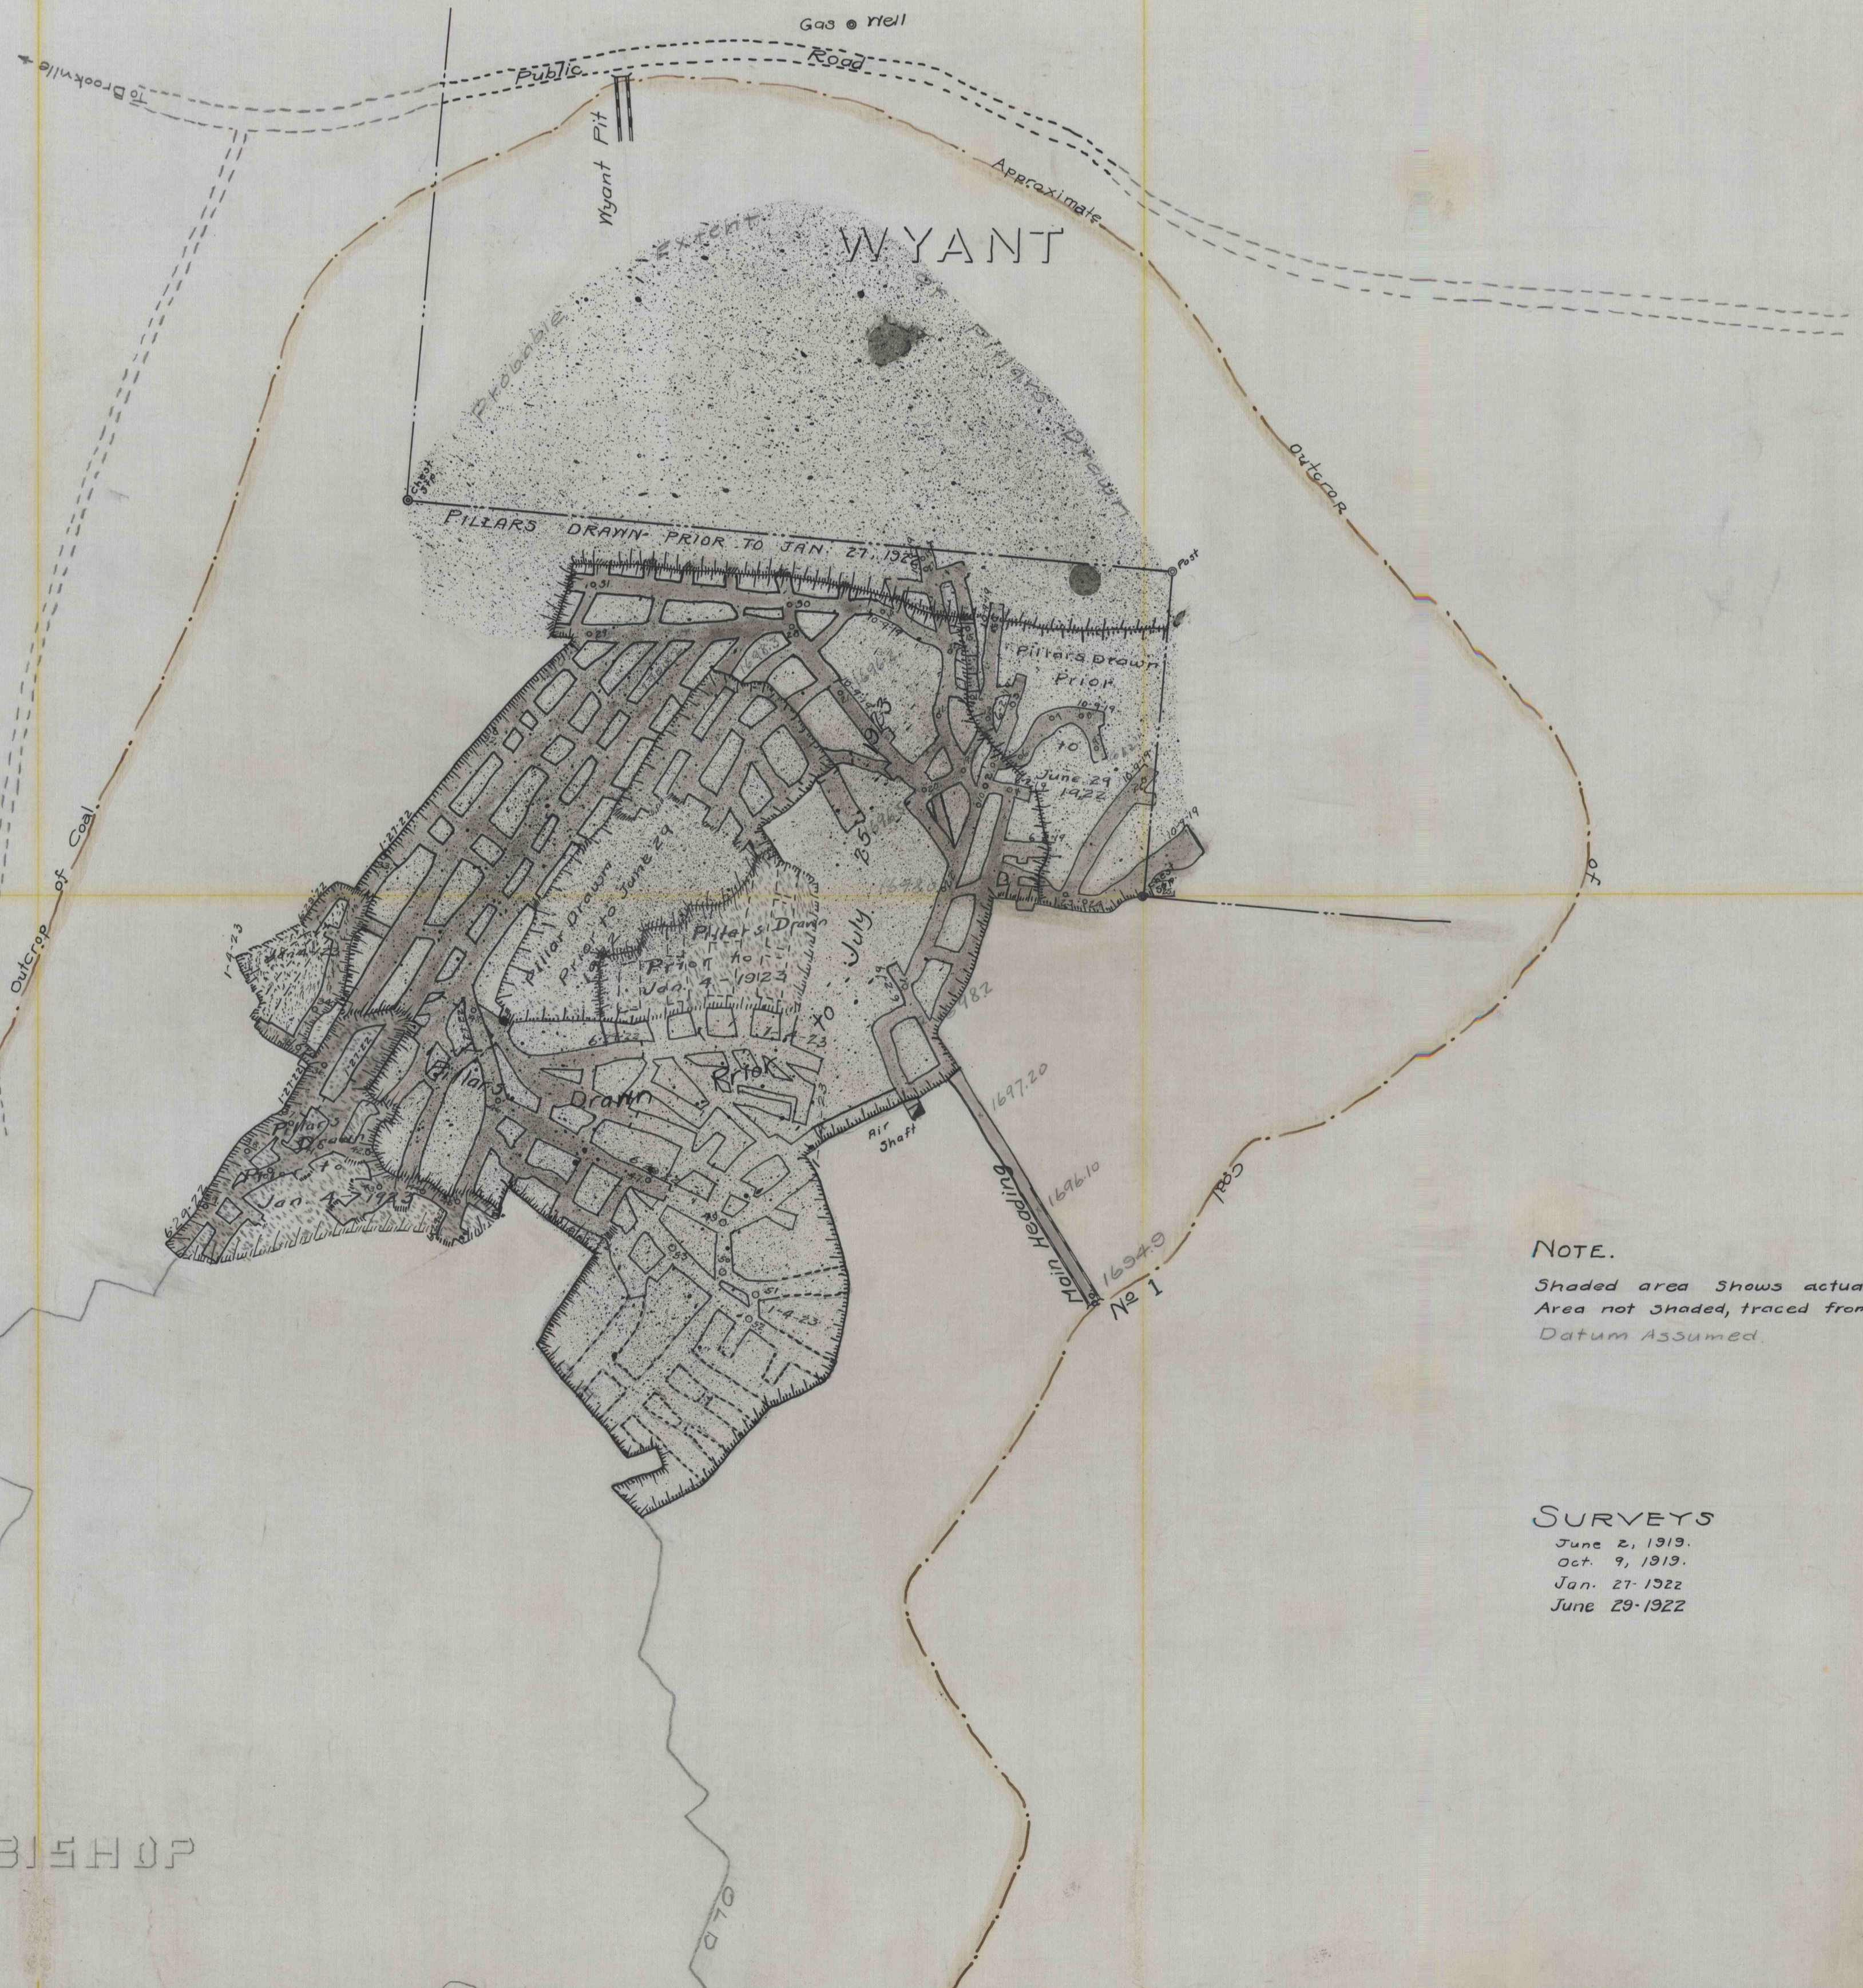

NOTE.
Shaded area shows actual surveys
Area not shaded, traced from other maps.
Datum Assumed.

SURVEYS
June 2, 1919.
Oct. 9, 1919.
Jan. 27, 1922
June 29, 1922

Z-B-9
Sheet 1