6000.0 South

APPROXIMATE

MARTIN CLOVER.

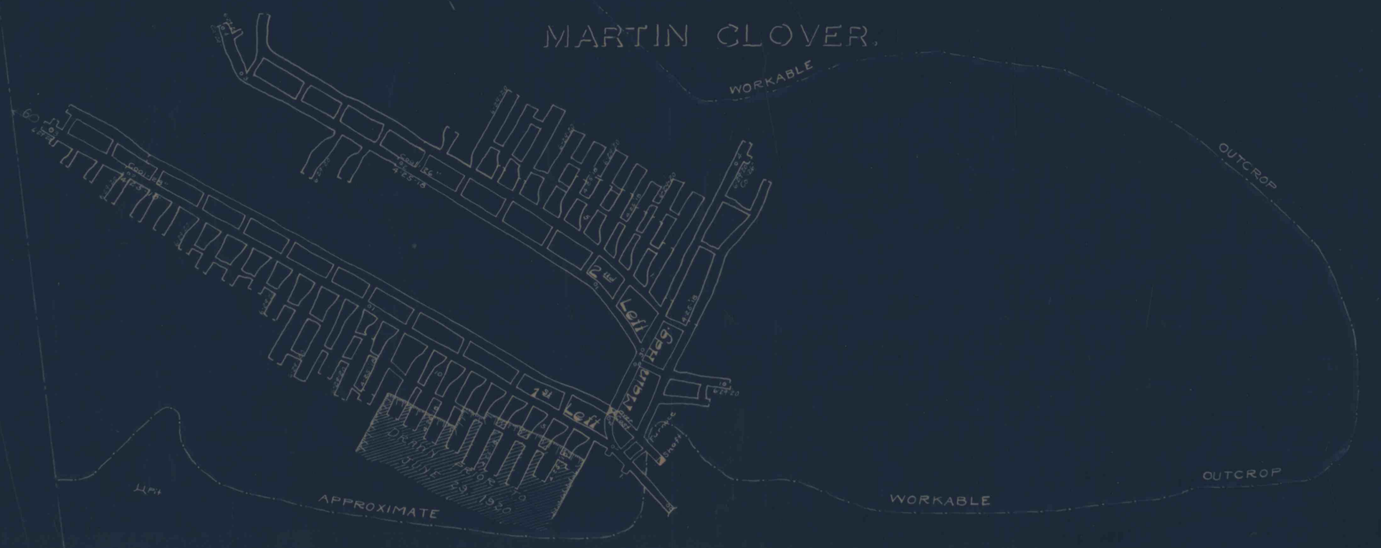

SURVEYS
MAY 23, 1918.
JUNE 29, 1920.

BROCK COAL Co.

Brookhavyille, Jefferson Co., Pa.

Scale 1"=100'

H.M. Kanaan, Engr.

Brookhaven, Pa., May 1918.

Hemlock
Toby Creek

6000.0 East