
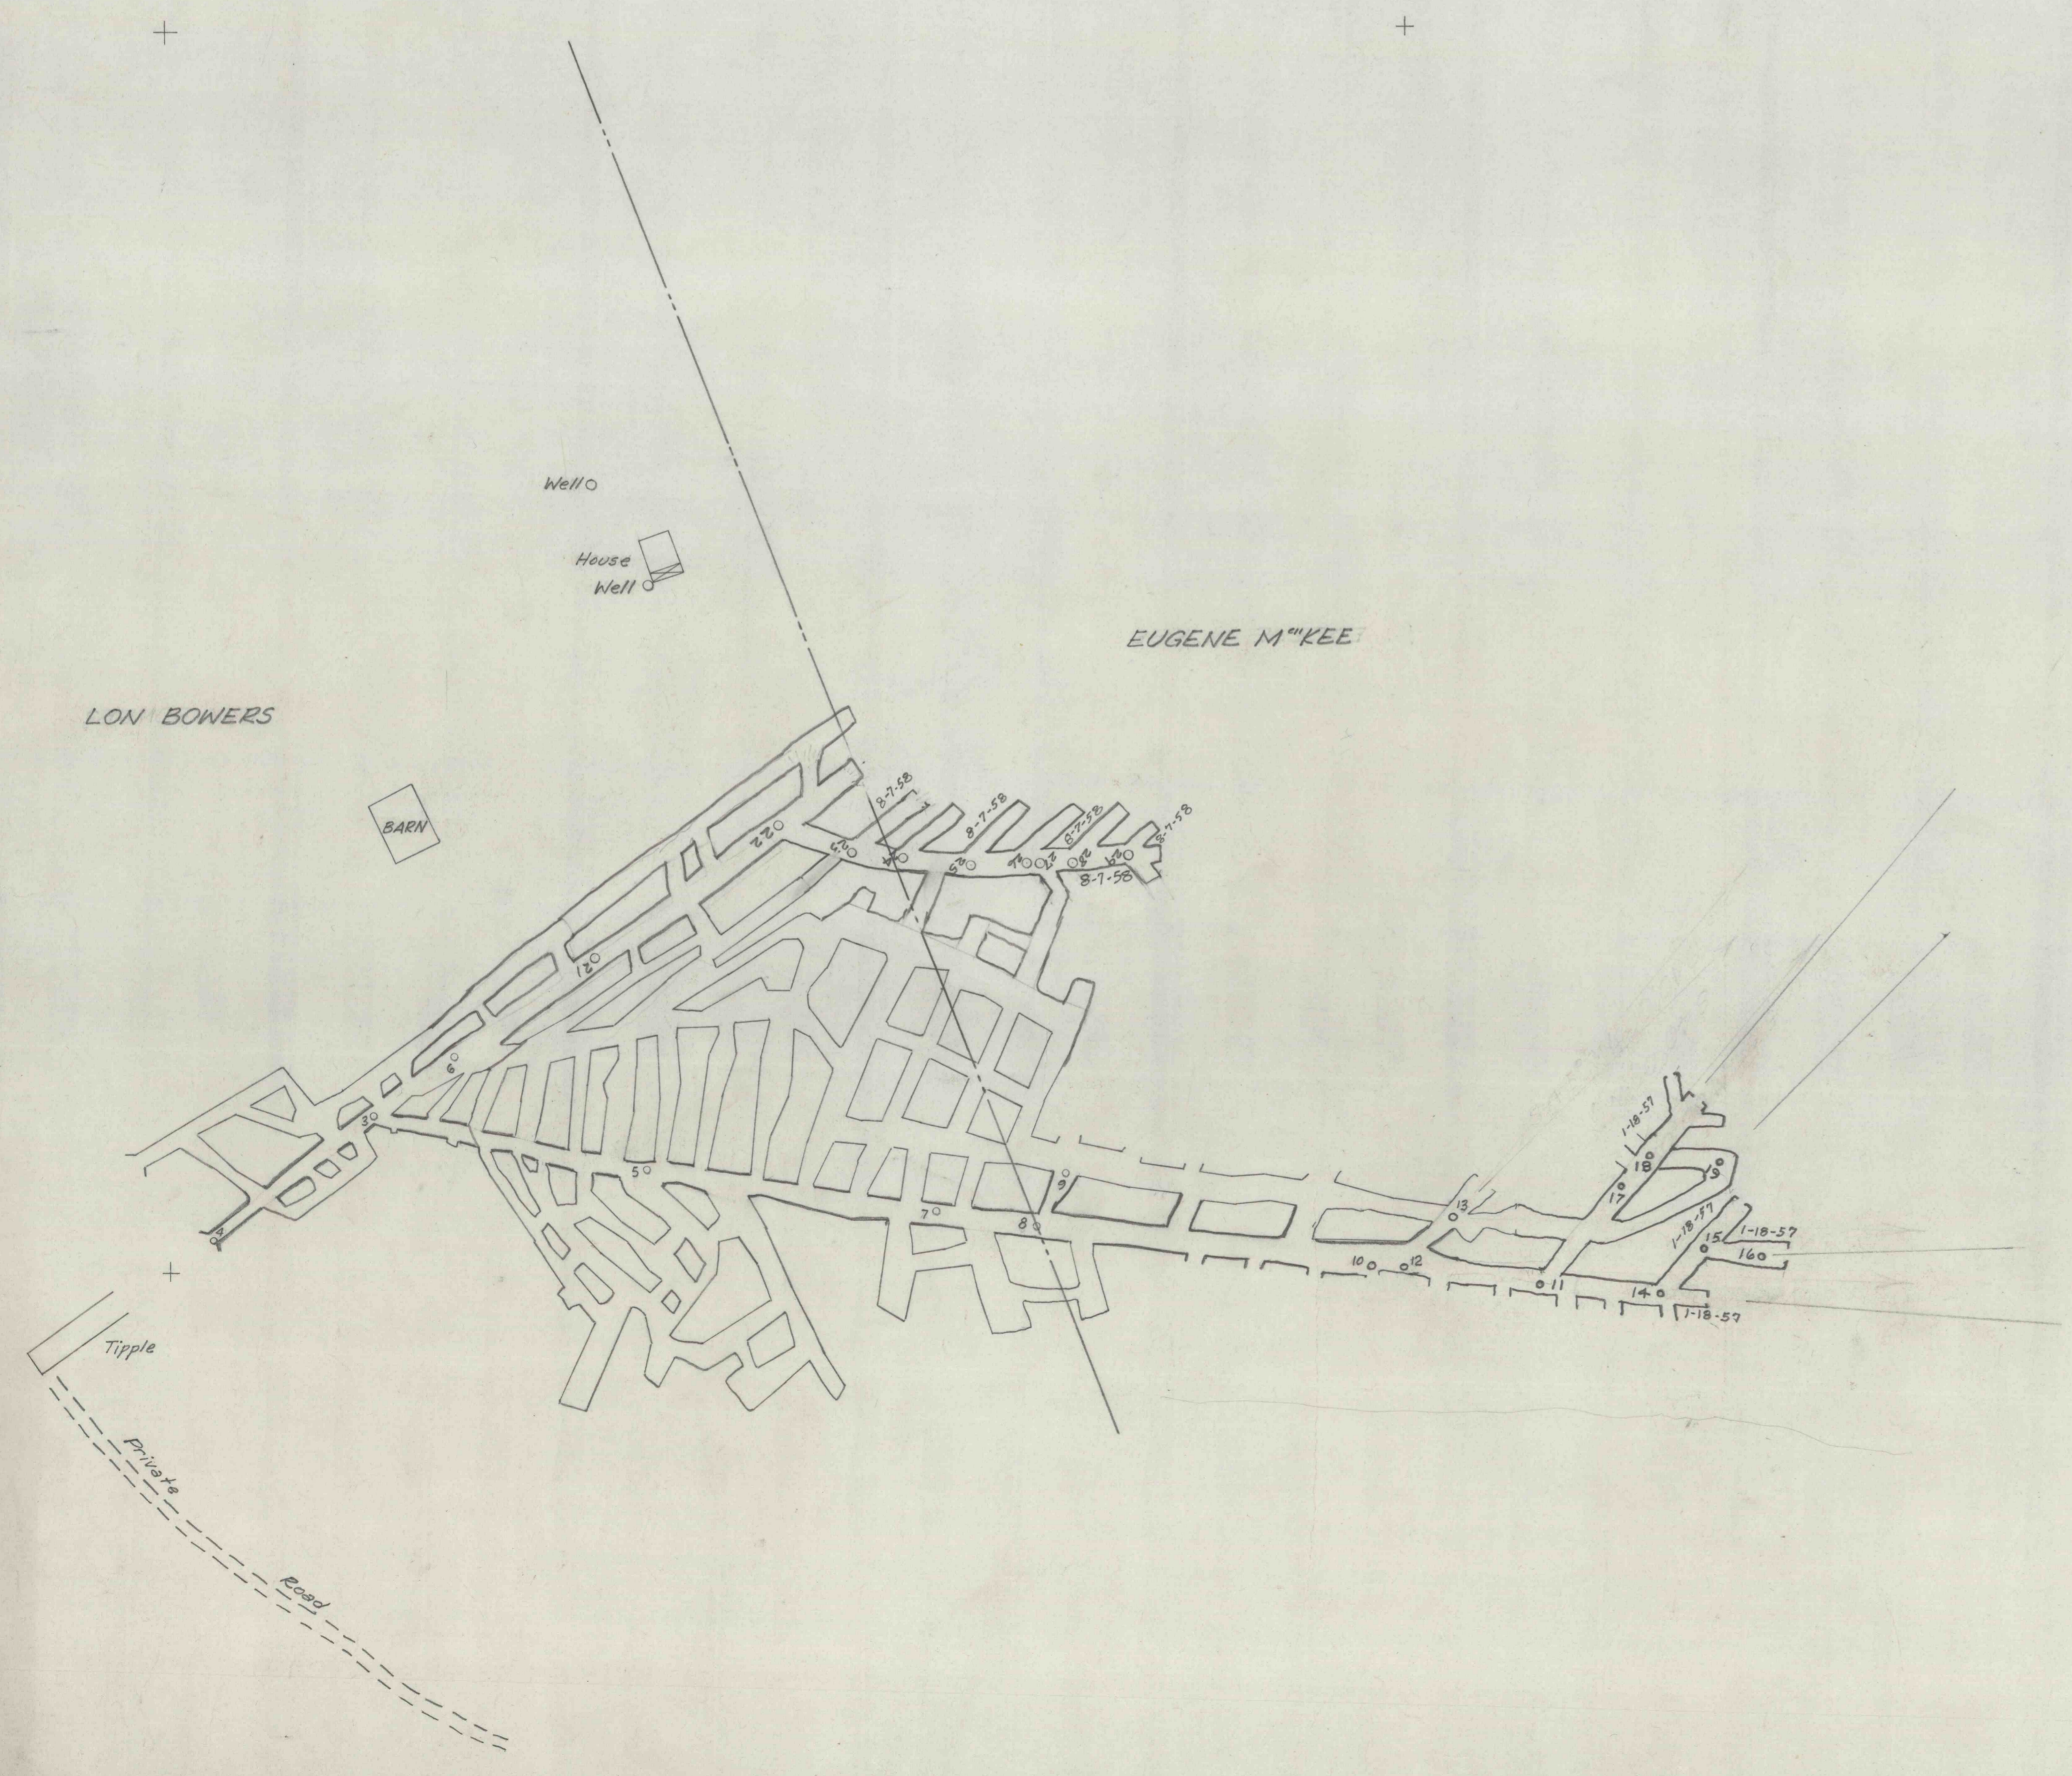


P. & N. COAL CO.
JAMES A. WHITE MINE No. 7
GASKILL TOWNSHIP, JEFFERSON COUNTY, PENNA.
SCALE 1"=100' AUGUST, 1956
Walter J. Zimmerman-Surveyor, Engineer - Pottsville, Penna.

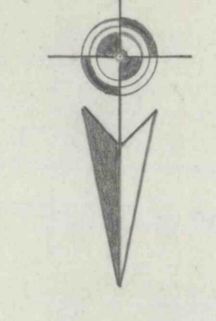

10-751