

Mine Map

Spencer Mark Coal Co., Inc.
 formerly Sprankles Mills Coal Co.
 Ringgold Twp., Jeff. County

STAHLMAN EST.
 ST MARYS SEWER PIPE CO. COAL

Scale 1"=100'


August 1920

Harry M. Watker,
 Engineer
 Punxsutawney Pa.

DATE OF SURVEYS

August	2, 1926
MAY	24, 1922
Oct.	21, 1924
MAY	12, 1926
Sept.	1, 1927
JUNE	6, 1929
Dec.	4, 1930
FEB.	16, 1933
July	17, 1935
Sept.	18, 1936
Dec.	20, 1937
Sept.	19, 1938
MAY	13, 1940
Nov.	16, 1940
Jan.	31, 1941
Aug.	10, 1942
Jan.	13, 1943
Nov.	21, 1944
Nov.	3, 1955
Jan.	13, 1956
Nov.	16, 1956
April	3, 1957
April	3, 1958
Jan.	28, 1959
Aug.	28, 1959
Dec.	21, 1960
Sept.	14, 1962
Nov.	4, 1964
MAY	27, 1966

MAP REV. MAY 15, 1967
 *FINAL MAP - MINING COMPLETED,
 MINE SEALED AND
 ABANDONED - APRIL, 1968.
 BY OWNER AND MINE INSPECTOR
 IN ACCORD. WITH PA. SPECIFICATIONS
 AND BARRIERS.

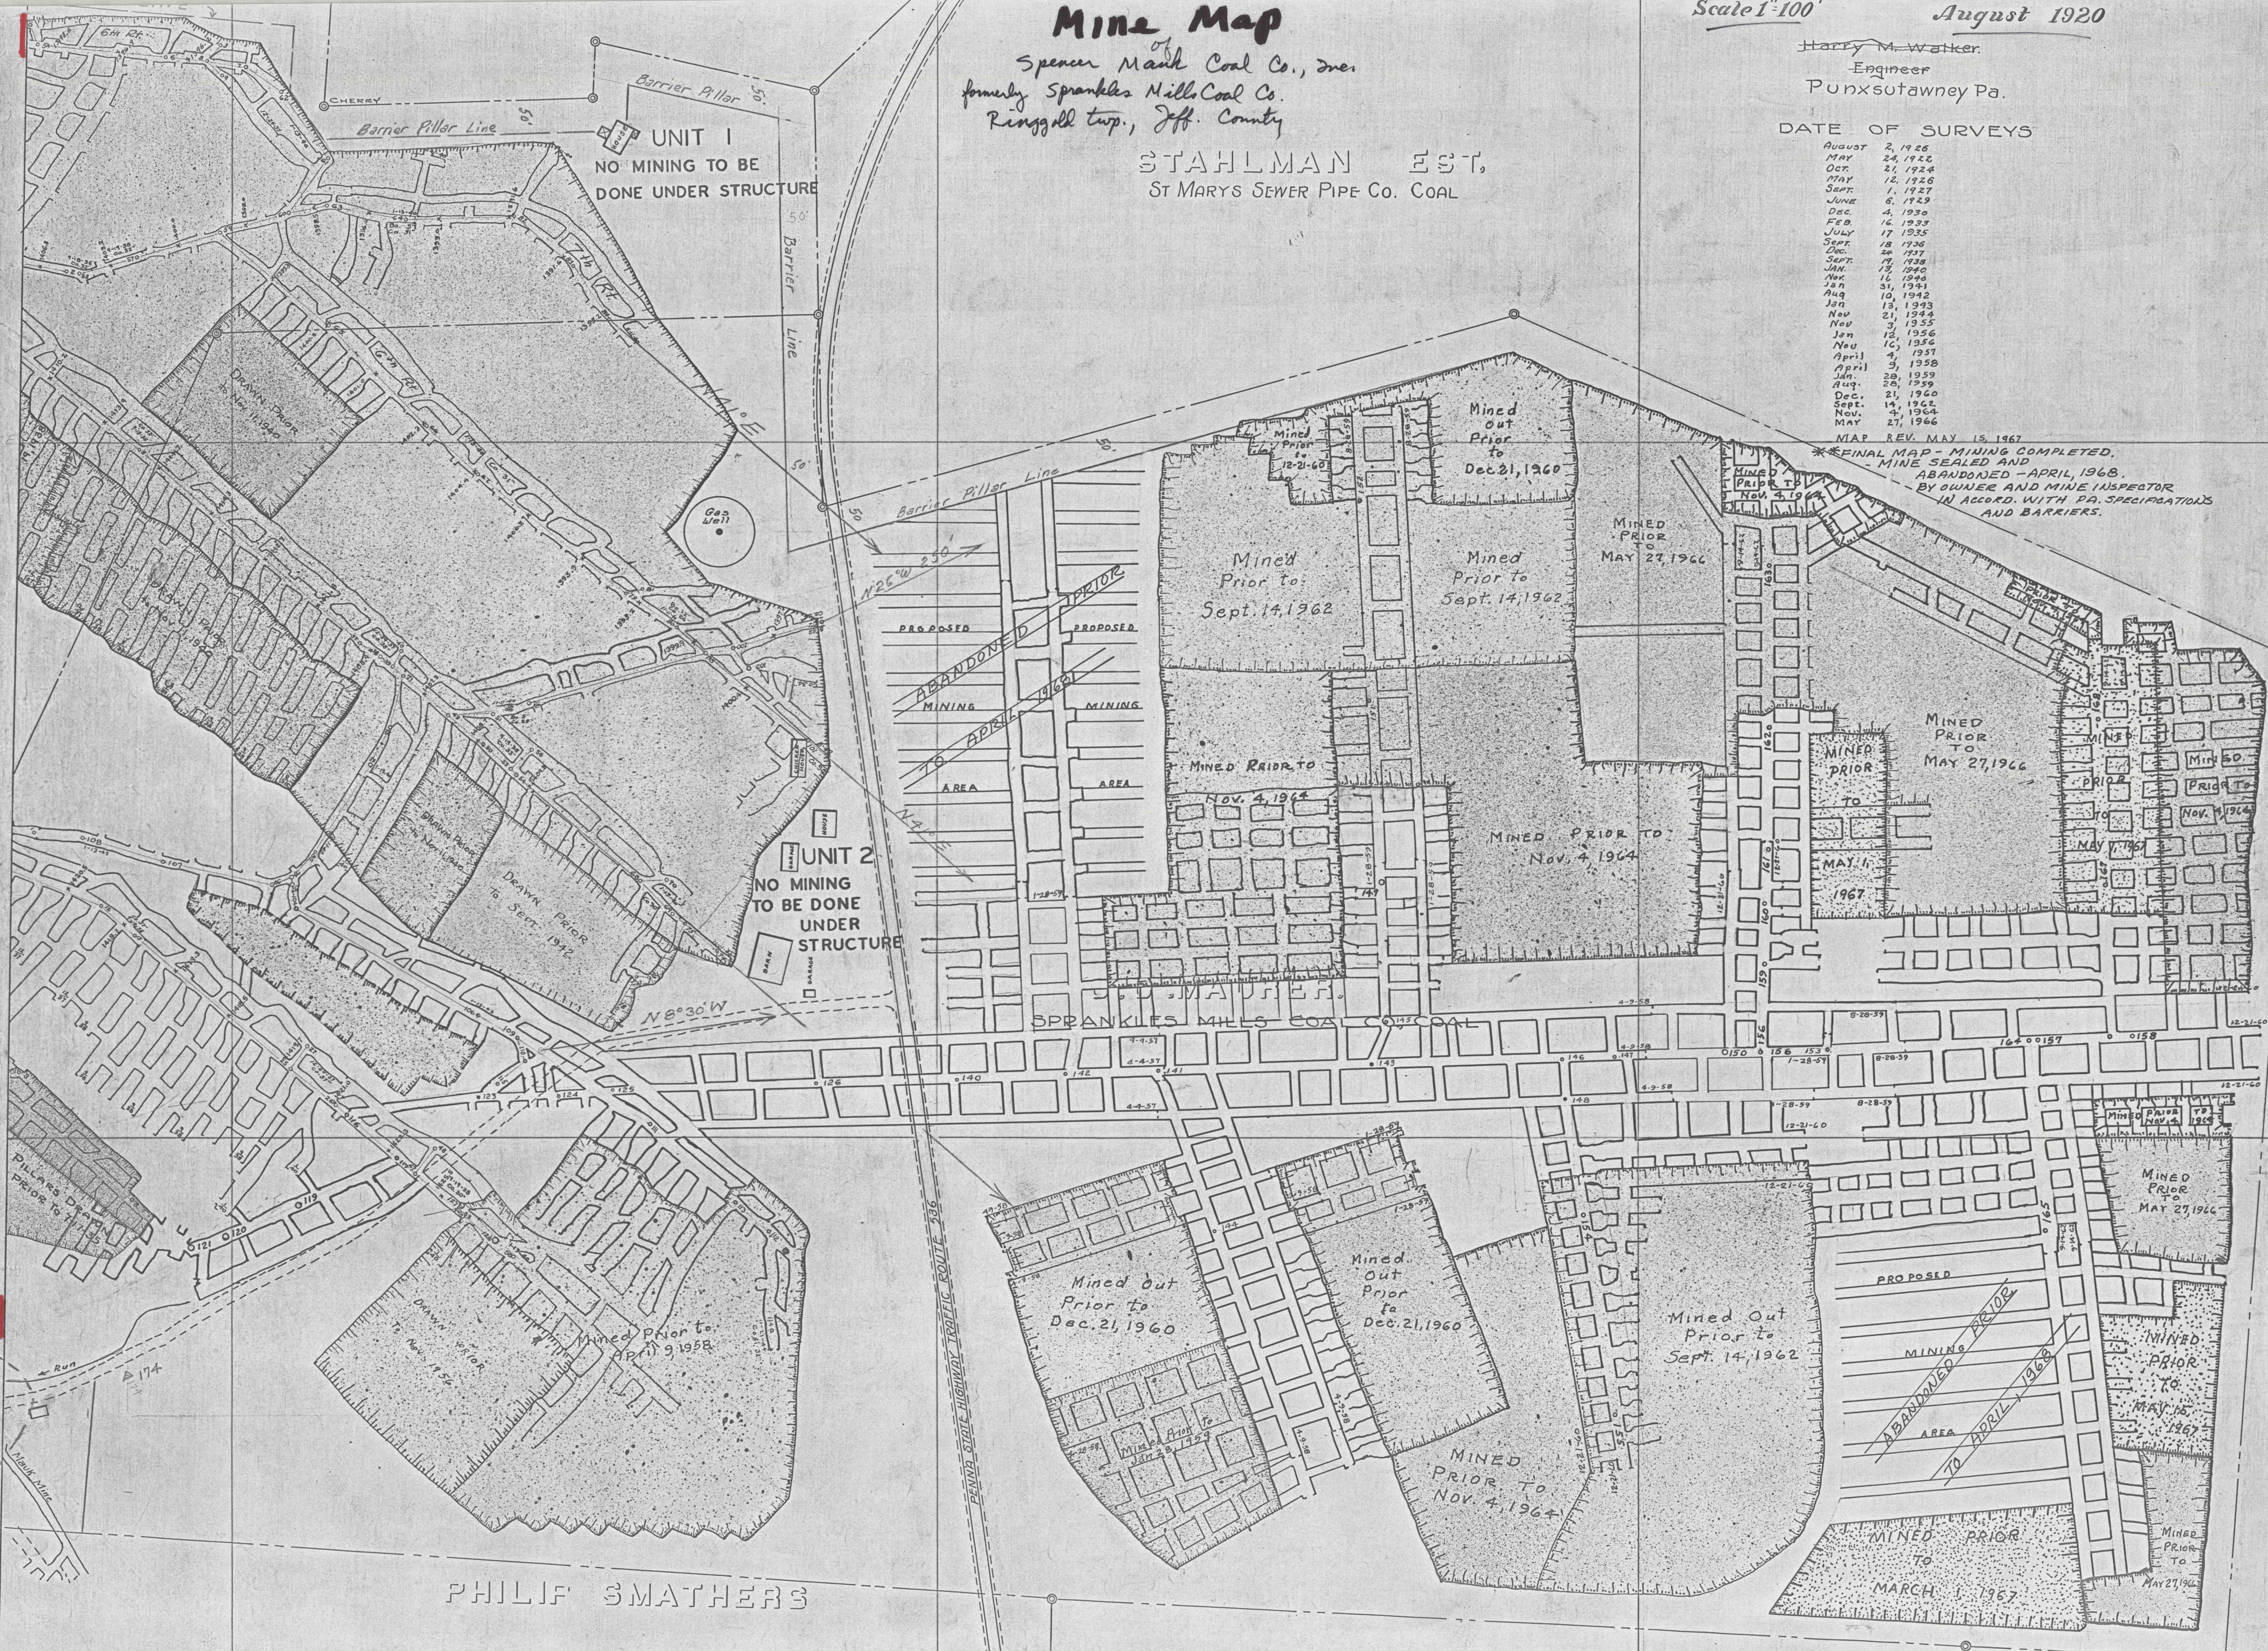

PHILIP SMATHERS

ST. MARYS SEWER PIPE CO. COAL