


8638

M^cGREGOR

LINGENFELTER


BULLERS

FREEDLINE

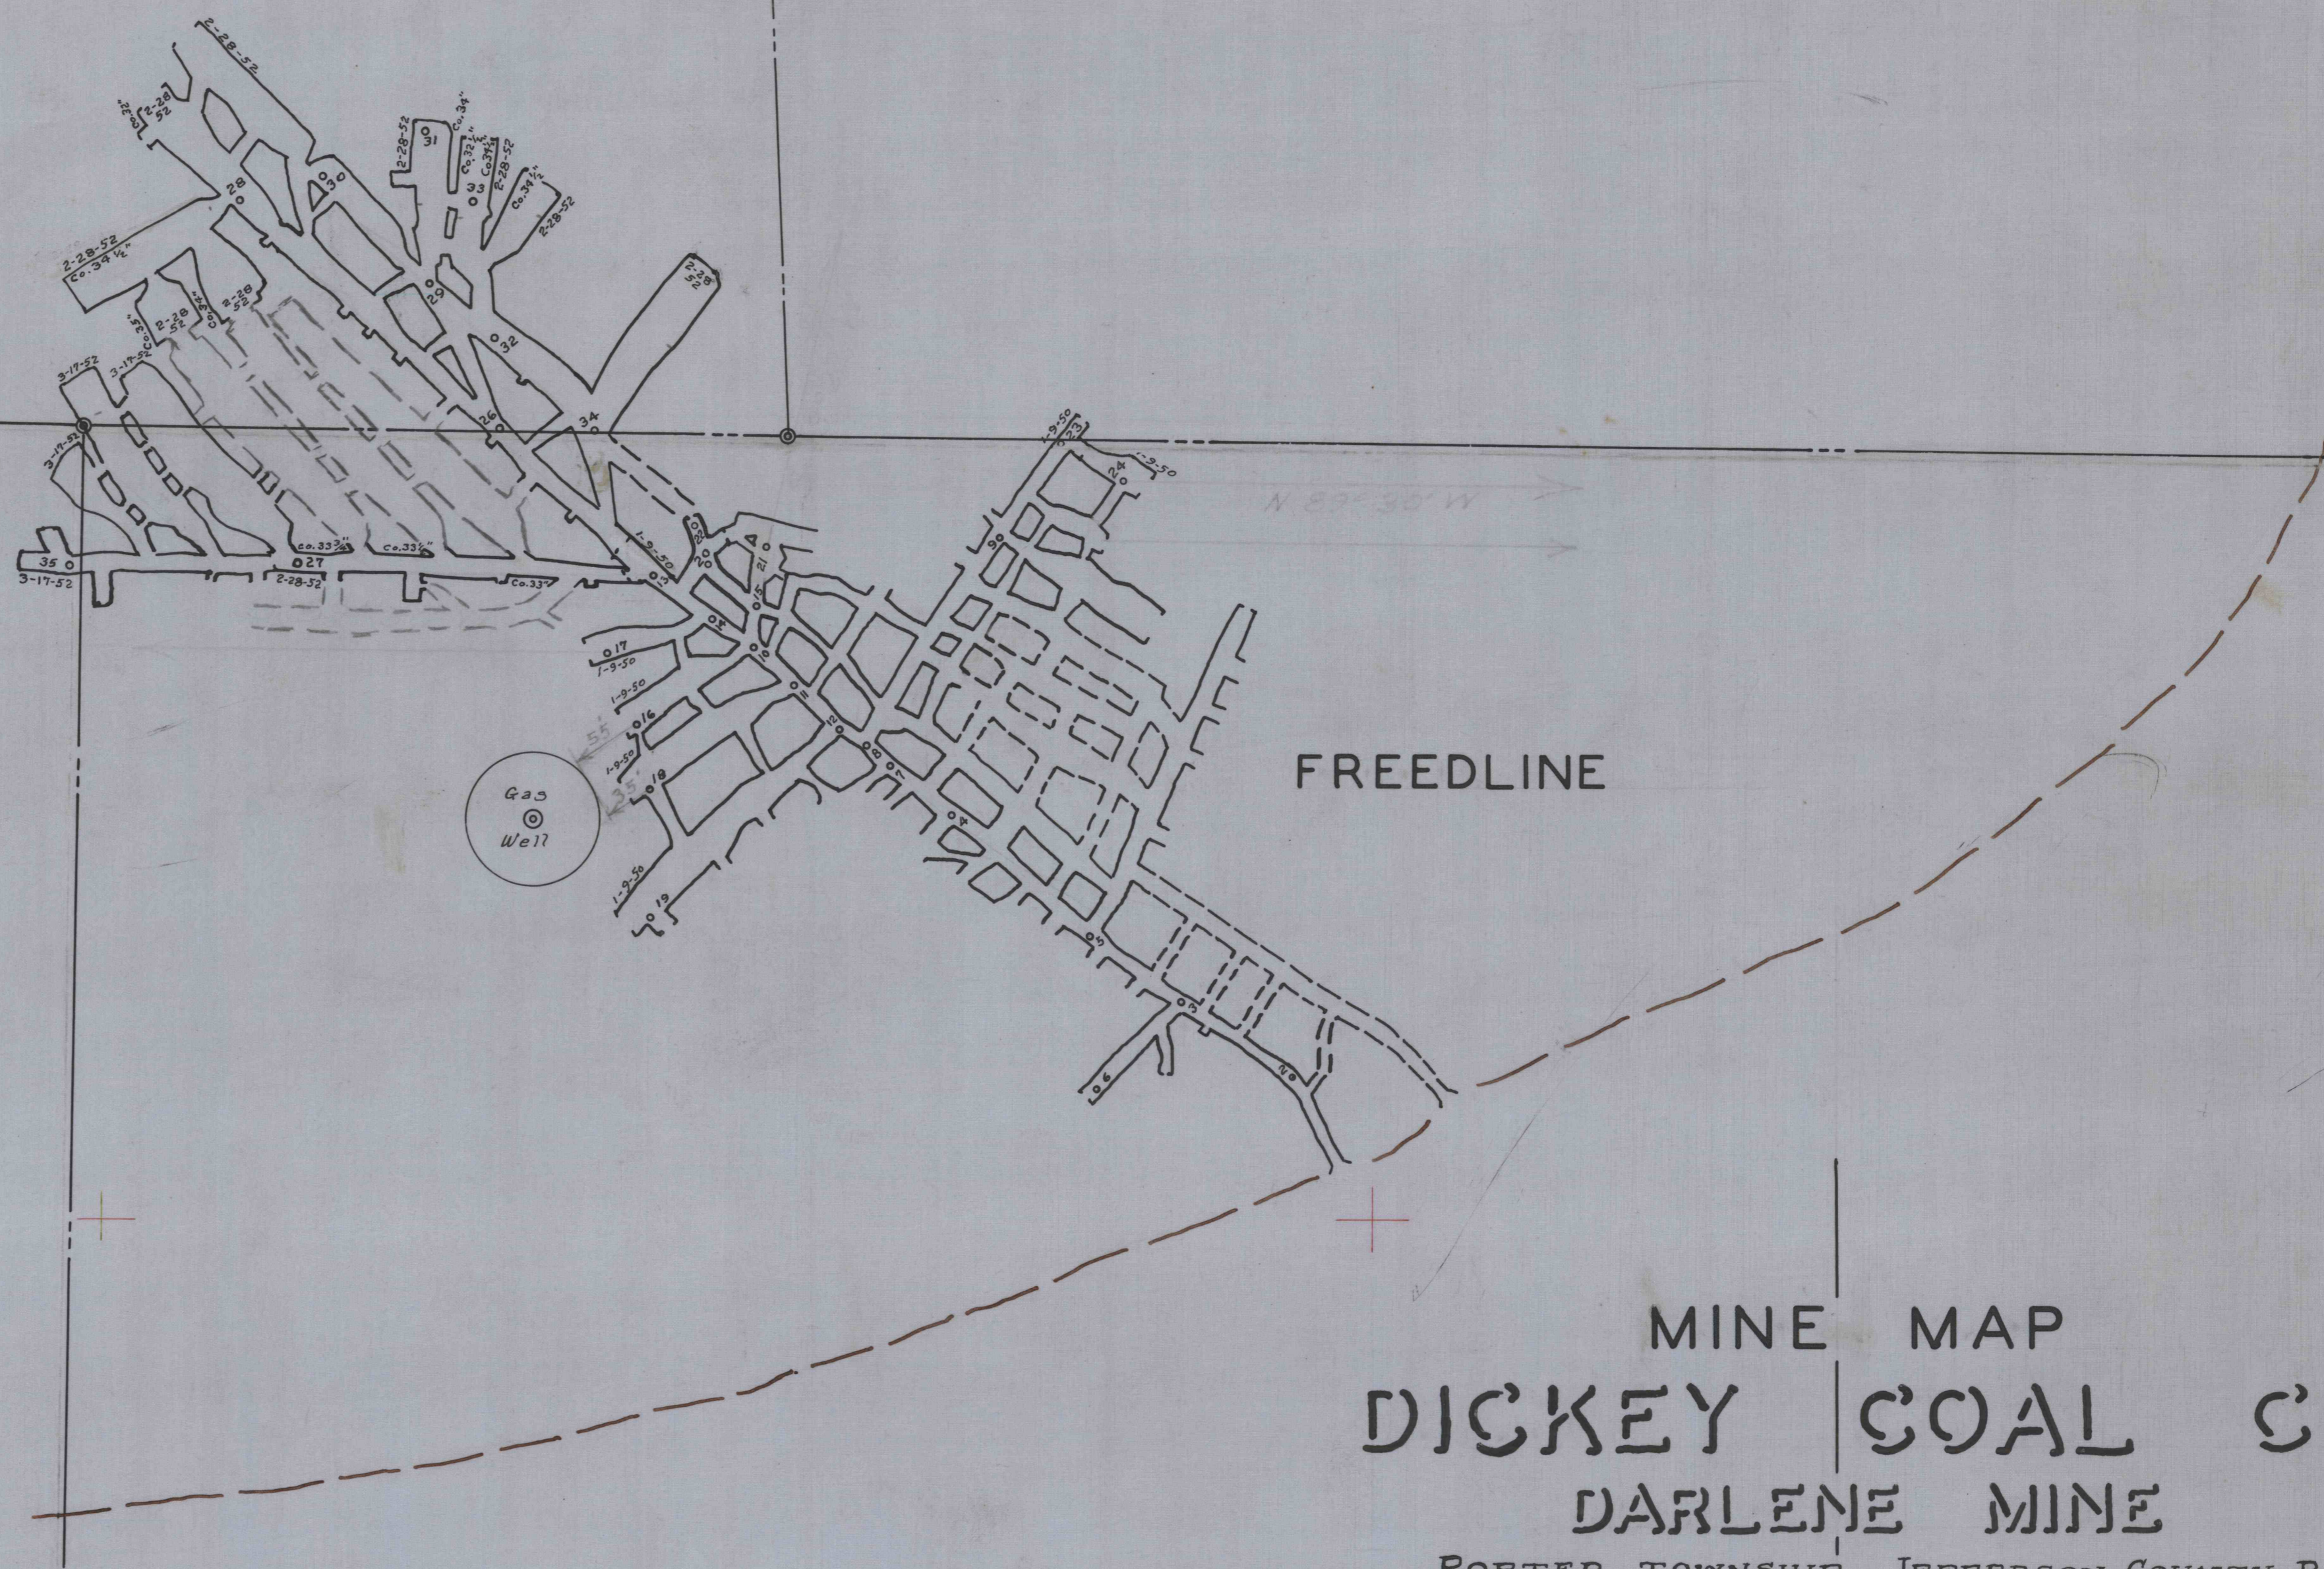

MINE MAP
 DICKEY COAL CO.
 DARLENE MINE

PORTER TOWNSHIP, JEFFERSON COUNTY, PA.
 Scale 1"=100' January, 1950.
 Walter J. Zimmerman Engineer-Surveyor, Pottsville, Pa.

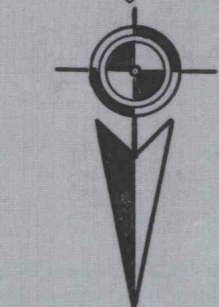

8638

11

