



DICKEY

J. G. ANDERSON

C. R. CORBETT

A. S. BAUGHMAN

CARRIER

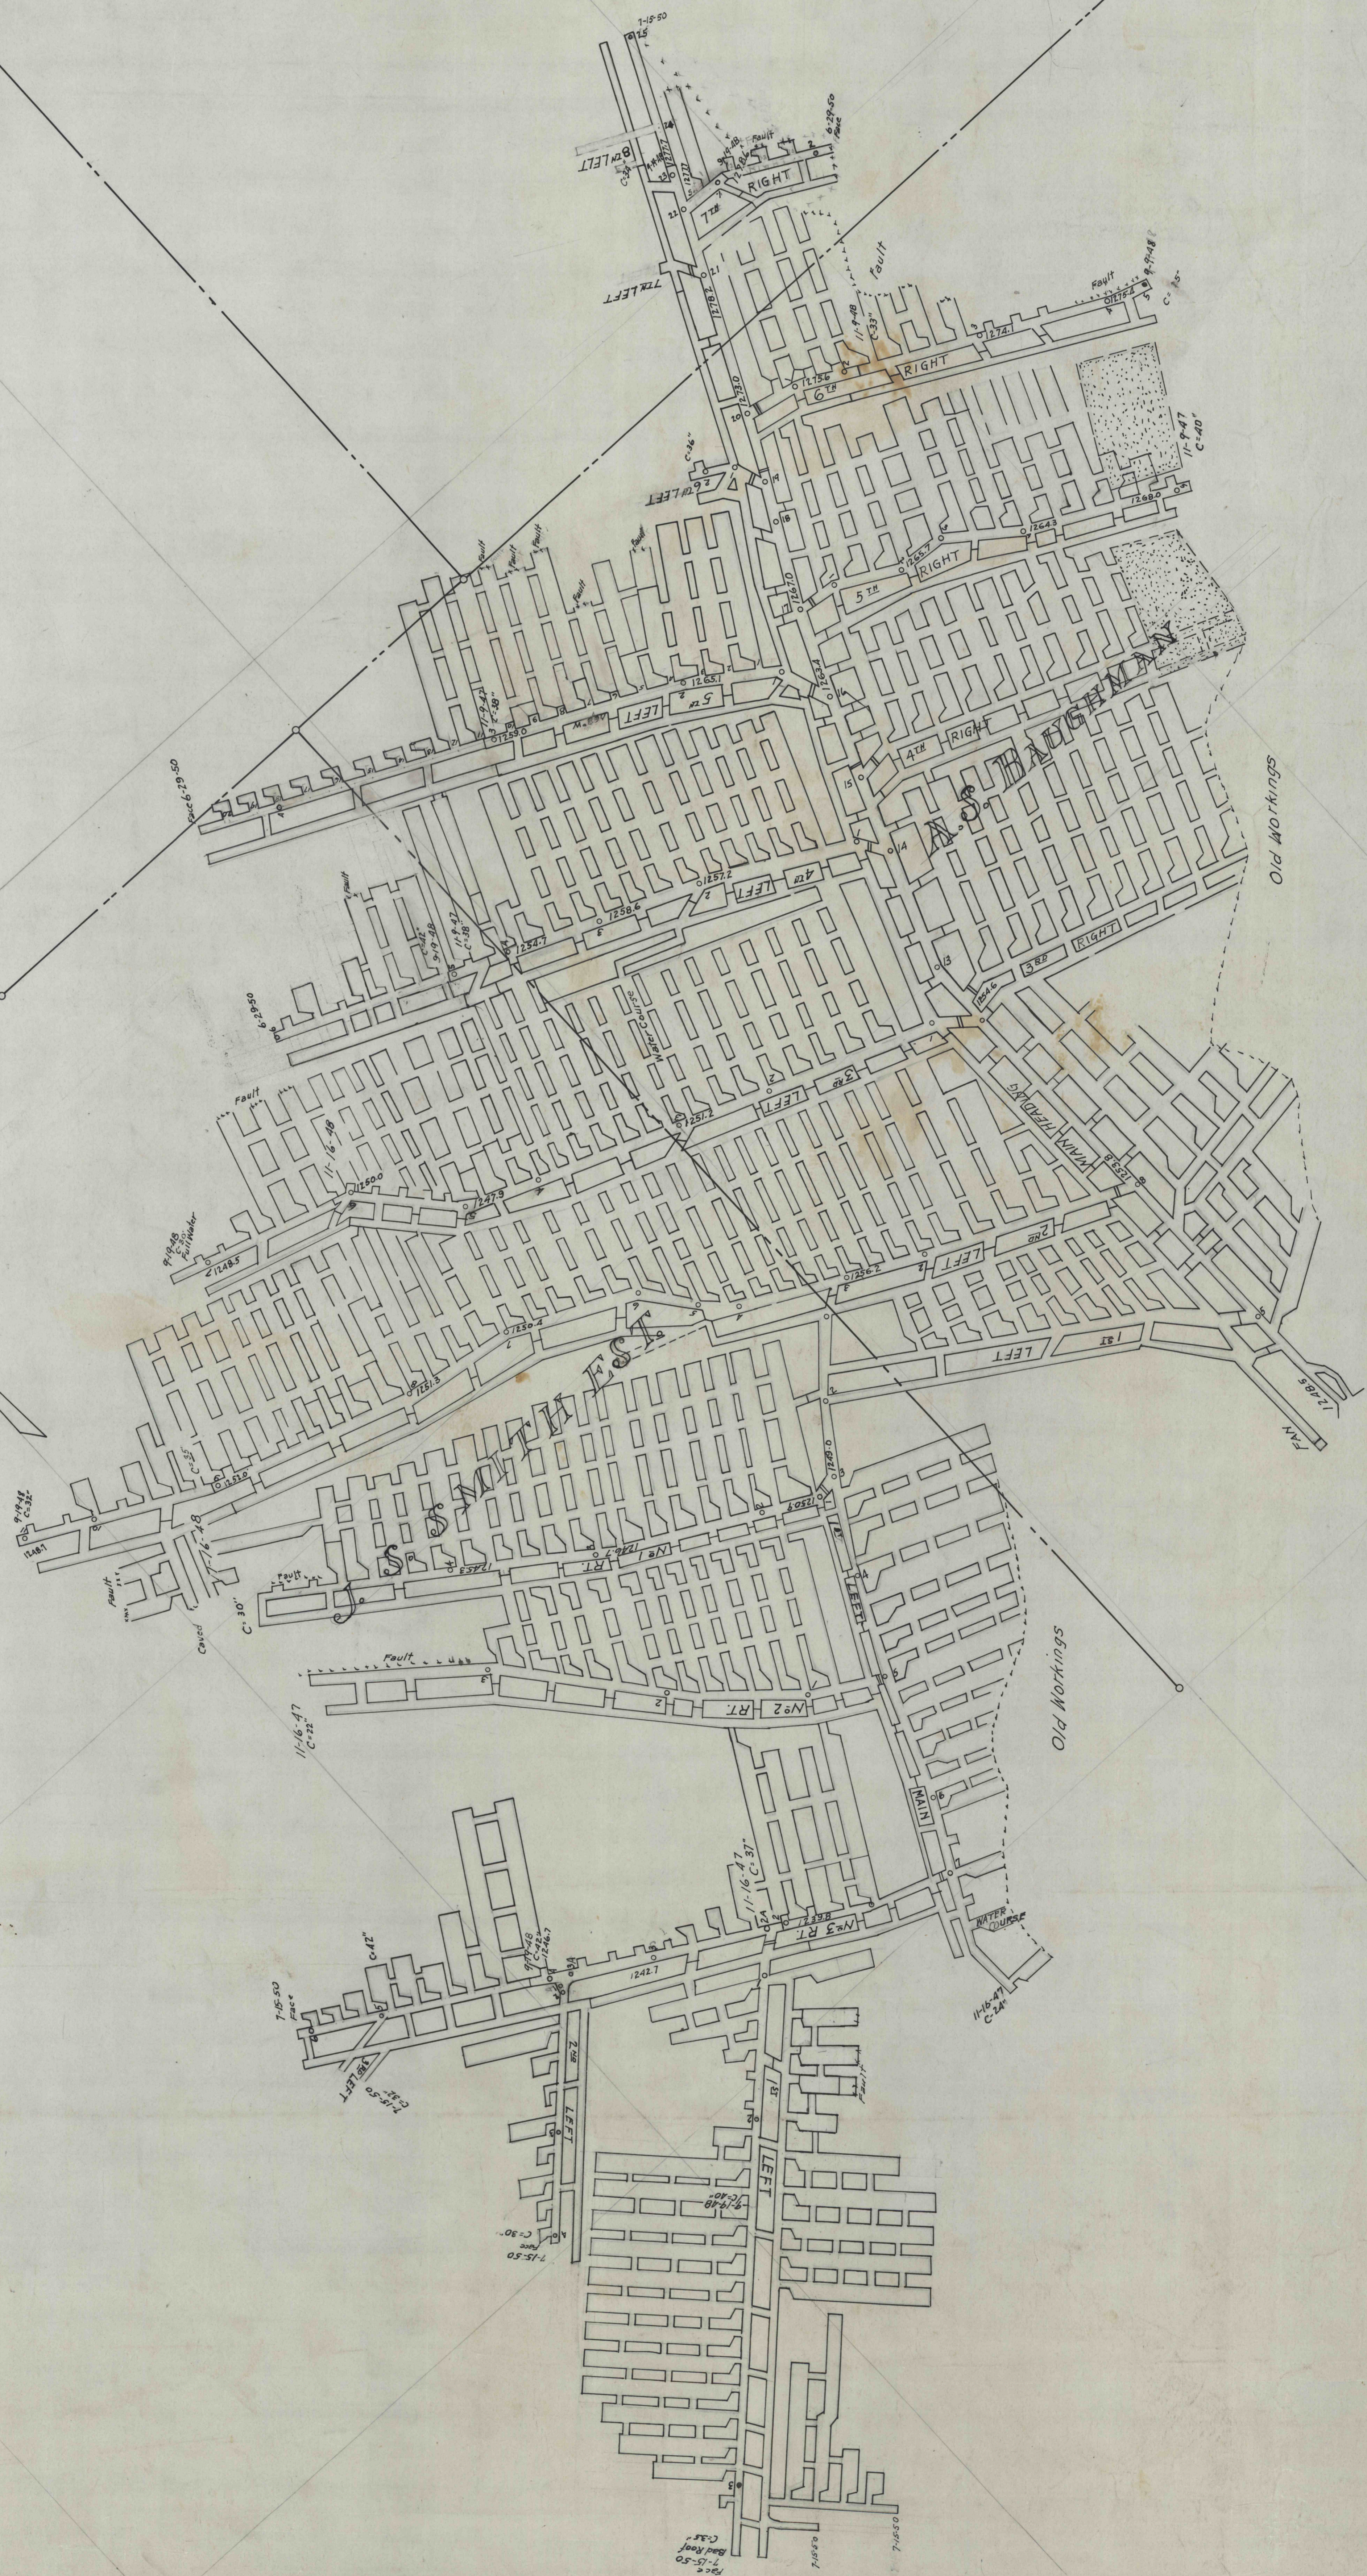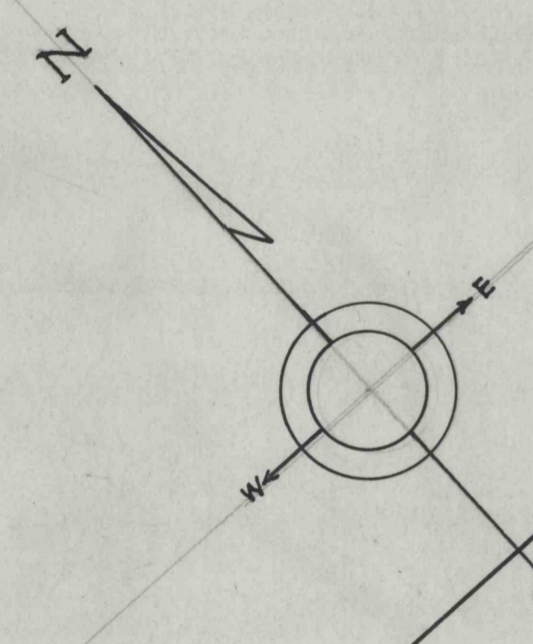

CREEKSIDE MINING CO.

Clover Township Jefferson County, Pa.

Scale: 1"=100' CORSICA QUAD

7-15-50 Est.

BROOKVILLE COAL

Jno. C. Kather PE.  
Phone Fredonia 3065