


STAHLMAN ESTATE
ST. MARYS SEWER PIPE CO. Surface Coal

J. C. MAURER
SPRANKLES MILLS COAL CO. Surface Coal

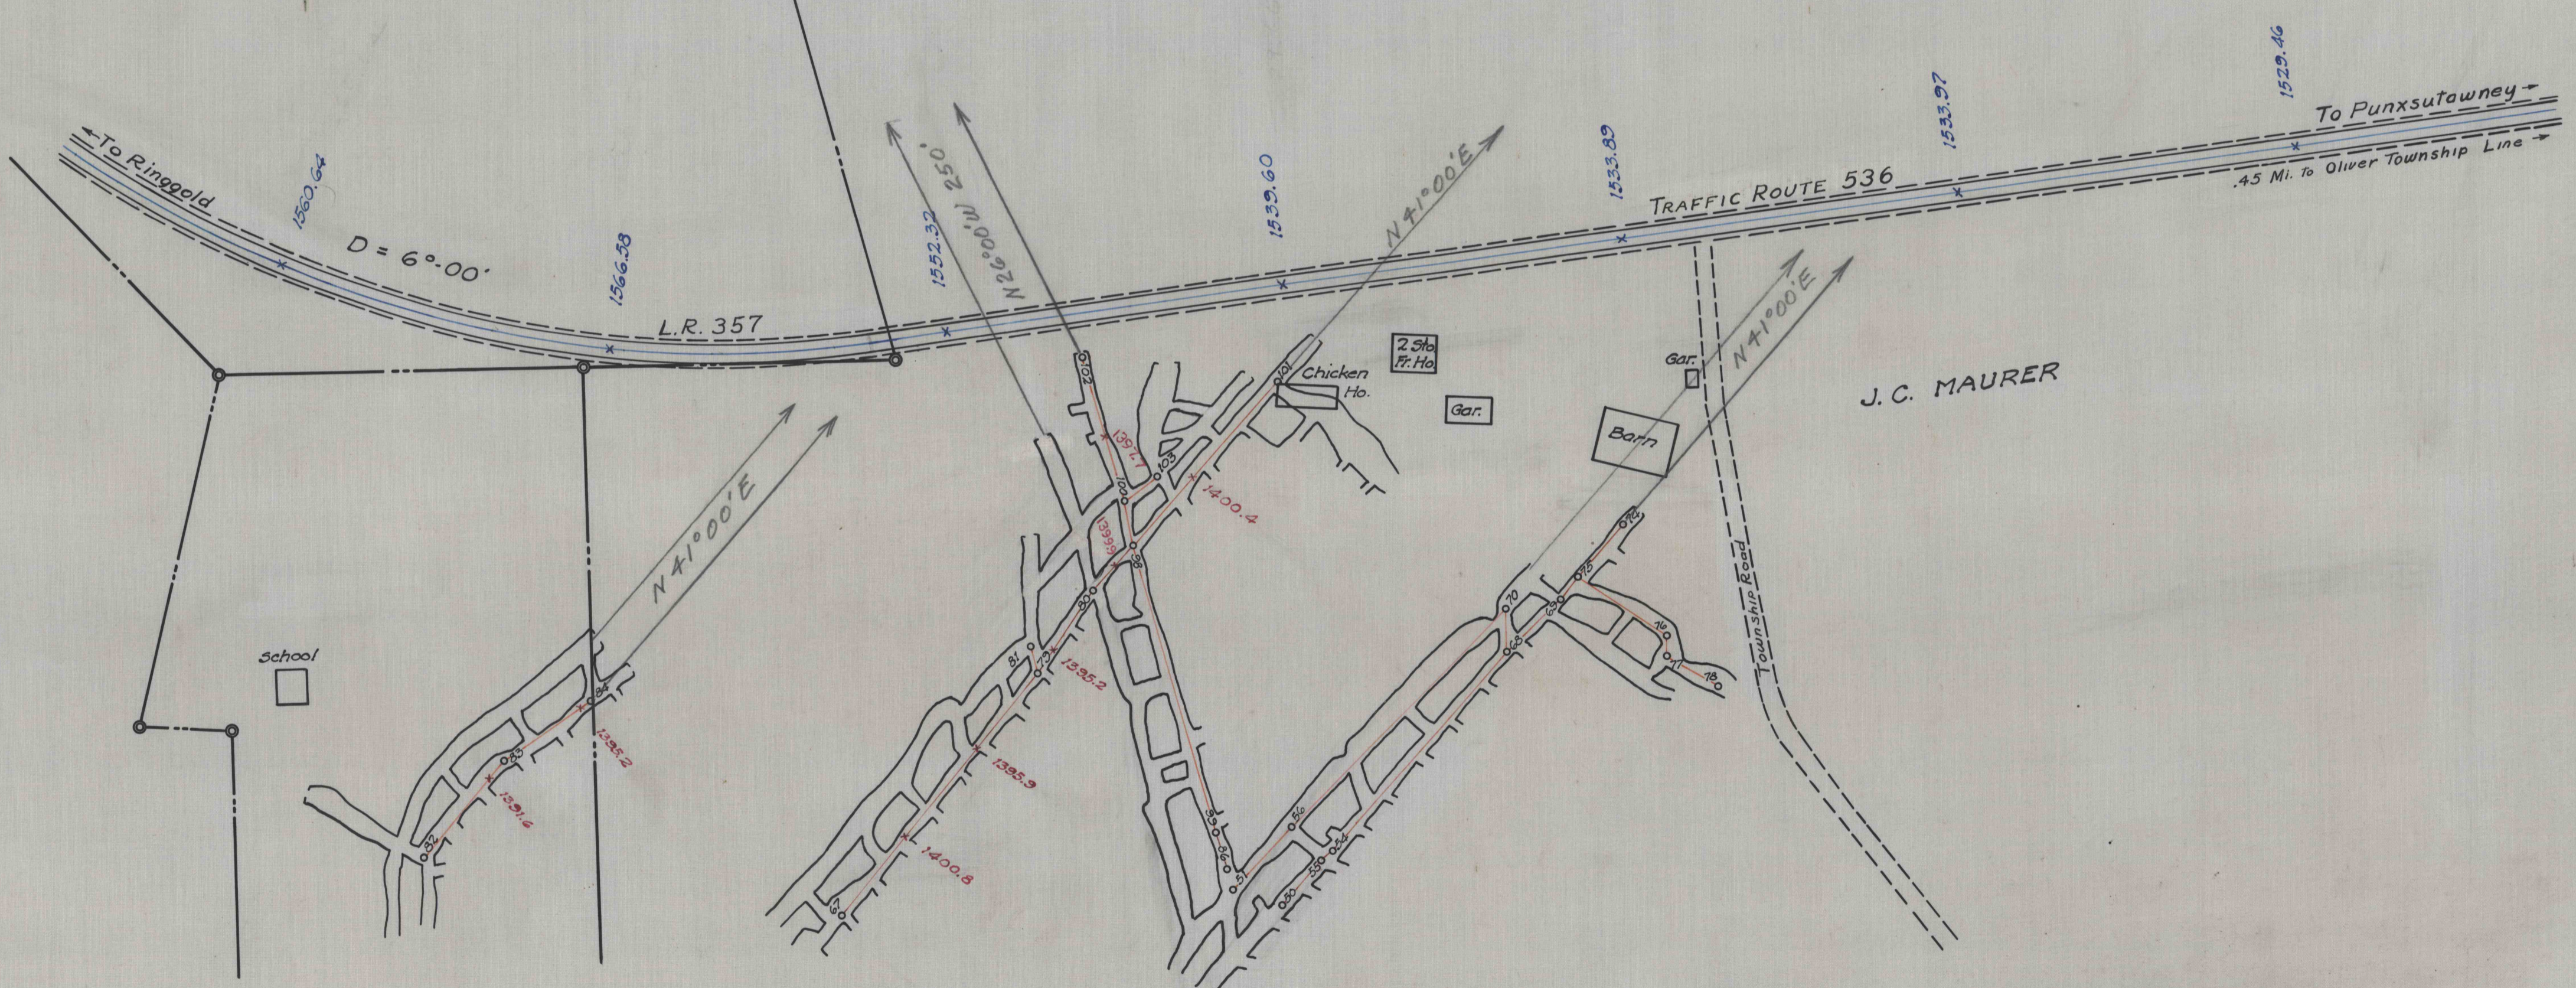

MAP OF
SPRANKLES MILLS COAL CO.
MINE WORKINGS ADJACENT TO L.R. 357
RINGGOLD TWP. JEFFERSON CO., PA.
SCALE 1"=100' SEPTEMBER, 1942
WALTER J. ZIMMERMAN, SURVEYOR,
PUNXSUTAWNEY, PA.