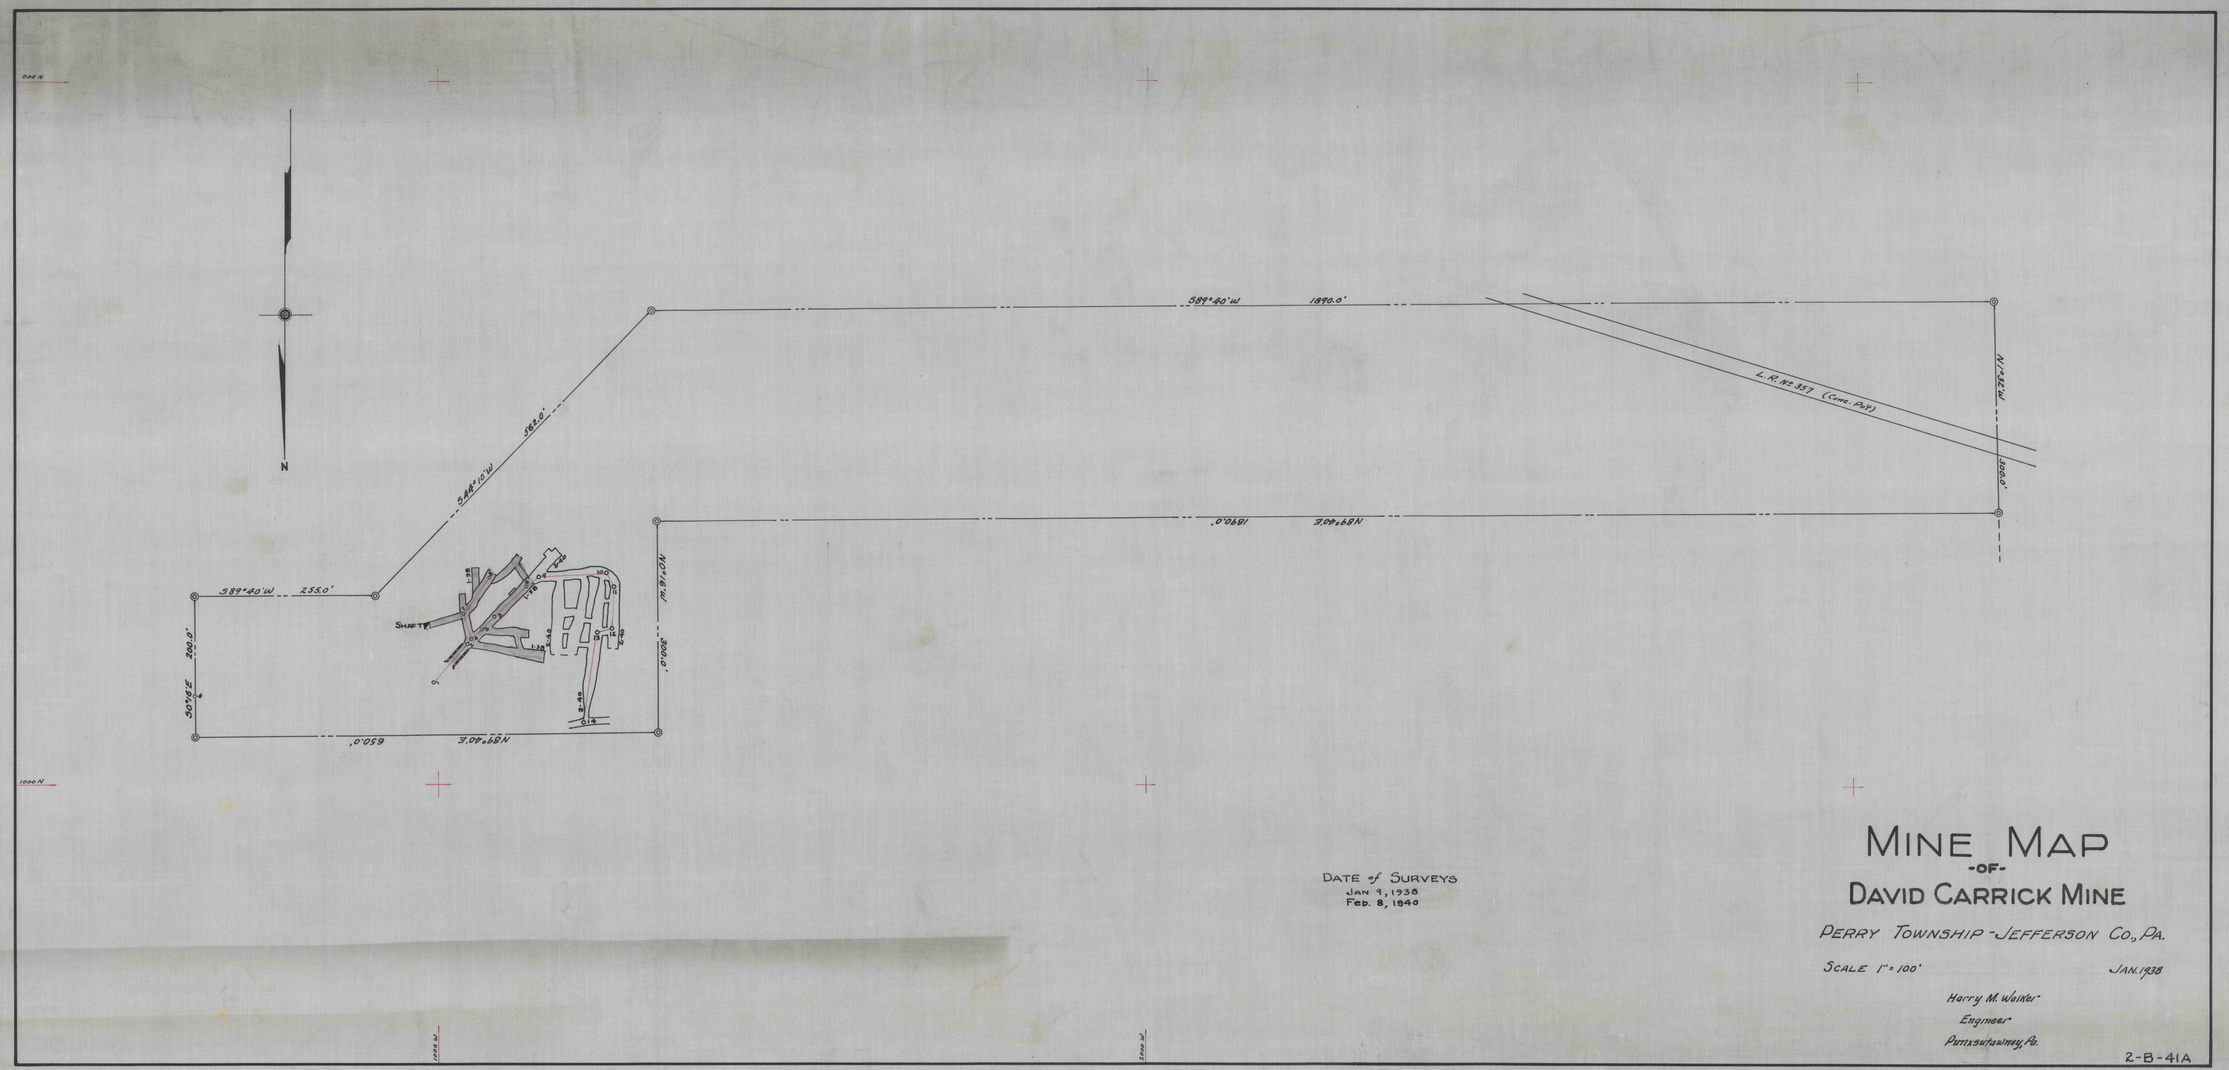

DATE of SURVEYS
JAN 9, 1938
FEB. 8, 1940

MINE MAP
-OF-
DAVID CARRICK MINE

PERRY TOWNSHIP - JEFFERSON CO., PA.

SCALE 1" = 100'

JAN. 1938

Harry M. Walker
Engineer
Punxsutawney, Pa.

2-B-41A

Notes: Mod. No. 20
Drawing: 2-B-41
Tracing: 2-B-41A
Traverse: L.L.TR. No. 1