
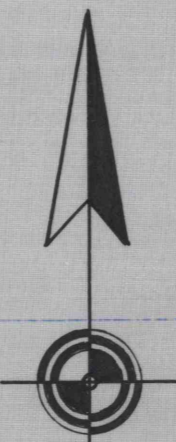
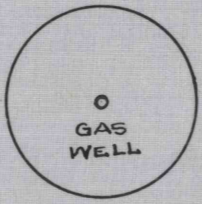


TWP. ROAD

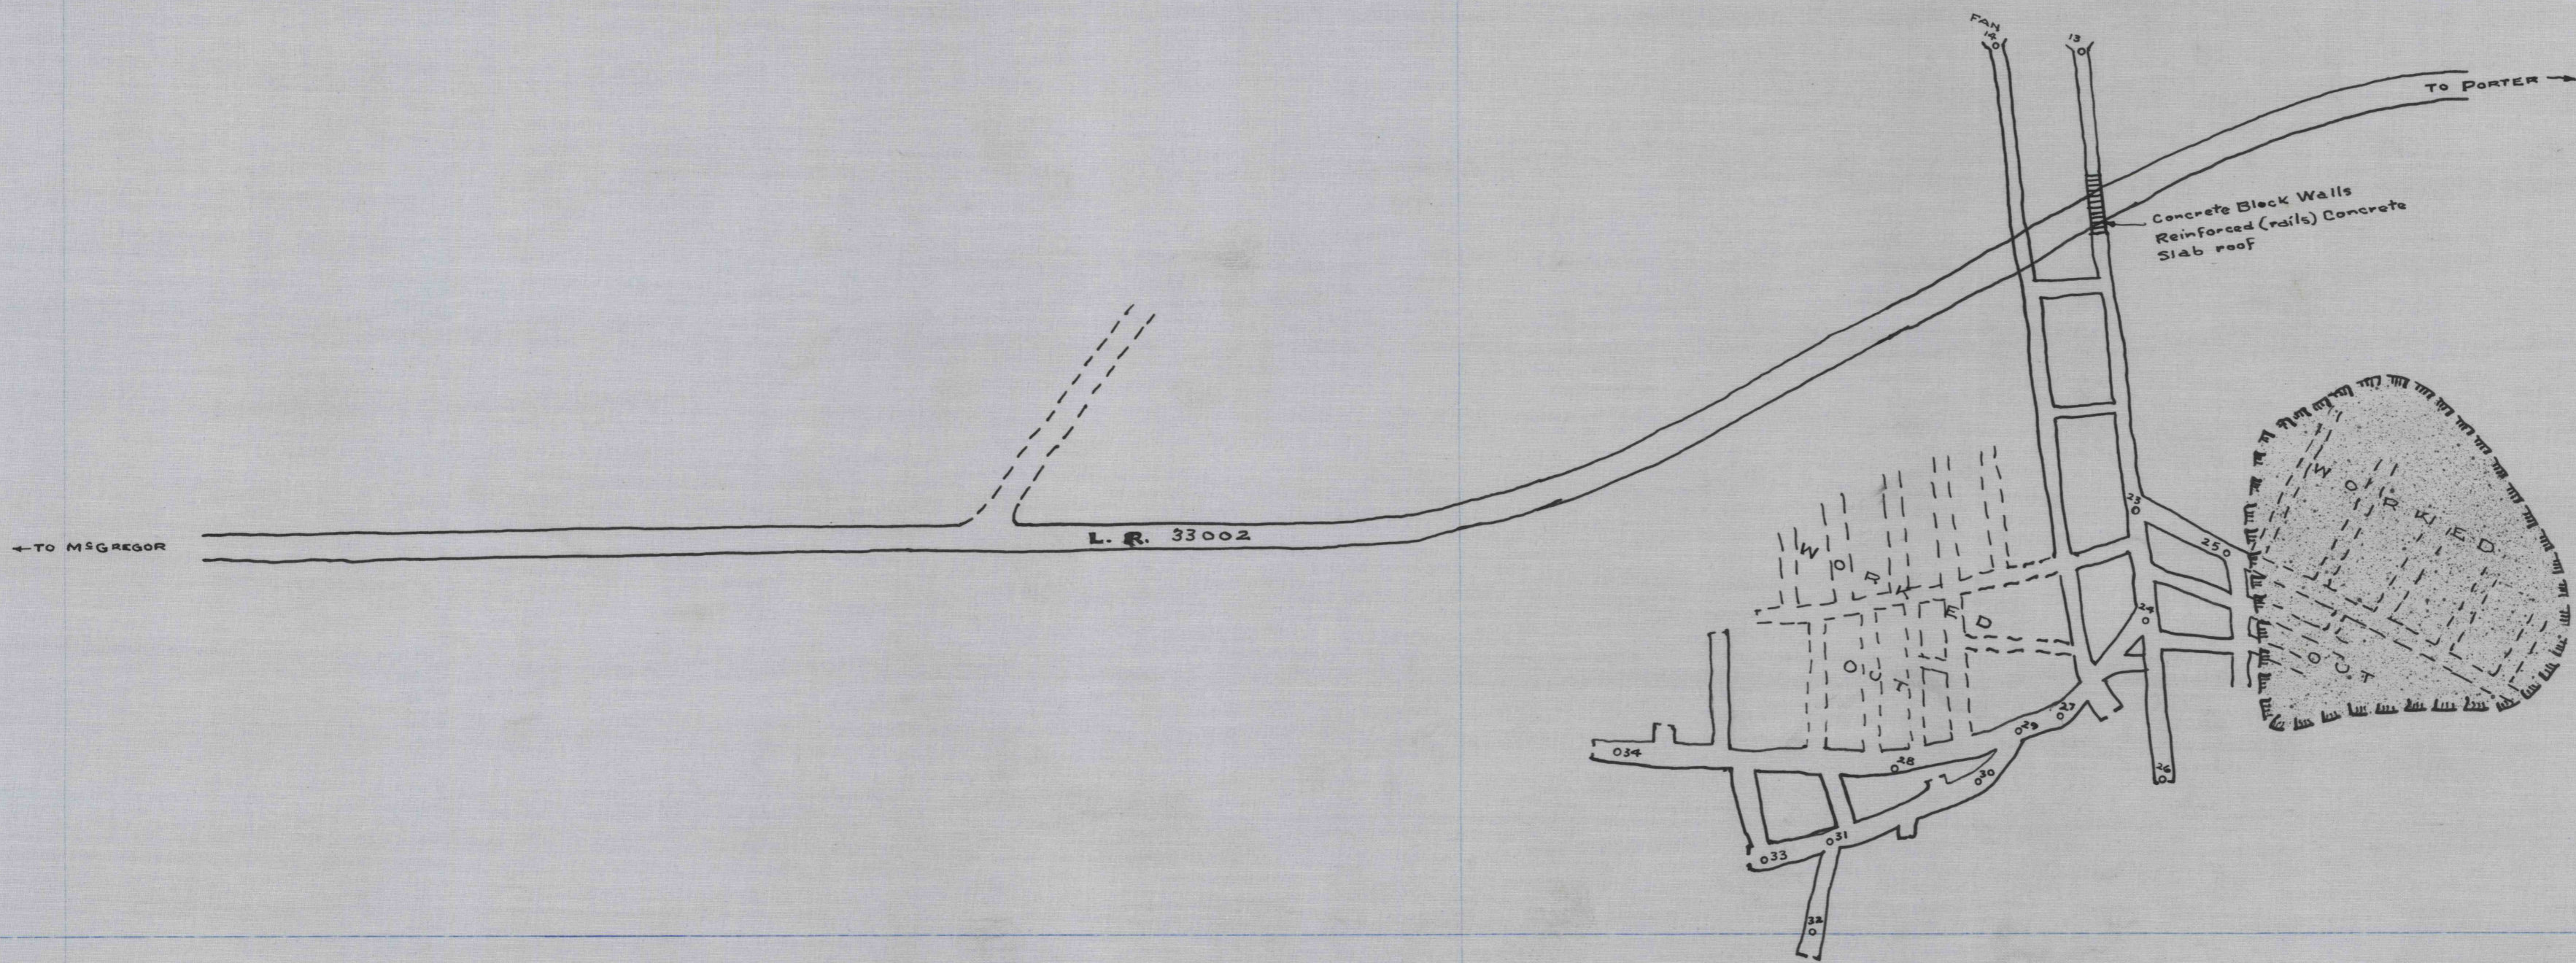

MINE MAP
LELAND C. SHORTS
WINDY HILL MINE
 PORTER TOWNSHIP JEFFERSON COUNTY PENNA.
 Scale 1"=100' August 1948
 Walter J. Zimmerman Surveyor Punxsutawney, Pa.

JEFF-75
 Porter Twp, Jeff. County
 Leland C. Shorts
 Windy Hill Mine