

127


6000.0E

5000.0E

4000.0E

3000.0S

4000.0S

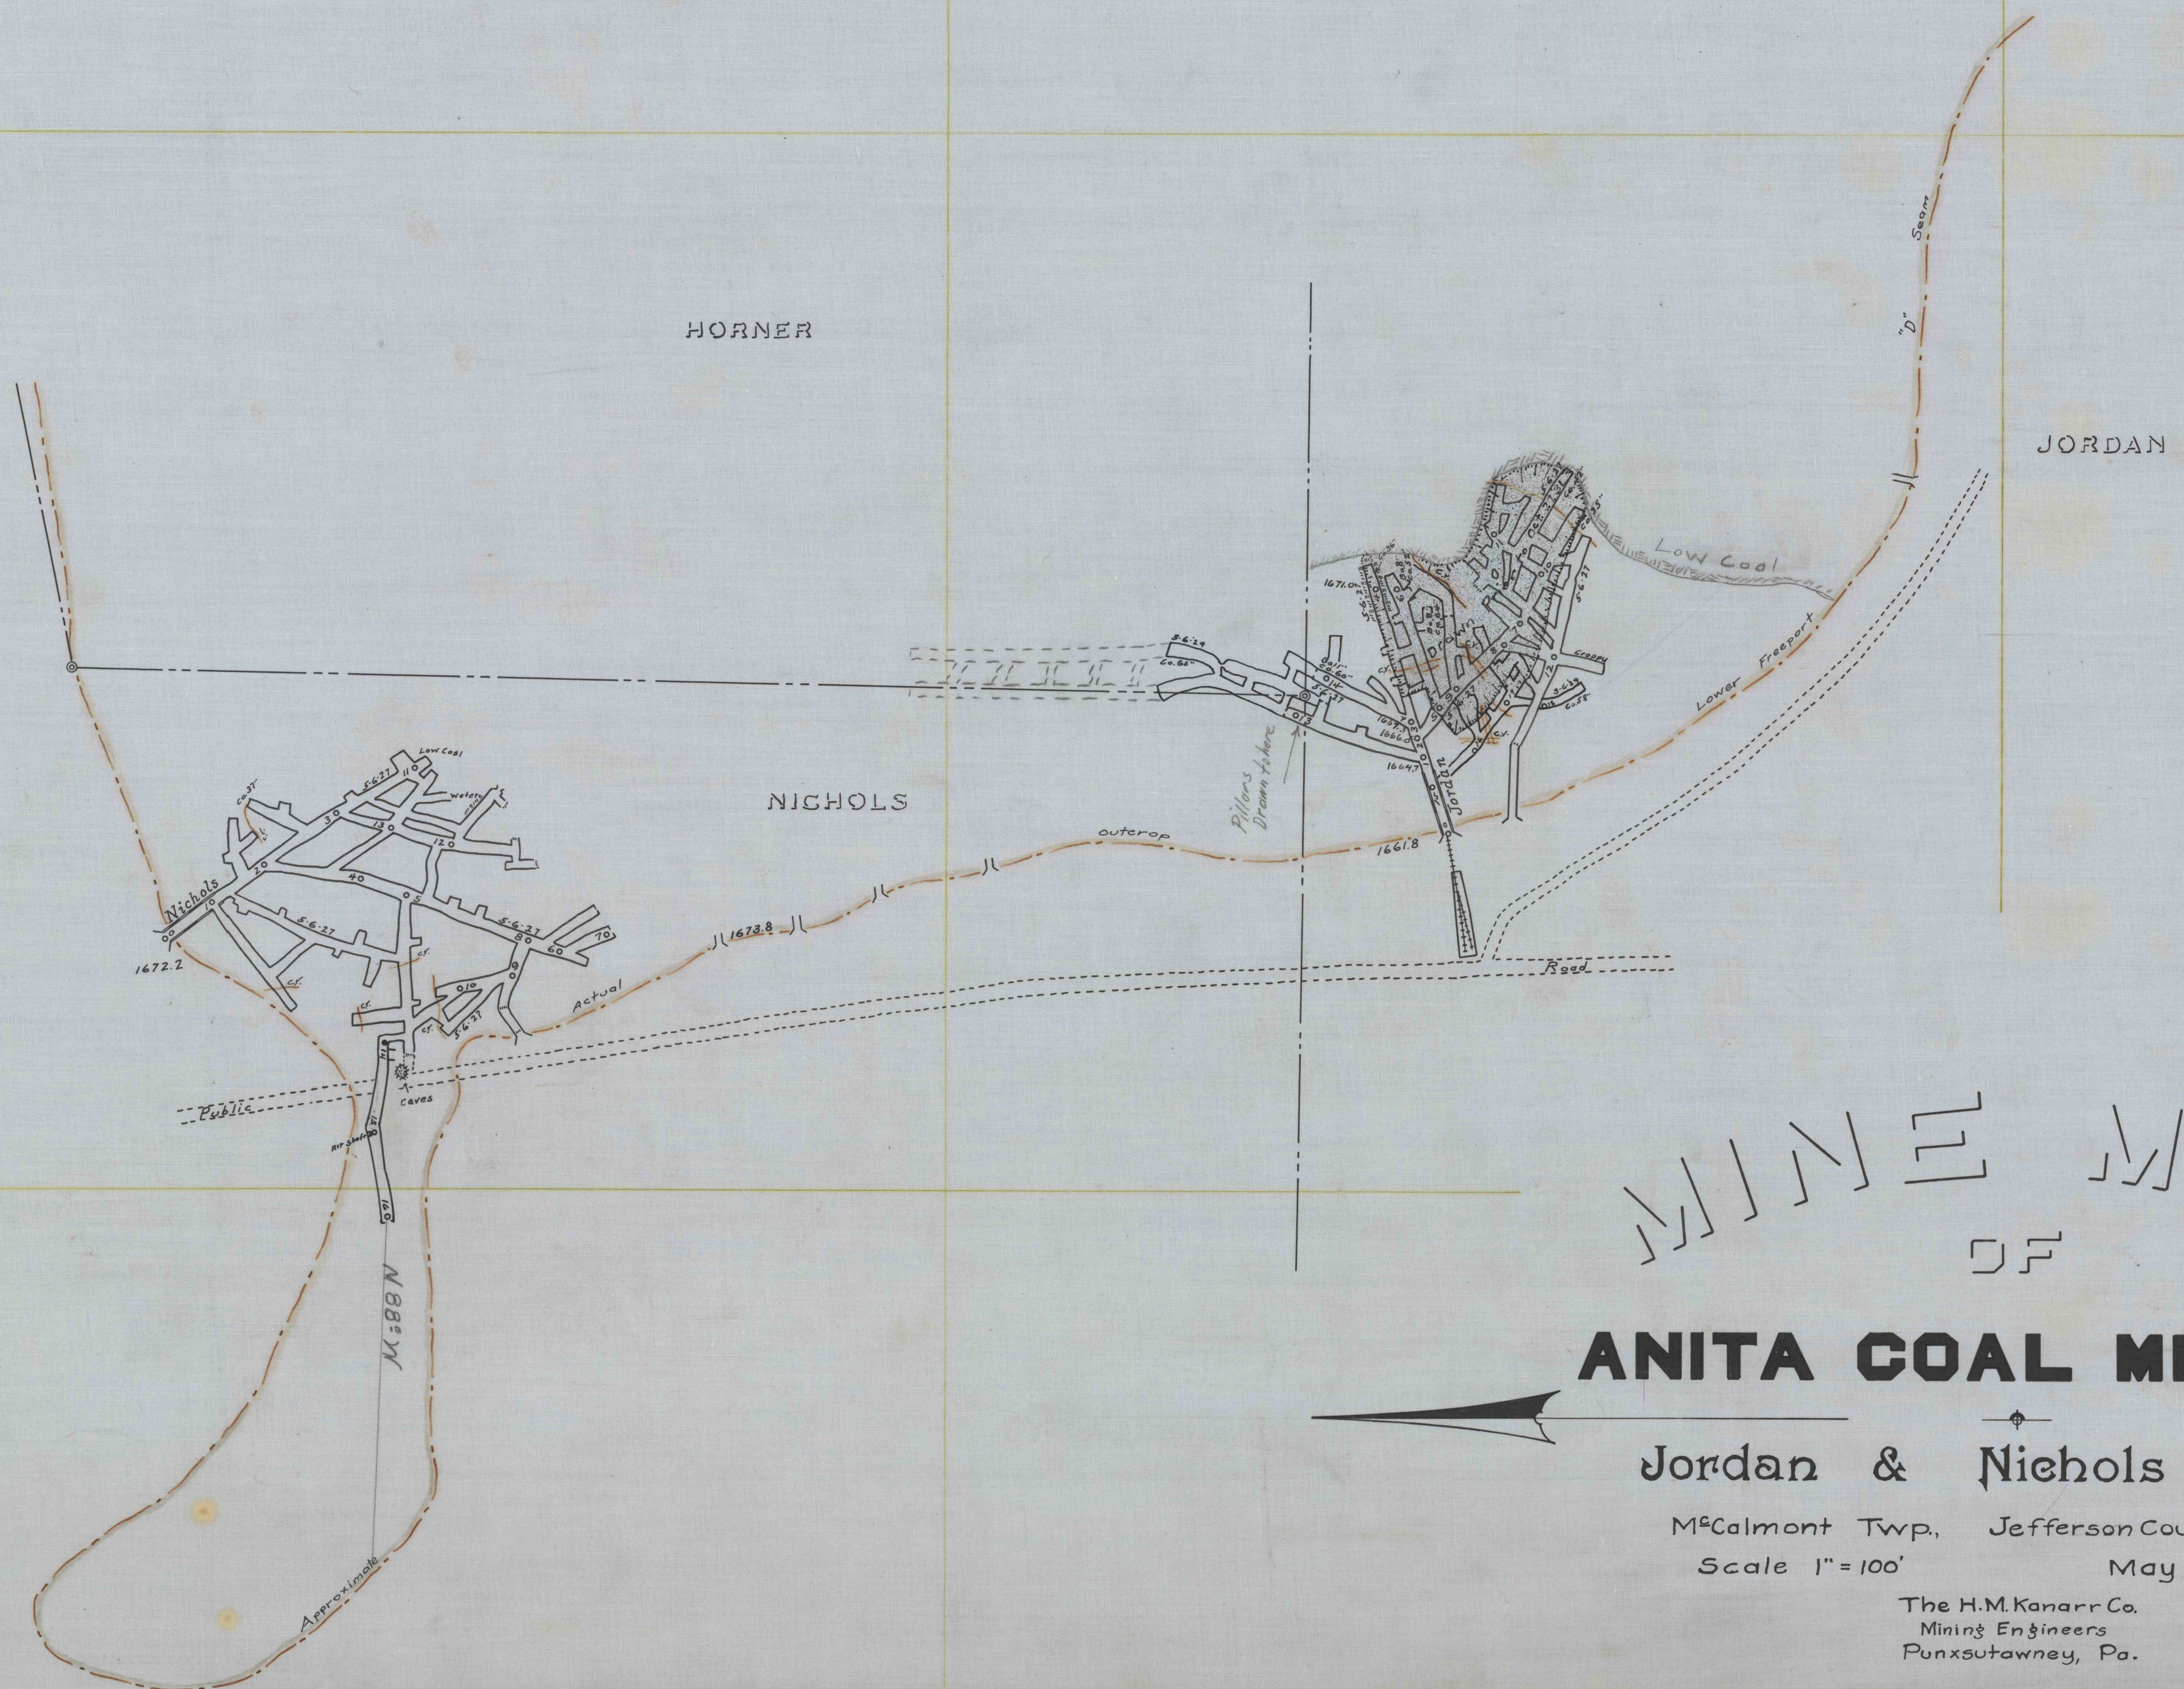

# MINE MAP

OF

## ANITA COAL MNG. CO.

Jordan & Nichols Mines

McCalmont Twp. Jefferson County, Pa.

Scale 1" = 100' May 18, 1927

The H.M. Kanarr Co.  
Mining Engineers  
Punxsutawney, Pa.

*Handwritten notes:*  
Anita Coal Mine, Pa.  
Nichols & Jordan Mines  
McCalmont Twp. Jefferson County, Pa.

366-11