


MINE MAP

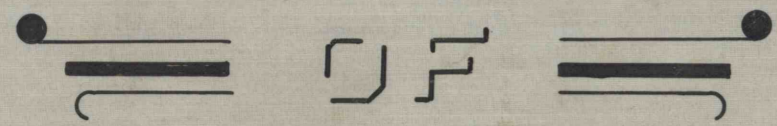

WILLIAMS RUN COAL CO.


NO. 78 MINES

Perry Twp Jefferson Co., Pa.
Scale 1"=100' August 1925

The H.M. Kanarr Co.
Mining Engineers
Pennsylvaniay, Pa.

SURVEYS-
July 24, 1925
Sept. 8, 1926
July 25, 1927
June 23, 1928
Jan. 14, 1933
Jan. 9, 1935

NOTE:
Tinted area from actual Survey
Nontinted area Compiled from other maps

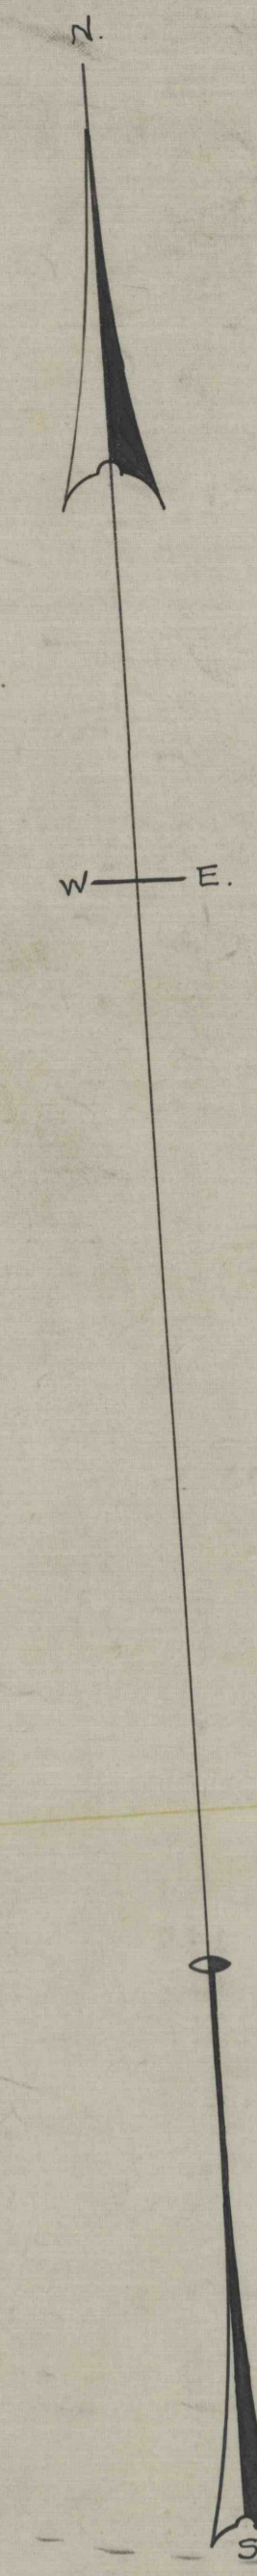

WALSTON No. 4
WORKINGS
(KLONDIKE)

WARD PALMER