1-A-112

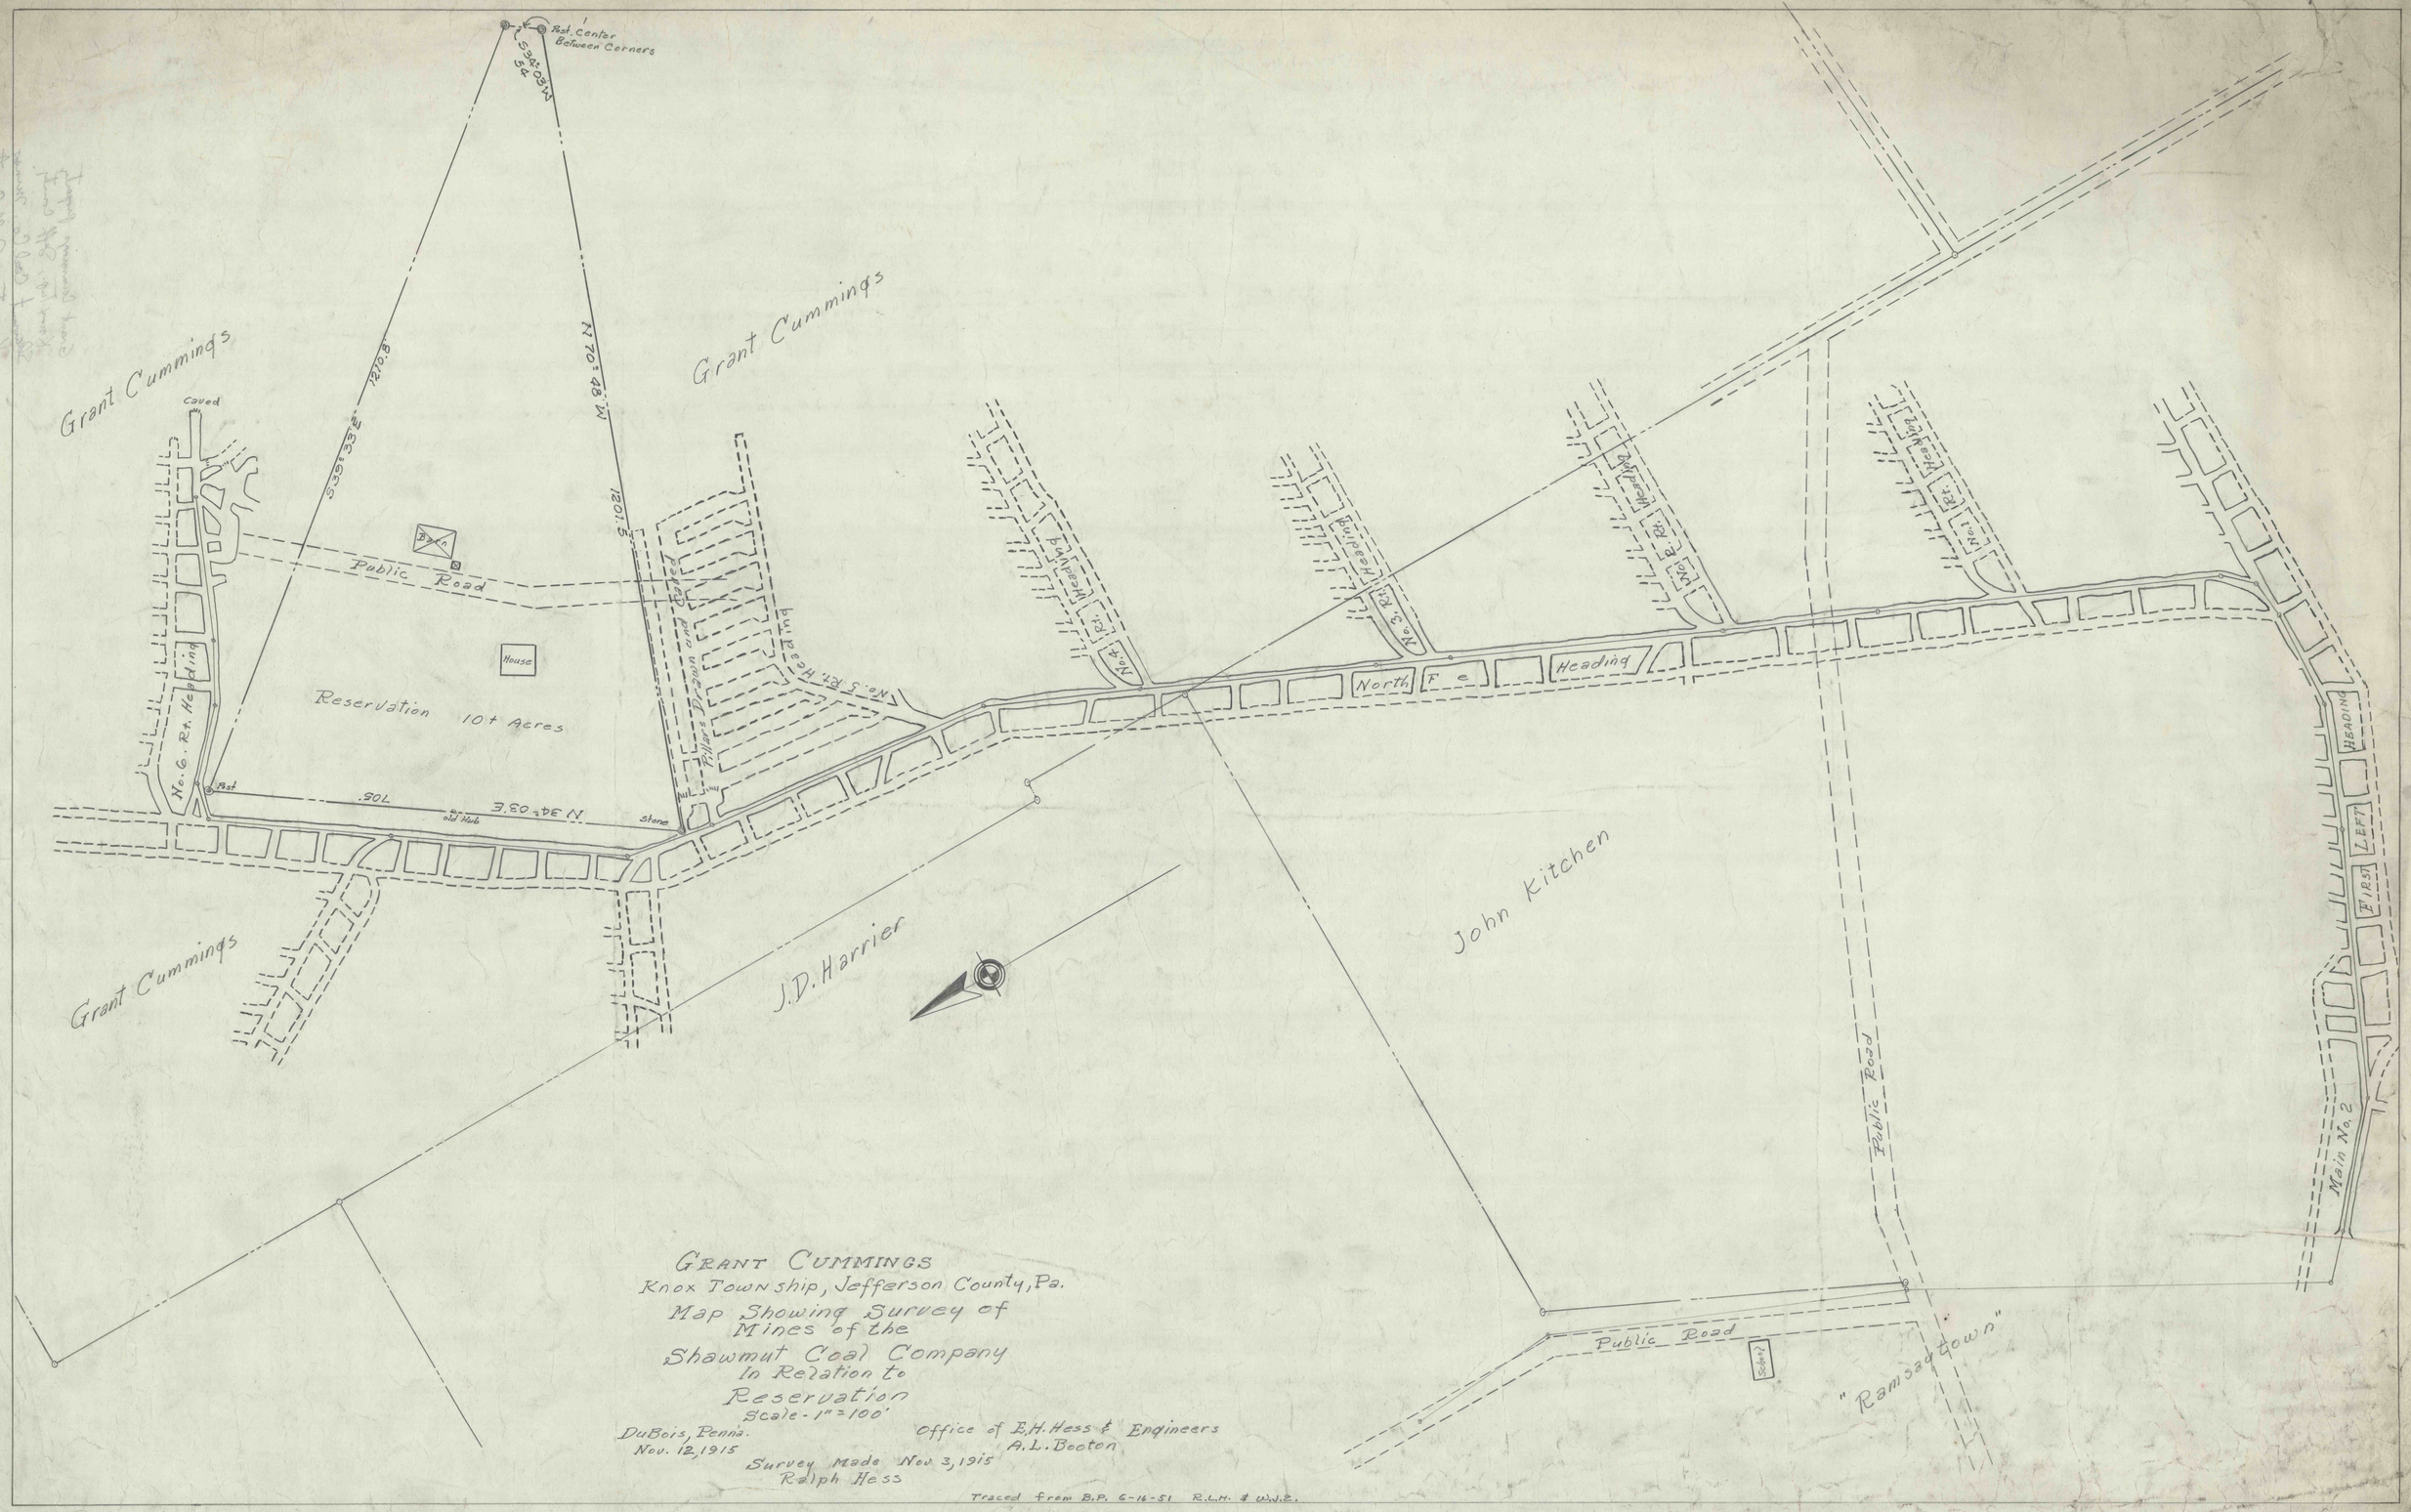

GRANT CUMMINGS
Knox Township, Jefferson County, Pa.
Map Showing Survey of
Mines of the
Shawmut Coal Company
In Relation to
Reservation
Scale - 1" = 100'

DuBois, Penna.
Nov. 12, 1915

Office of E.H. Hess & Engineers
A.L. Booton

Survey Made Nov 3, 1915
Ralph Hess

Traced from B.P. 6-16-51 R.L.H. & W.J.Z.

1-A-112