




THE MILL COAL CO.

PORTER TWP., JEFFERSON CO. PA.,

SCALE 1" = 100.

ORIGINAL SURVEY BY H.M. KANARR

Surveys- H.M. Kanarr	May 1918	Map Made
" "	July 1917	
" "	Mar. 1918	
" "	Sept. 1918	
" "	Feb. 1919	
" "	July 1919	
Med. M. Corliss	Jan 1920	
" "	Aug 1920	
" "	Dec 1920	
" "	Oct 1921	
" "	Feb 1922	
" "	June 1923	
H.M. Walker	Mar. 1926	
" "	April 1928	

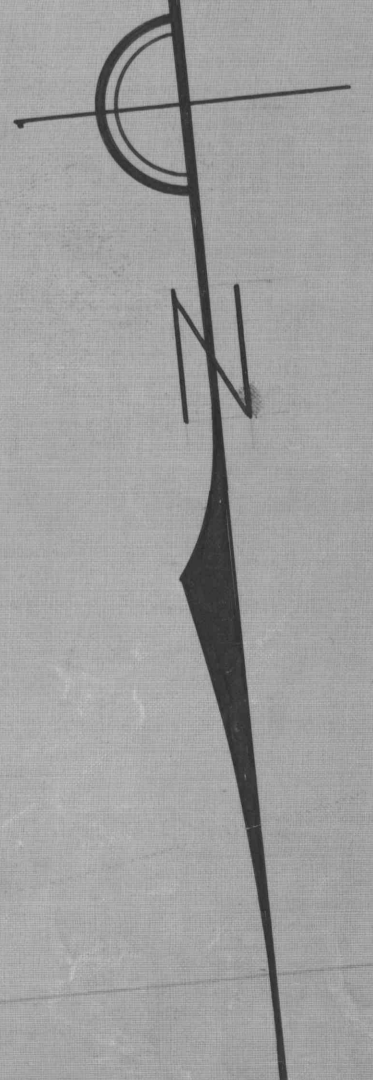

6000-S

5000-S

4000-S

3000-W

4500-W

5500-W