


7-1/2 Miles
T. 10 N. R. 2 E.

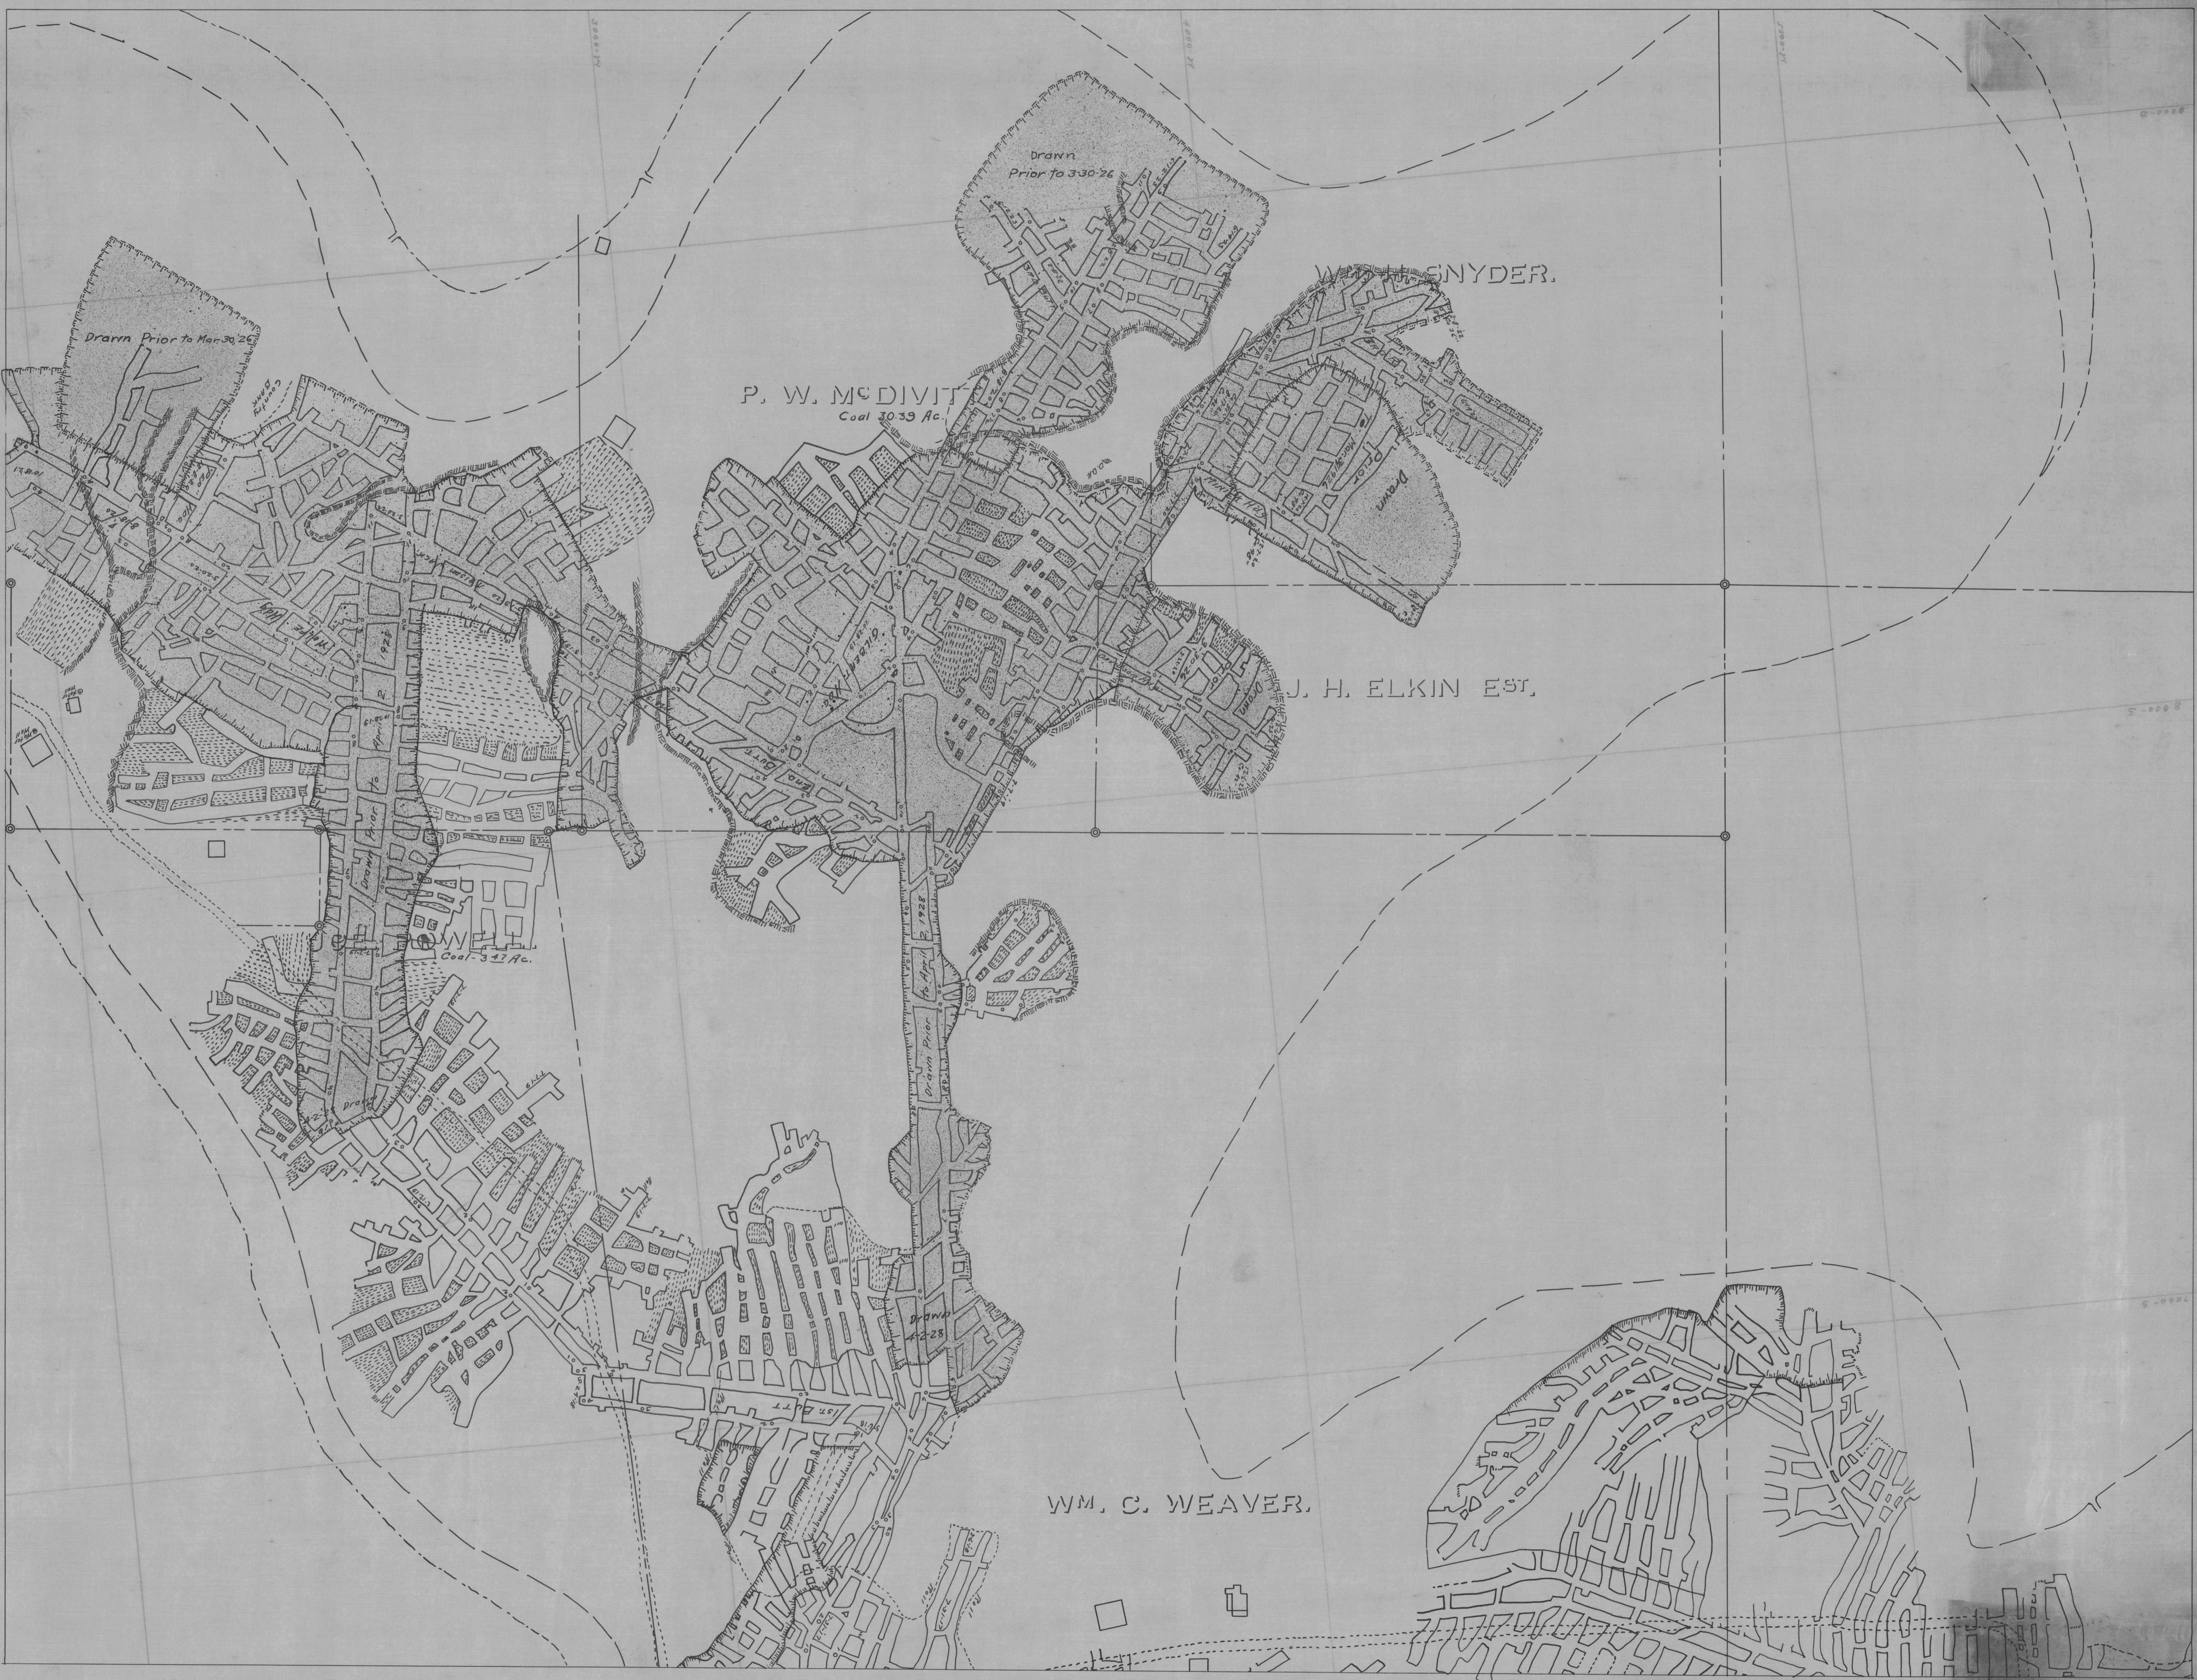

Drawn
Prior to 3-30-26

Drawn Prior to Mar 30 26

P. W. McDIVITT
Coal 30.39 Ac.

W. H. SNYDER.

J. H. ELKIN EST.

Coal 3.27 Ac.

Drawn
Prior to 12-28

WM. C. WEAVER.