

# MINE MAP


## OF

### ANITA COAL COMPANY

Coolspring No. 1 Mine

Oliver Twp. Jefferson Co. Pa.  
Scale 1"=100' August 7, 1929

HARRY M. WALKER  
Mining Engineer  
Punxsutawney, Pa.

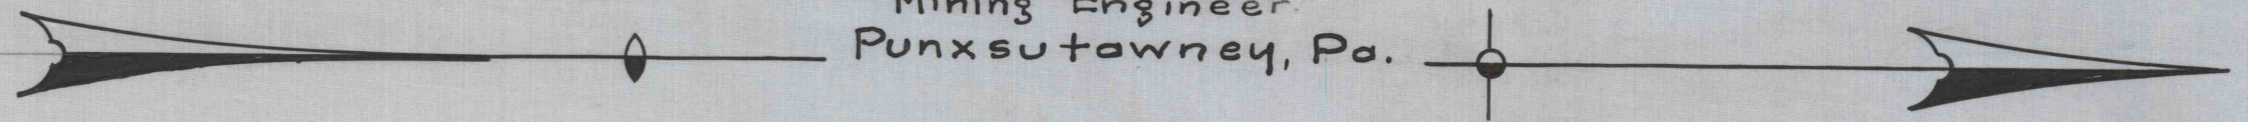

#### SURVEYS

- April 23, 1929
- Dec. 18, 1929
- Jan. 14, 1931
- Nov. 27, 1931
- Mar. 30, 1933
- July 25, 1935