



MINE MAP



# WORTHVILLE COAL CO., INC.

WORTHVILLE MINE

RINGGOLD TOWNSHIP, JEFFERSON COUNTY, PA.

SCALE 1"=400' JUNE 8, 1956

WALTER J. ZIMMERMAN SURVEYOR & ENGINEER PUNXSUTAWNEY, PA.

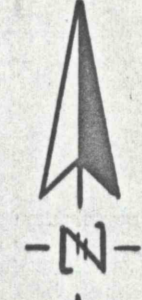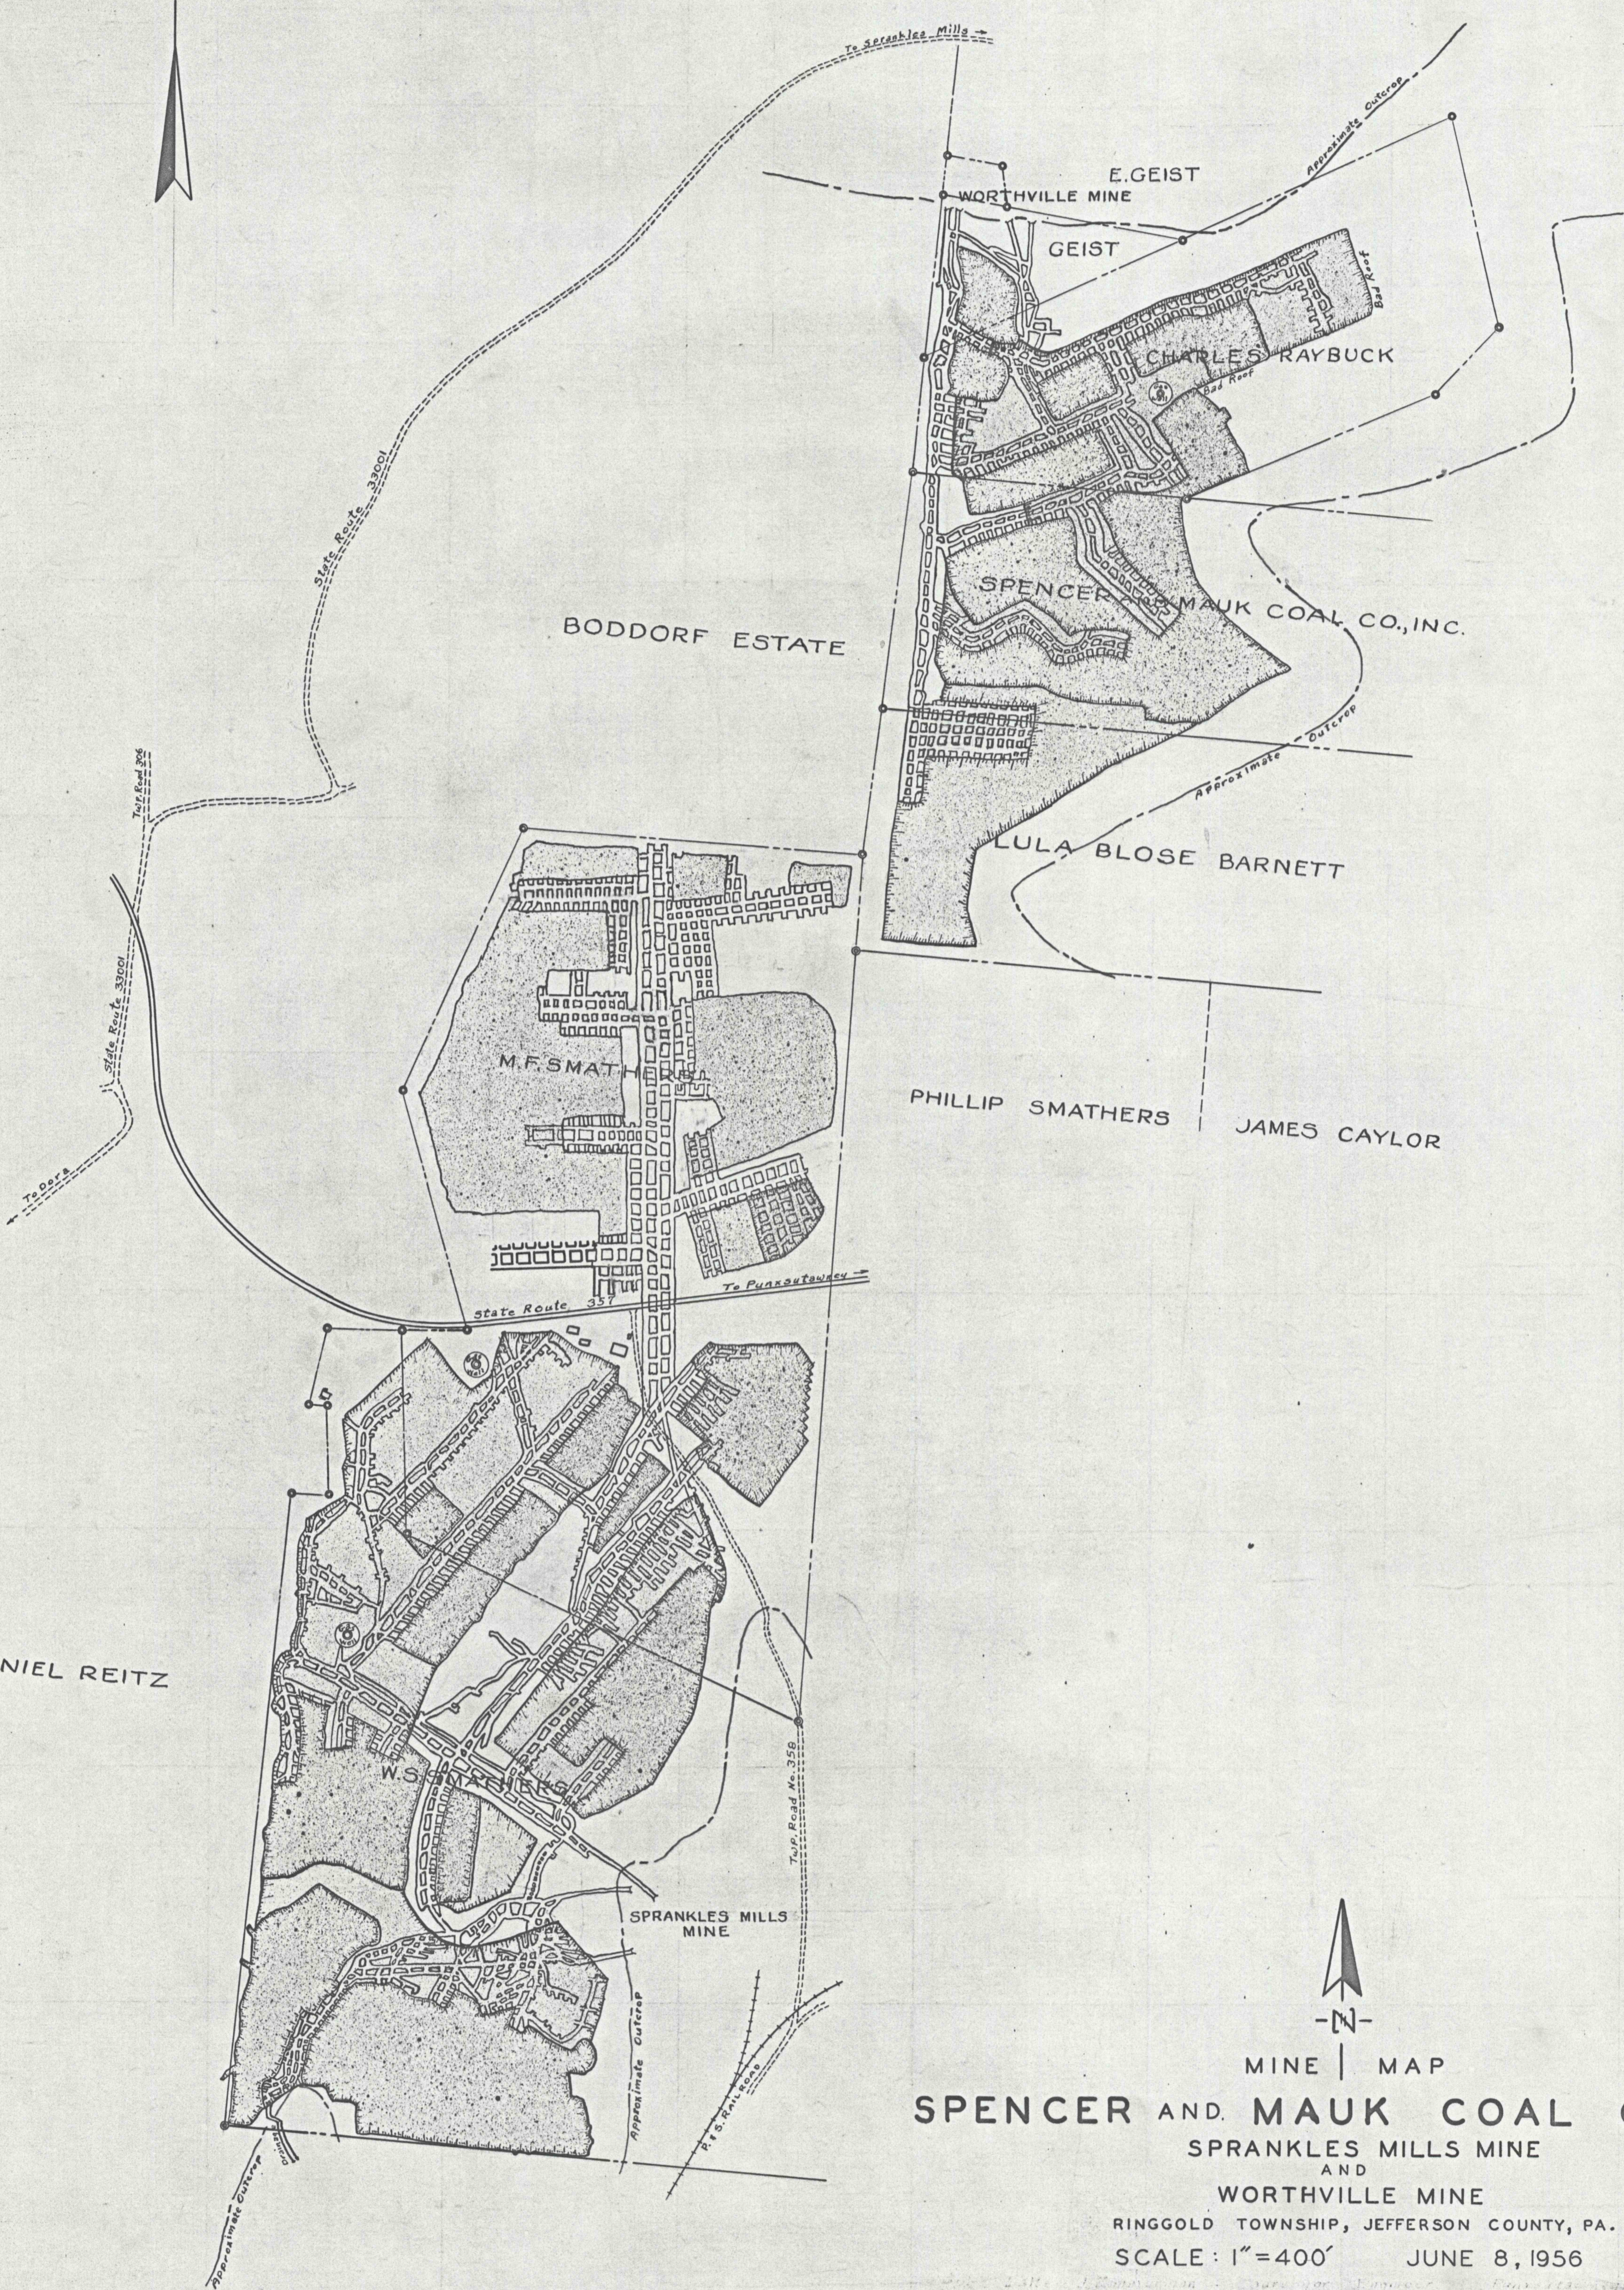

MINE MAP

# SPENCER AND MAUK COAL CO., INC.

SPRANKLES MILLS MINE

AND WORTHVILLE MINE

RINGGOLD TOWNSHIP, JEFFERSON COUNTY, PA.

SCALE: 1"=400' JUNE 8, 1956

