



R. B. DINGER

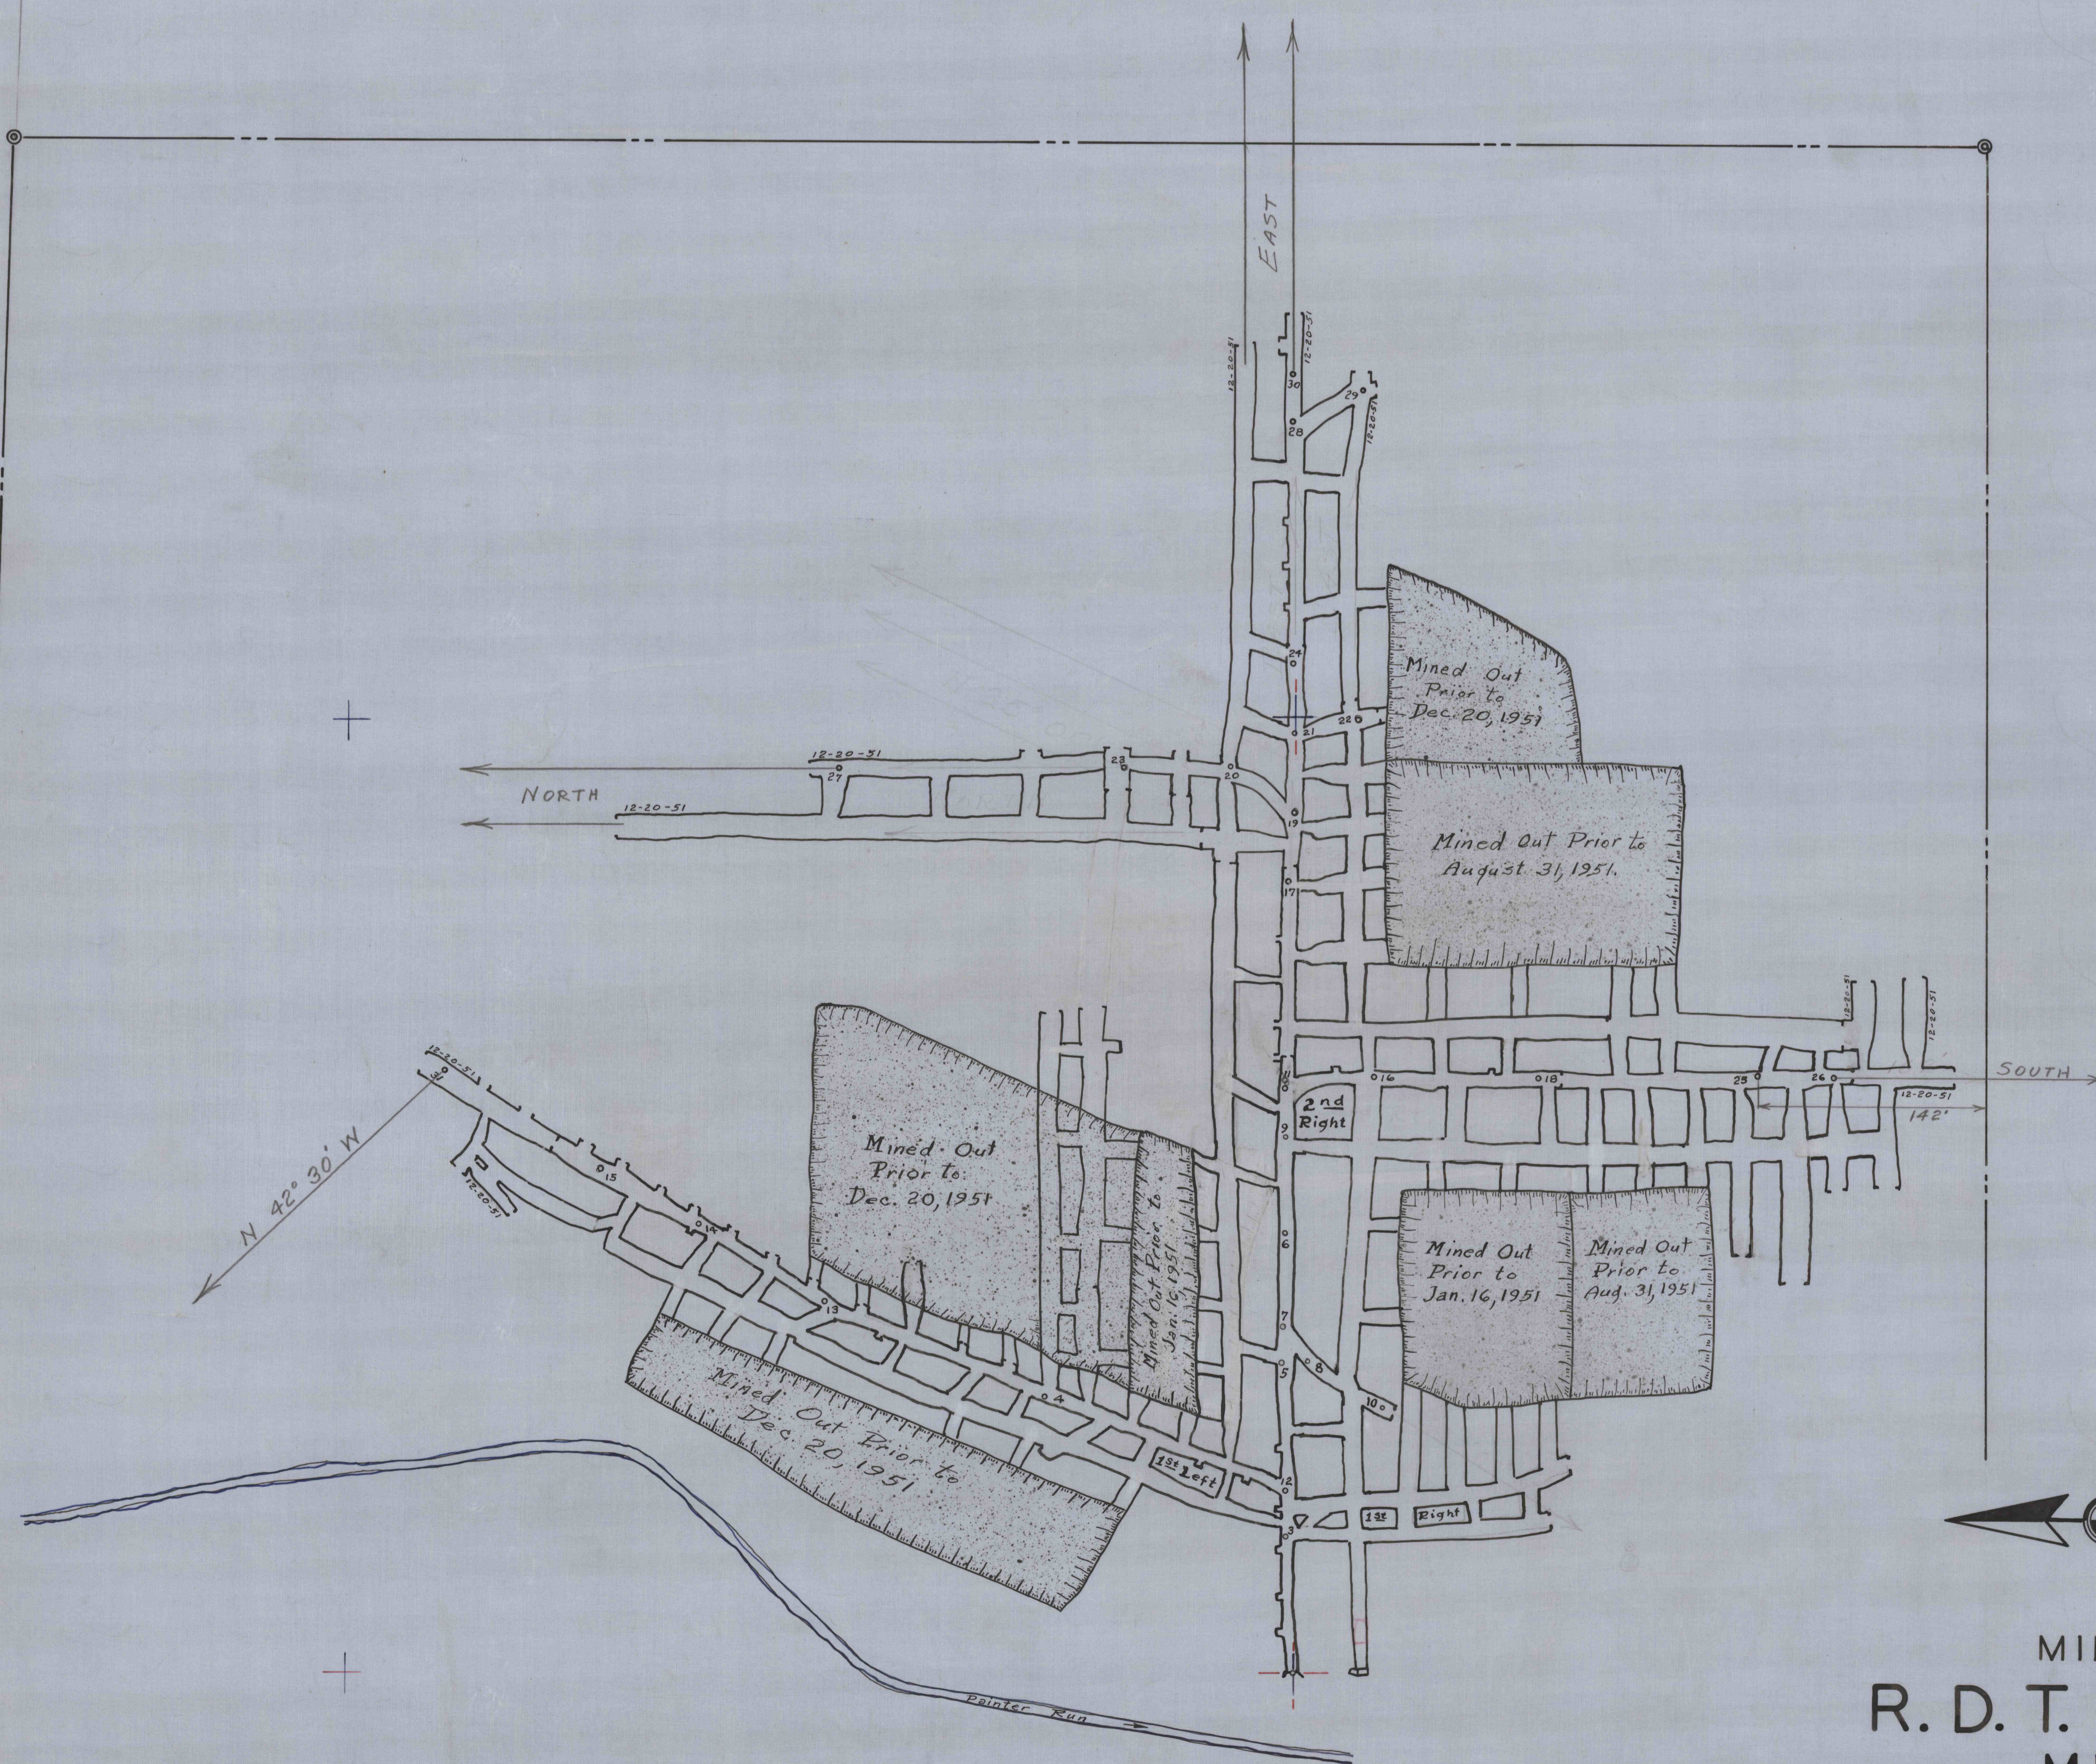

CLAIR SHUMAKER

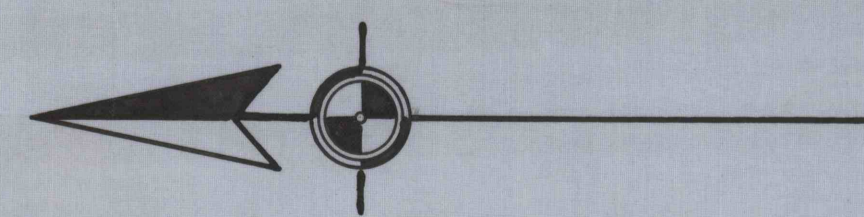

MINE MAP
R. D. T. COAL CO.
MINE

RINGGOLD TOWNSHIP, JEFFERSON COUNTY, PA.
SCALE 1 IN. = 100 FT. JUNE, 1950
WALTER J. ZIMMERMAN SURVEYOR - ENGINEER PUNXSUTAWNEY, PA.