

PERSON COAL CO.

BERWIND

COAL

MINING


COMPANY.

*Philip Smith
EK 1710
5.16 A*

*Henry Feltner
EK 1591
20.20 A*

*Henry Wolf
EK 1711
12.40 A*

*Outcrop
Upper
Freeport Vein*

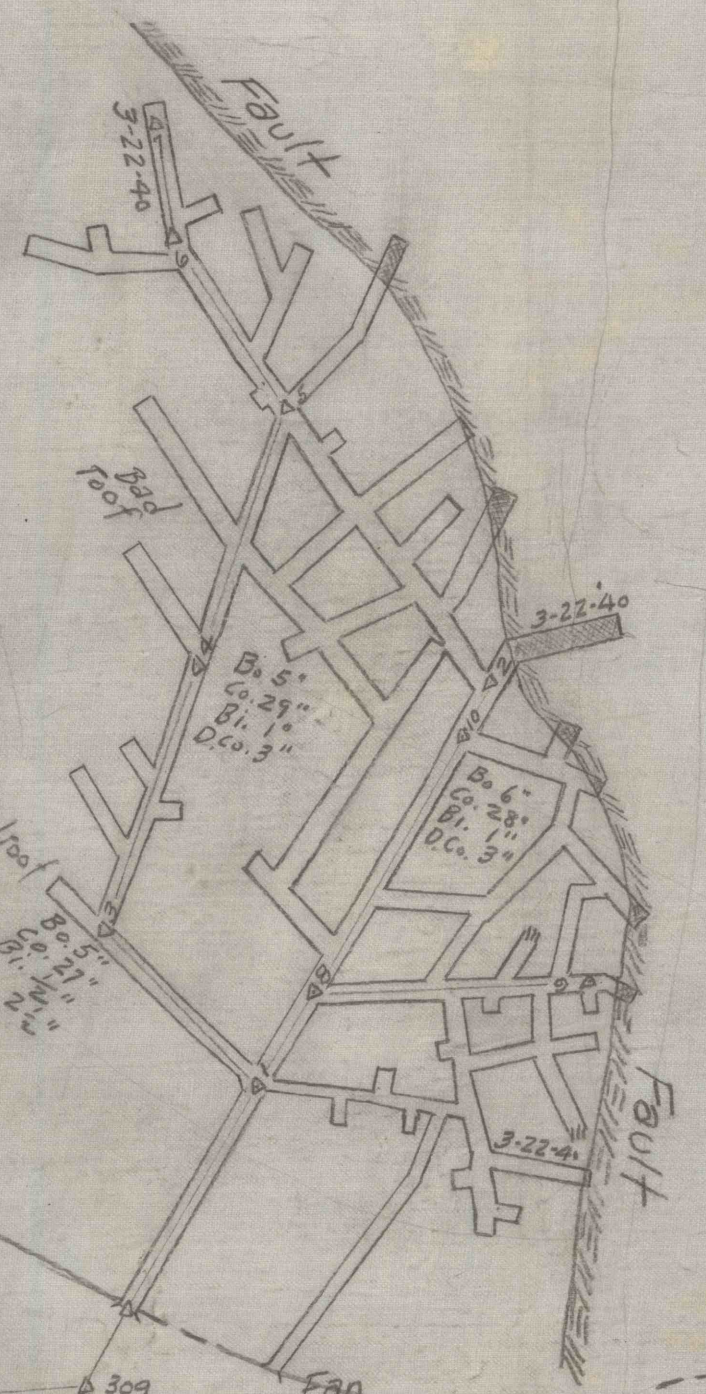

*200 ft
200 ft*

300 ft

300 ft

