


WHITEHEAD

JEFFE

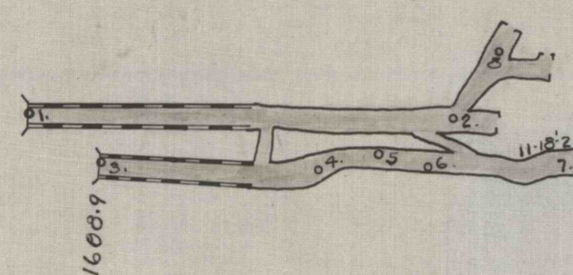

MINE MAP OF CORTEZ COAL CO.

Scale 1 in = 100 ft.

H.M. Kenerr
Engr.

Punxsutanney Pa. Jan. 1922

DATE OF SURVEYS
Nov. 11, 1921.
Nov. 21, 1922.
July 21, 1923.
Nov. 26, 1923.



Handwritten initials 'H.M.K.' in red ink.

Handwritten number '175' in black ink.