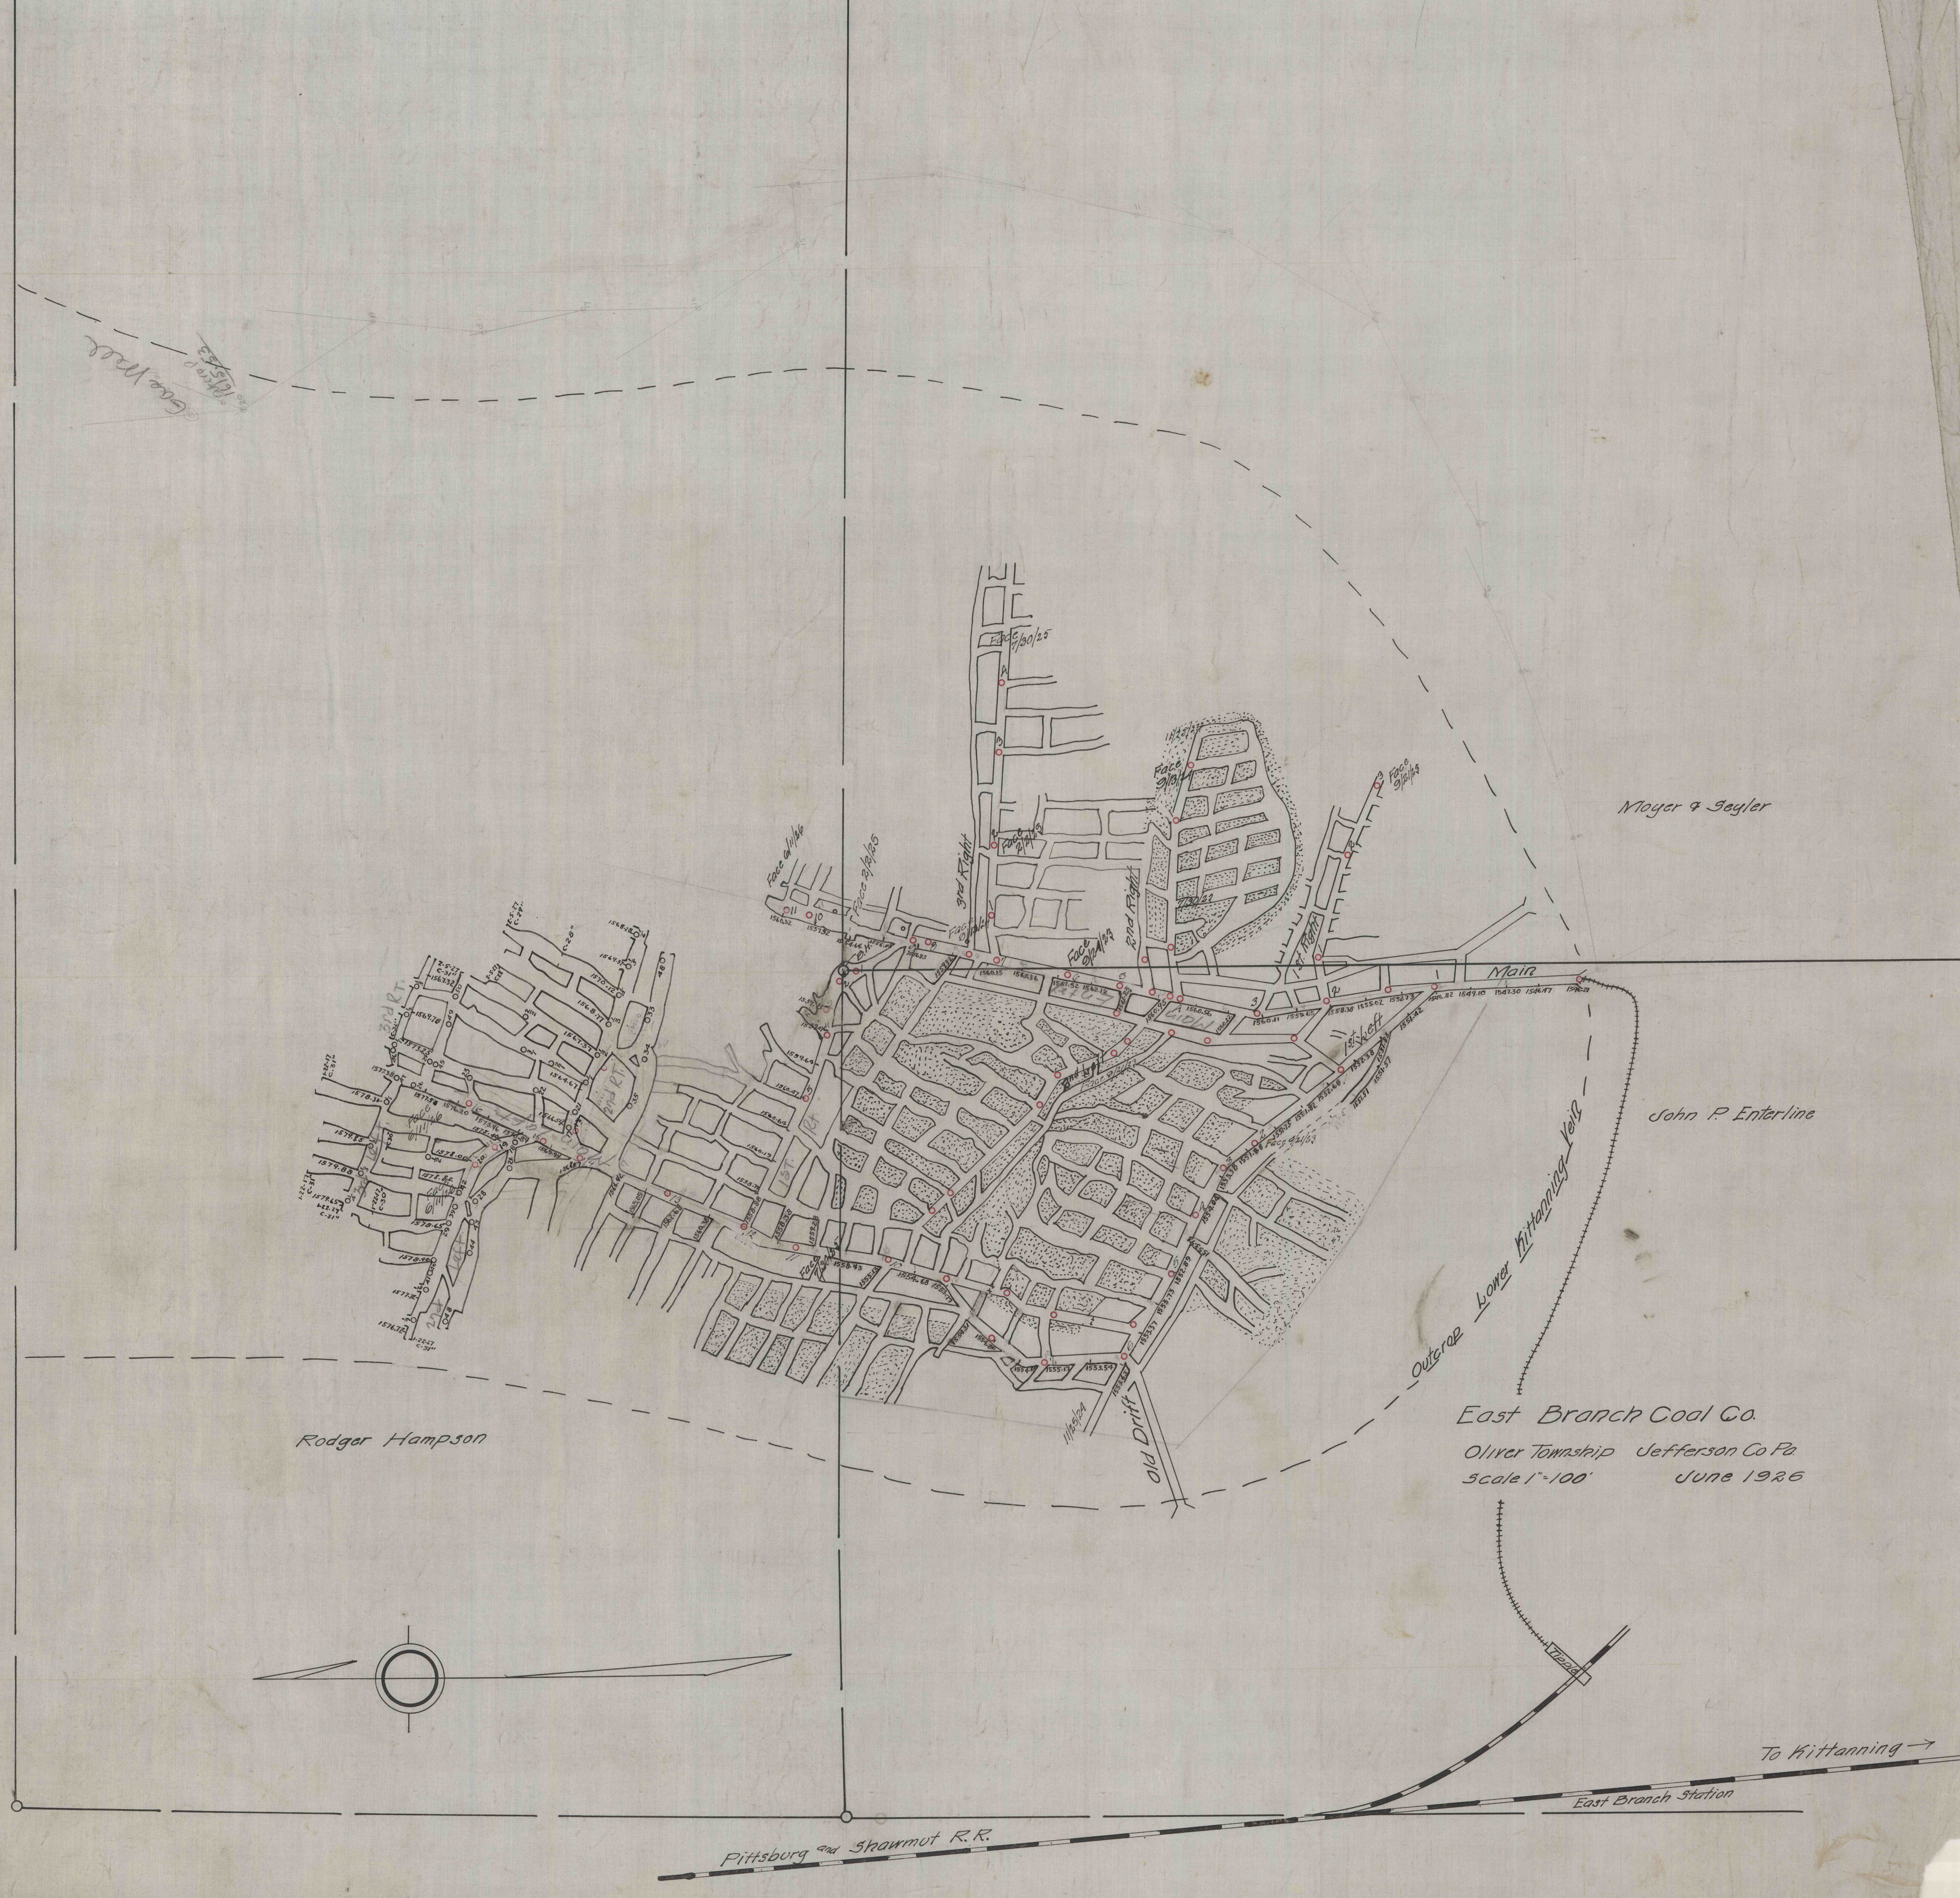
East Branch Coal Co.
Oliver Township Jefferson Co Pa.
Scale 1" = 100'
June 1926
Outcrop Lower Kittanning Vein
Moyer & Seyler
John P. Enterline
Rodger Hampson
Main
1st Left
1st Right
2nd Right
3rd Right
Old Drift
Tipple
To Kittanning
East Branch Station
Pittsburg and Shawmut R.R.
Gas Well