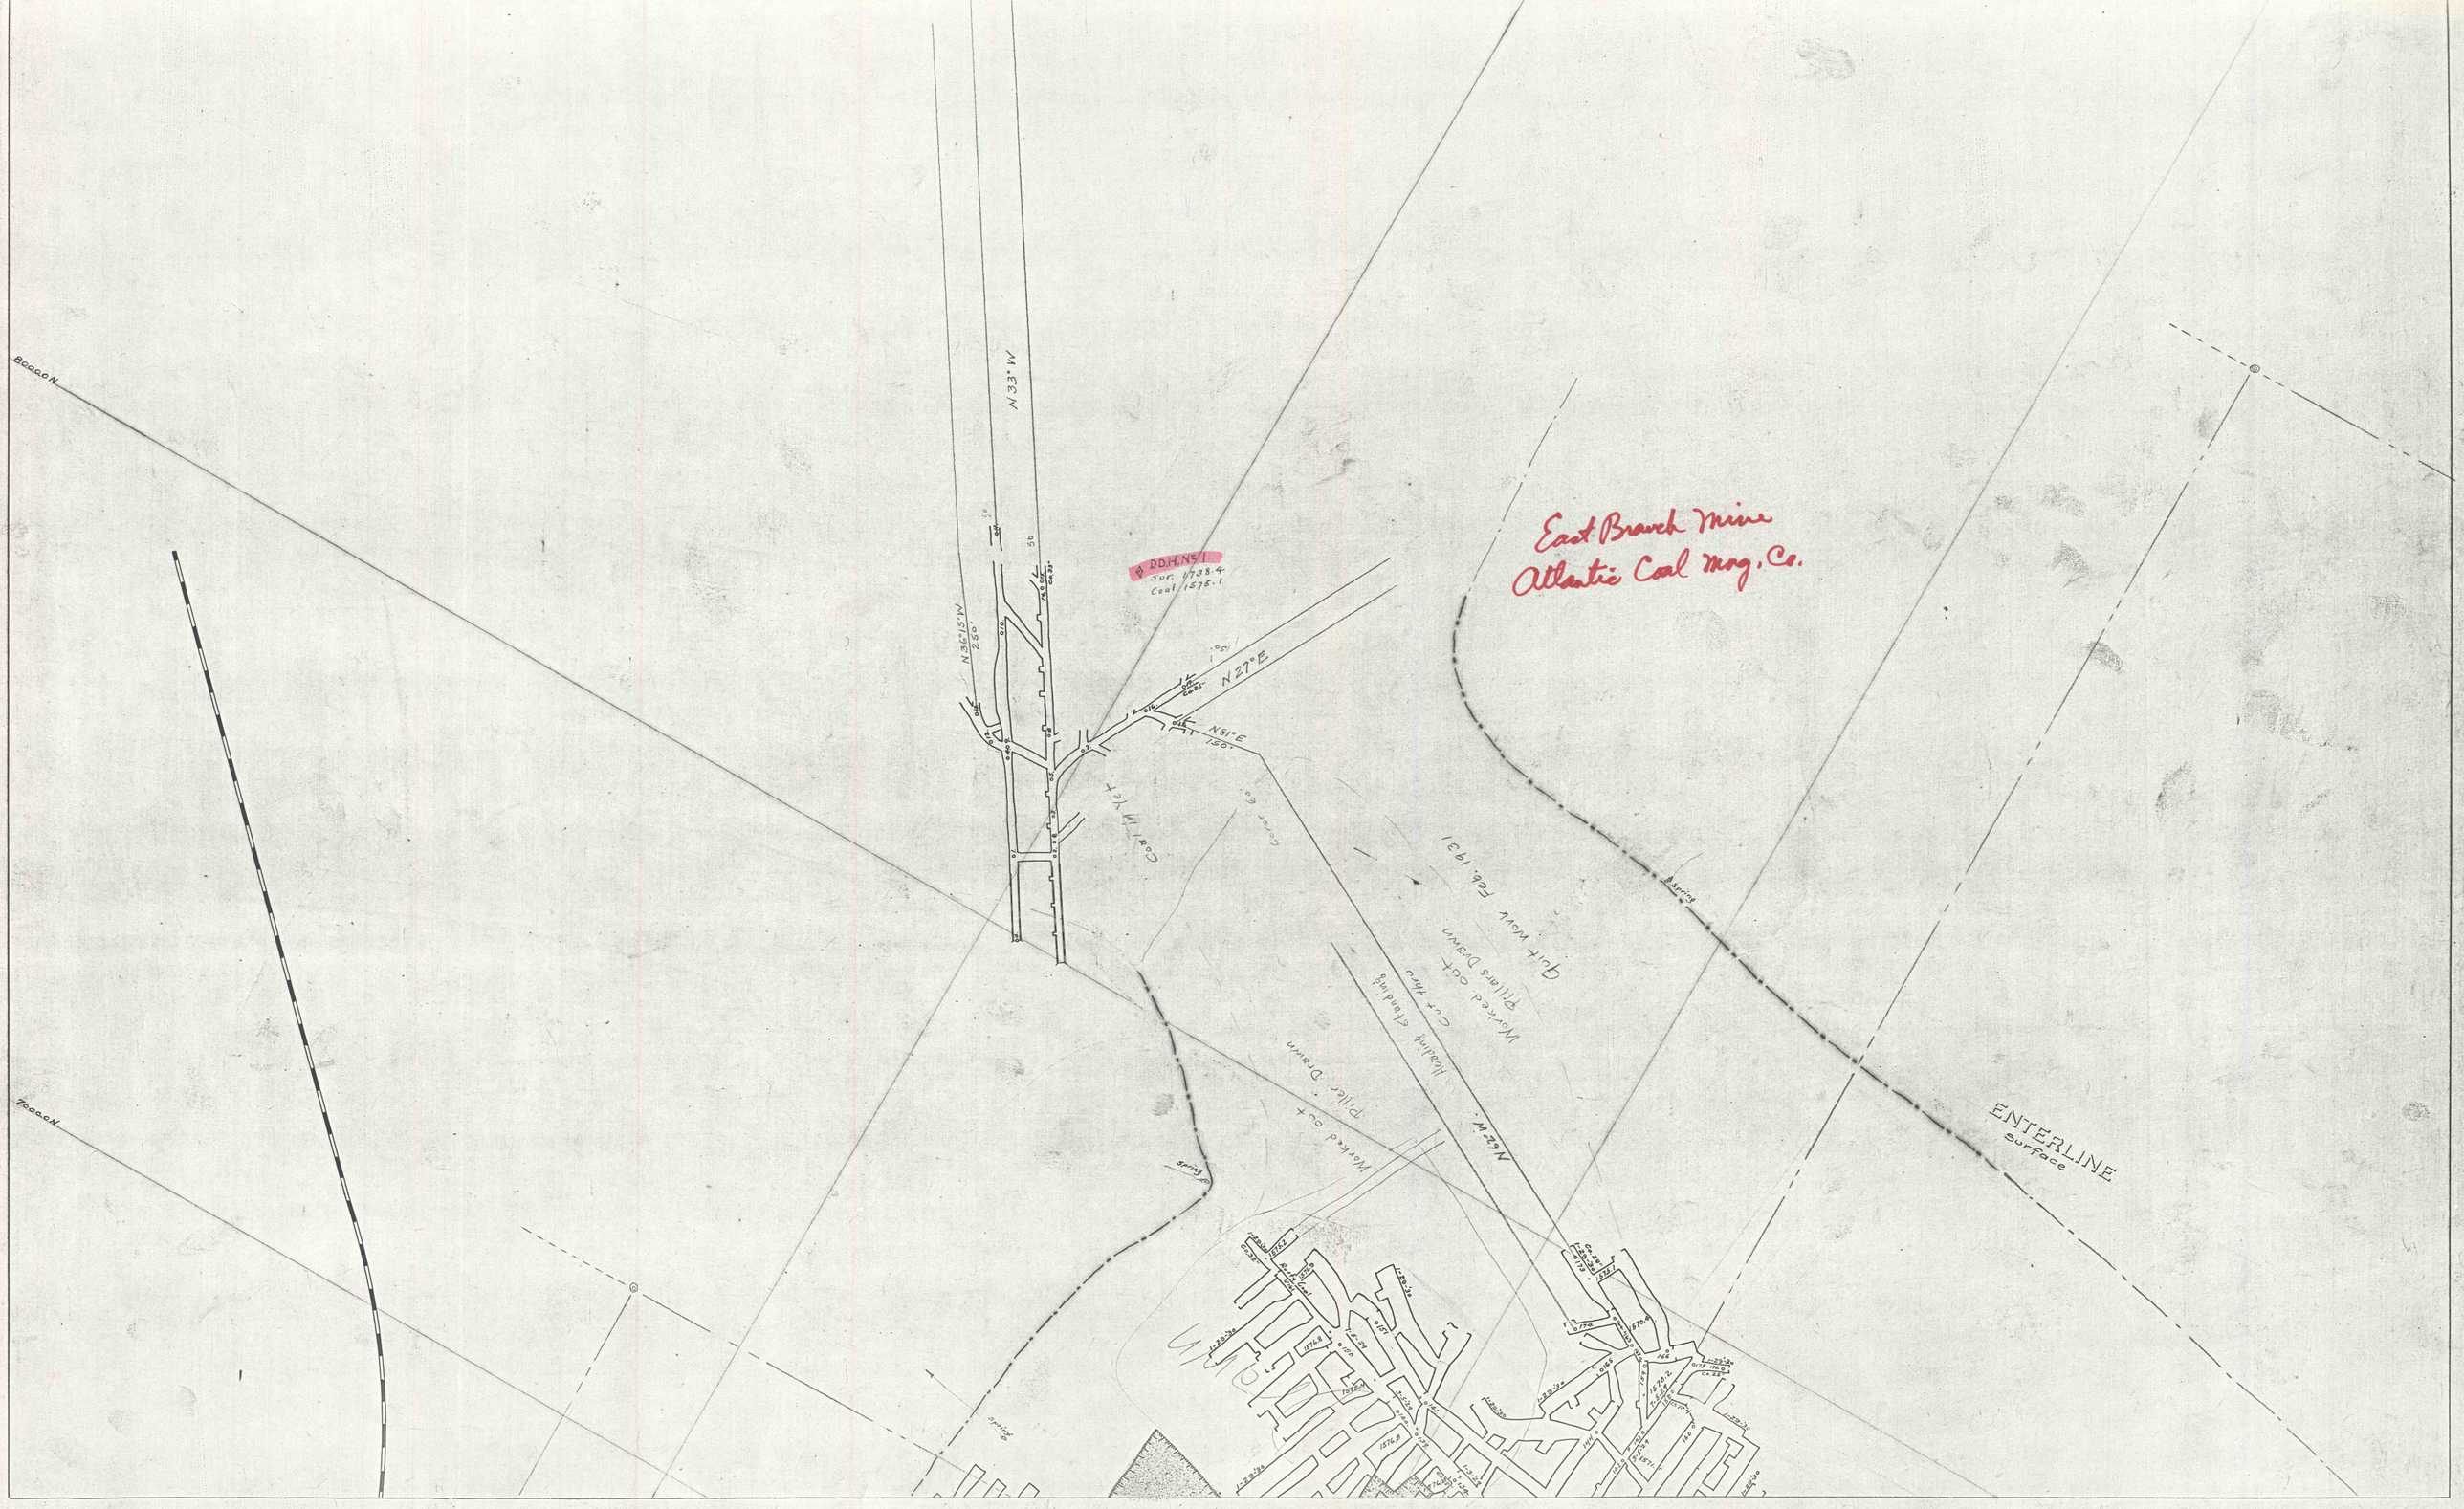

East Branch Mine
Atlantic Coal Mng. Co.
DD.H. No 1
Sur. 1738.4
Coal 1575.1
N 33° W
N 36°15' W
250'
N 27° E
N 81° E
150'
N 62° W
Coal in Yet
Quit work Feb. 1931
Worked out
Pillars Drawn
Heading standing
Cut thru
Pillar Drawn
Worked out
ENTERLINE
Surface
Spring