


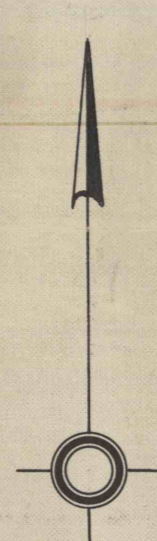

OLD WORKINGS



Farm of
JACOB K. BOWERS
 Gaskill Twp. Jeff. Co. Pa.
 Showing coal remaining in the accessible
 parts of the mine workings of the
Bowersville Coal Co.
 Scale 1 inch = 80 feet.
 April 1, 1917.

H. M. Kanarr Engineer.

Resultant Data —

Area of pillar coal remaining within limits of survey,	14.78 Ac.
Thickness of coal. Average of 16 sections,	42.03 in.
Cubical Contents per Acre,	177979 cuft.
Estimated weight of coal per cubic foot,	78 lbs.
Net tons of coal per Acre,	6941.
Total net tons of coal in pillars,	102288.