

ANDREW SMITH ESTATE

HUGH MILLEN

ELIZABETH KINNEAR ESTATE


SMATHERS

DATE OF LAST SURVEY
FEB. 4, 1948
DEC. 22, 1949

MAP OF
R. A. BECKMAN COMPANY
COAL MINE No. 6
OLIVER TOWNSHIP, JEFFERSON COUNTY, PA.

WALTER J. ZIMMERMAN SURVEYOR PUNXSUTAWNEY, PA.

SCALE 1 INCH = 100 FEET

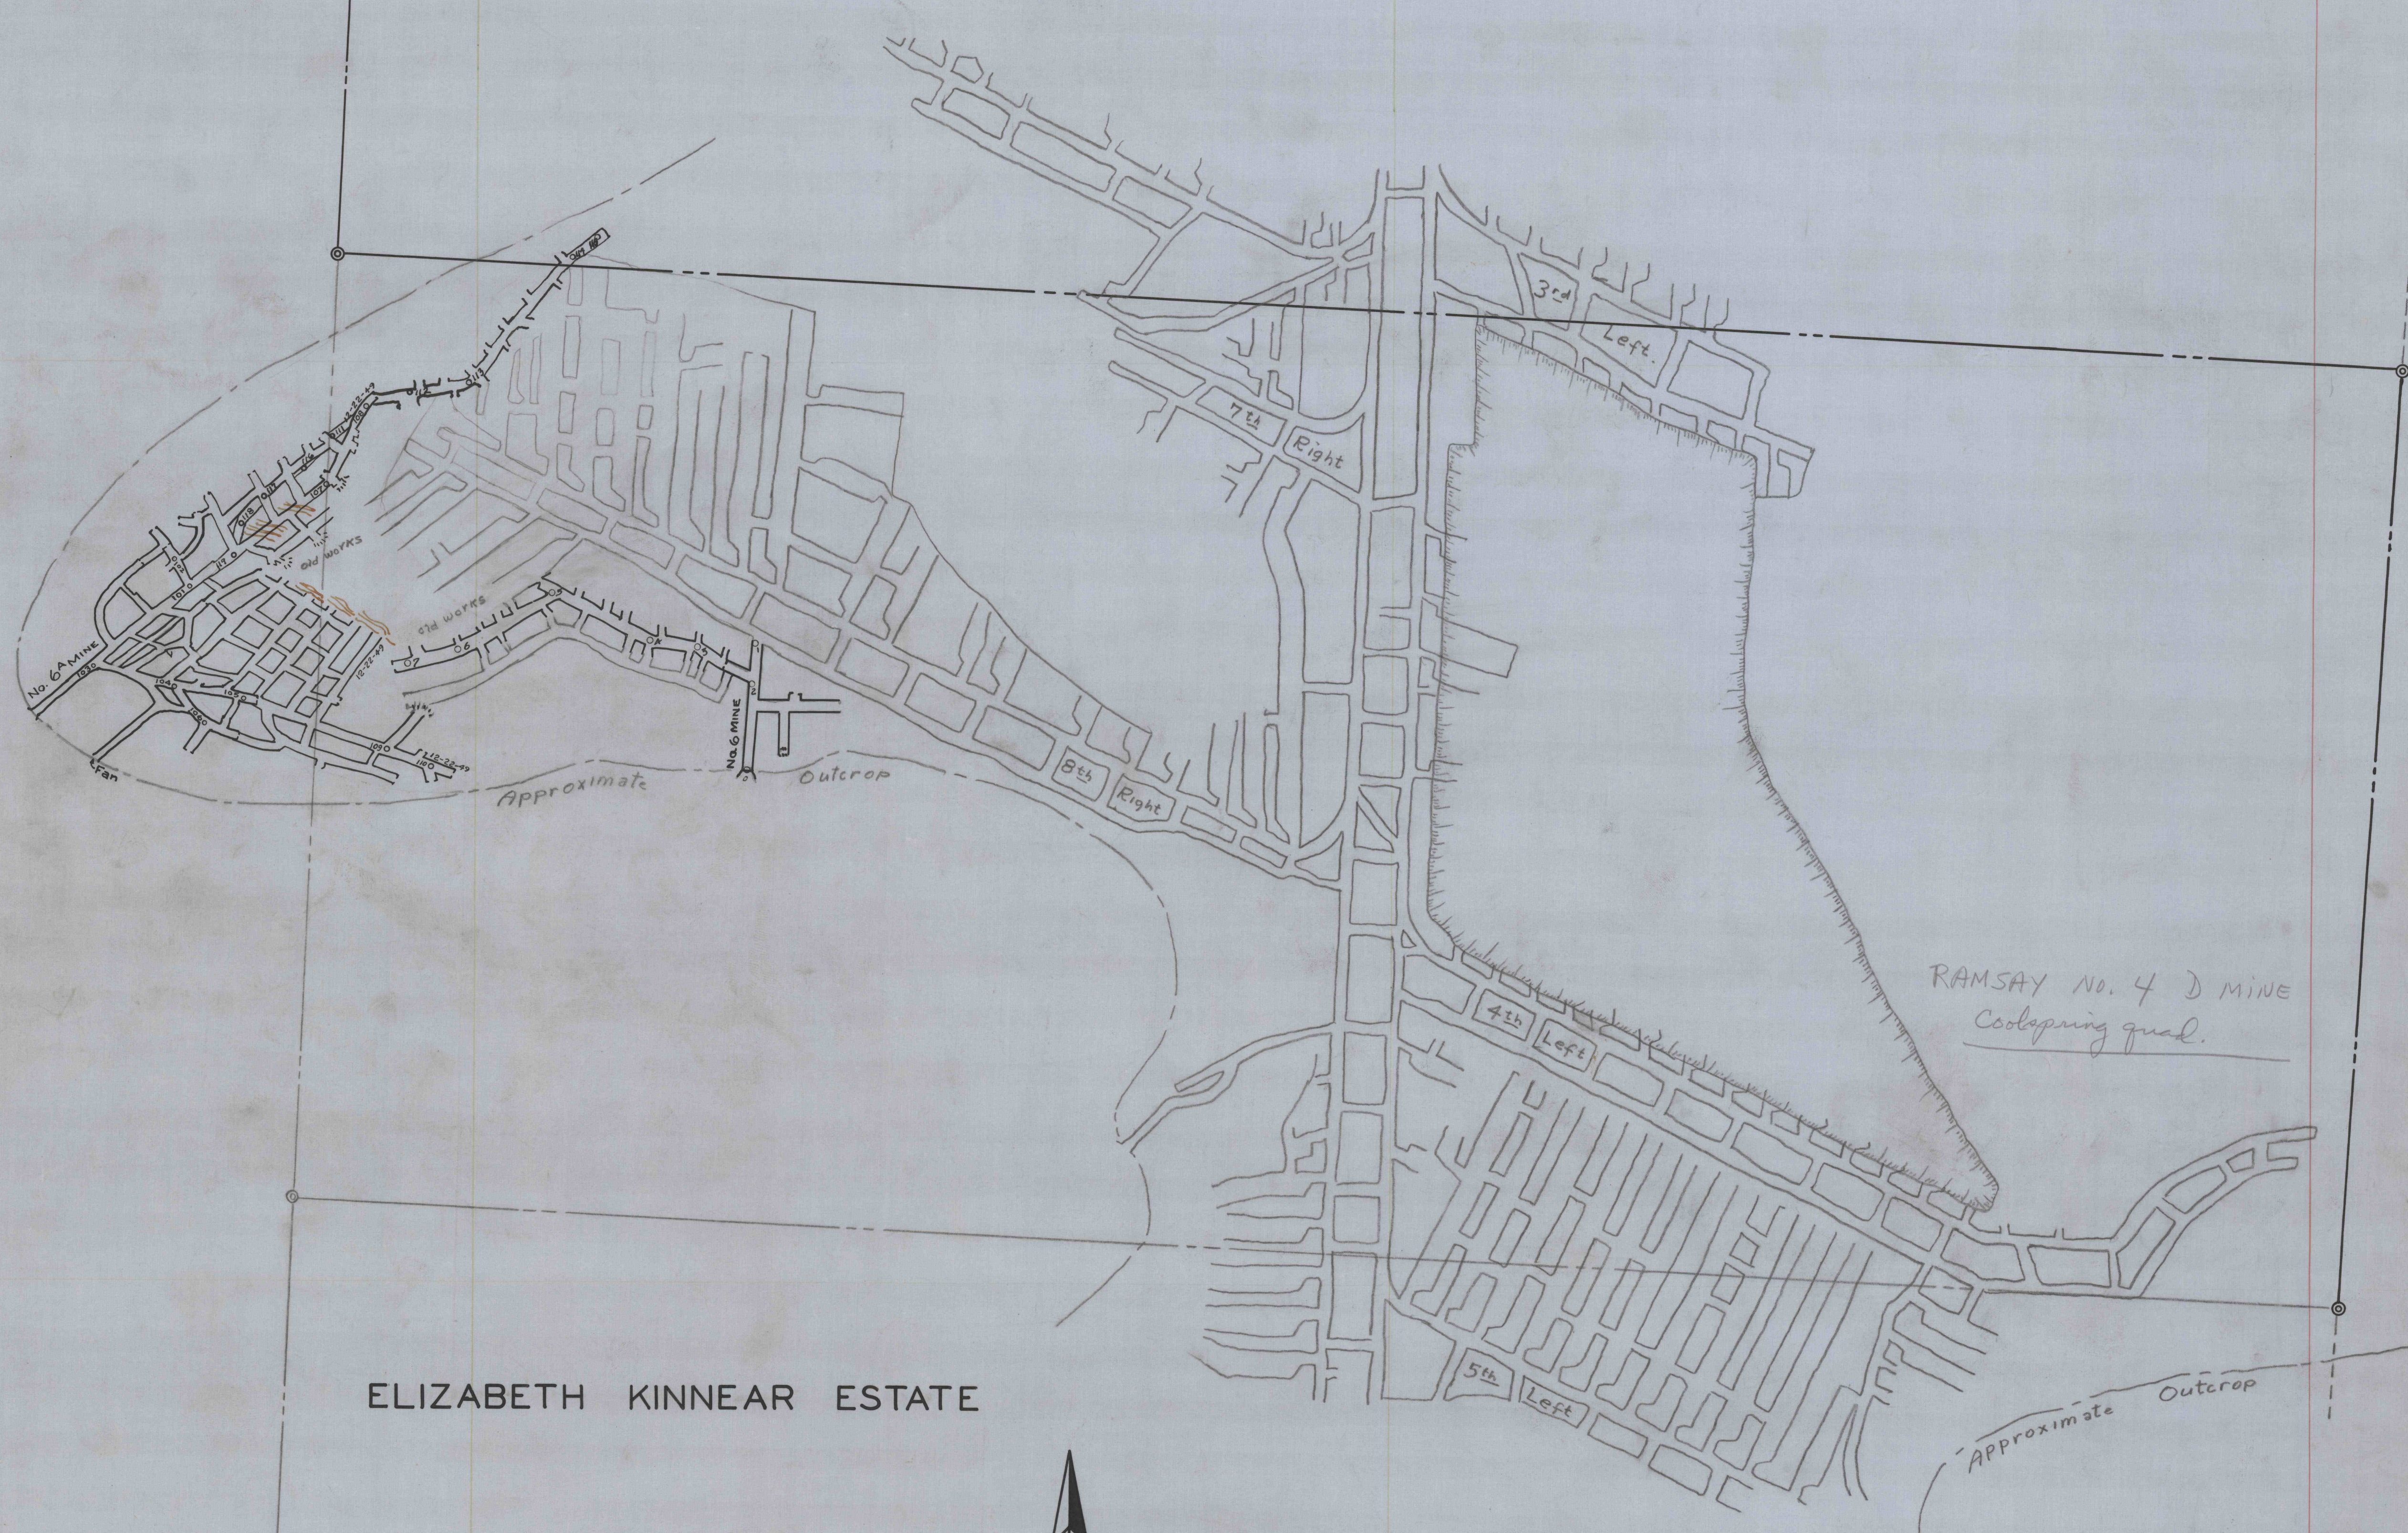

Handwritten notes:
1-8-88
No. 6 Mine workings
Ramsay No. 4 D Mine
Collapsing qual.

Handwritten numbers:
2485
97.00
294 97 887