
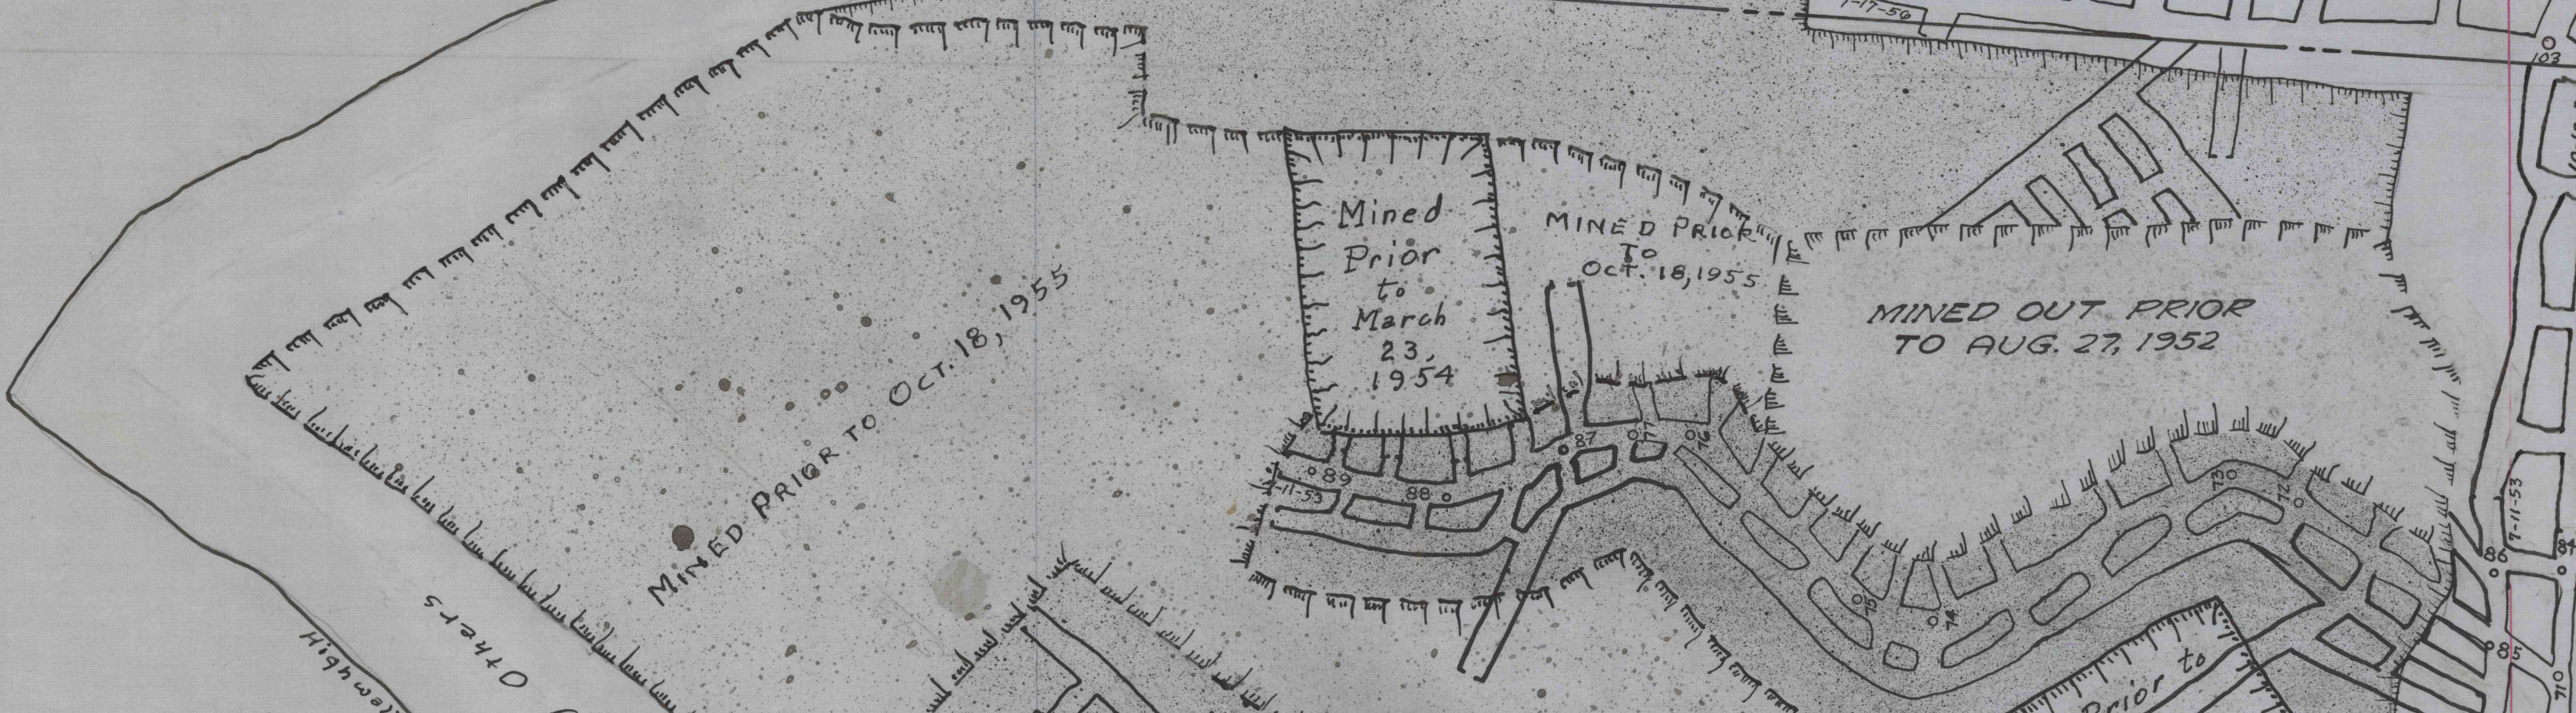



BARNETTE

Mined Prior to Jan. 28, 1959

Highway 7  
Auger Mined By Others

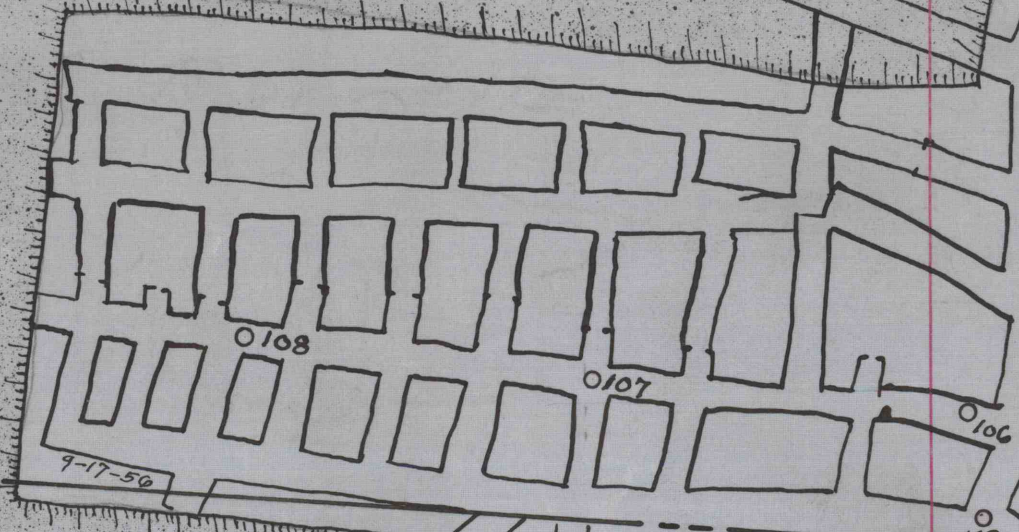

GAUB

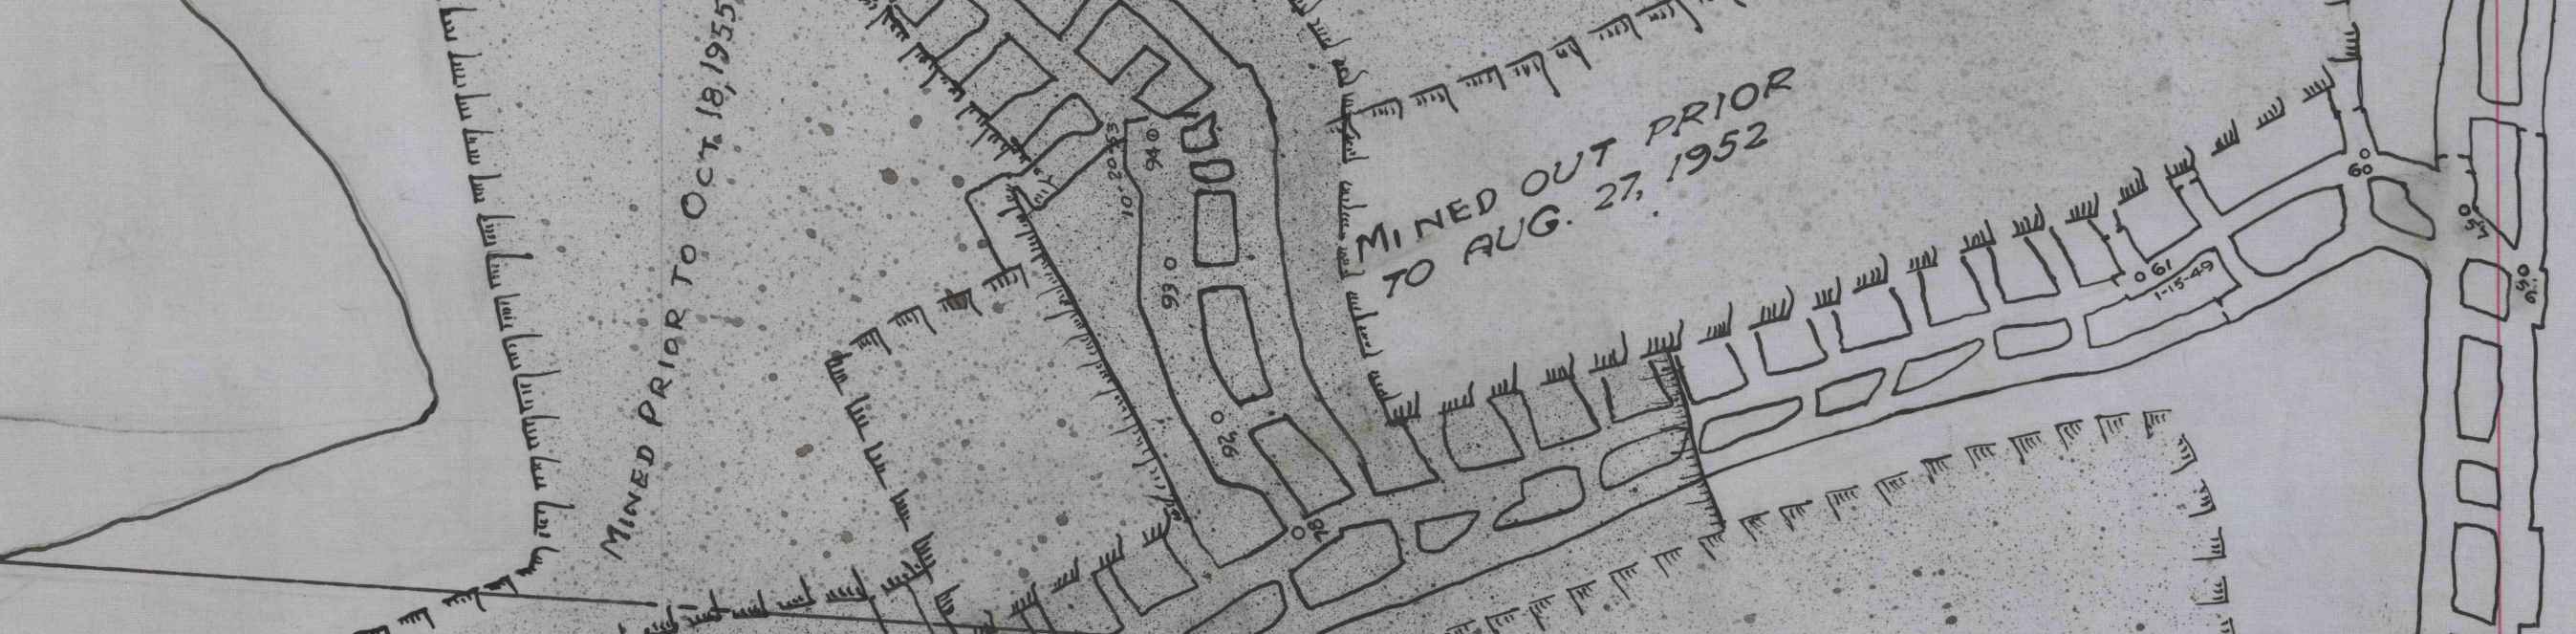

RAYBUCK




GEIST

WORTHVILLE COAL CO., INC.  
SURFACE

SPENCER AND MAUK COAL CO., INC.  
WORTHVILLE COAL CO. INC.  
MINE

RINGGOLD TOWNSHIP, JEFFERSON COUNTY, PENNA.  
SCALE: ONE INCH = ONE HUNDRED FEET  
WALTER J. ZIMMERMAN SURVEYOR PUNXSUTAWNEY, PA. JULY, 1945

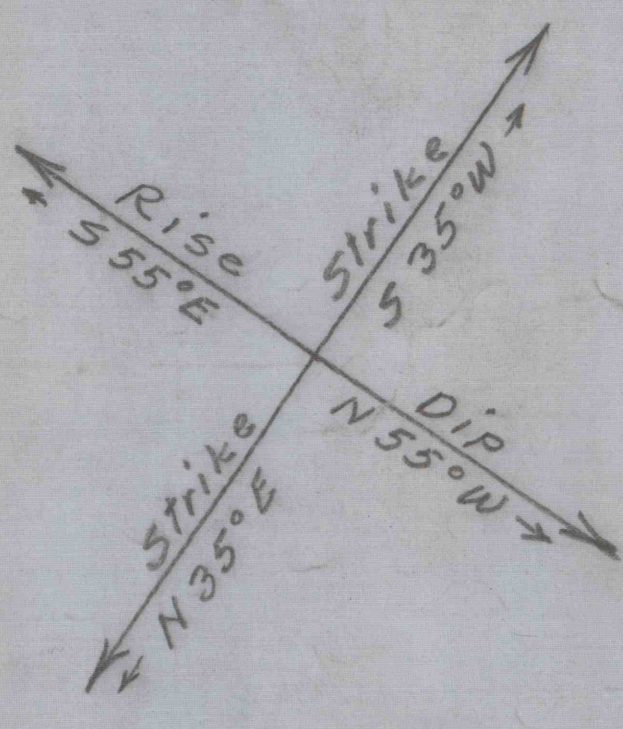

Date of Survey

July 11, 1953  
October 18, 1955

BODDORF ESTATE

MINED 1-B-119

