

ZH-3  
Zacm 11/19/14

6000 E

7000 E

8000 E




APPROXIMATE

Drawn Prior to 1-26-32

DRAWN PRIOR TO NOV 19 1914

NOV 19 1914

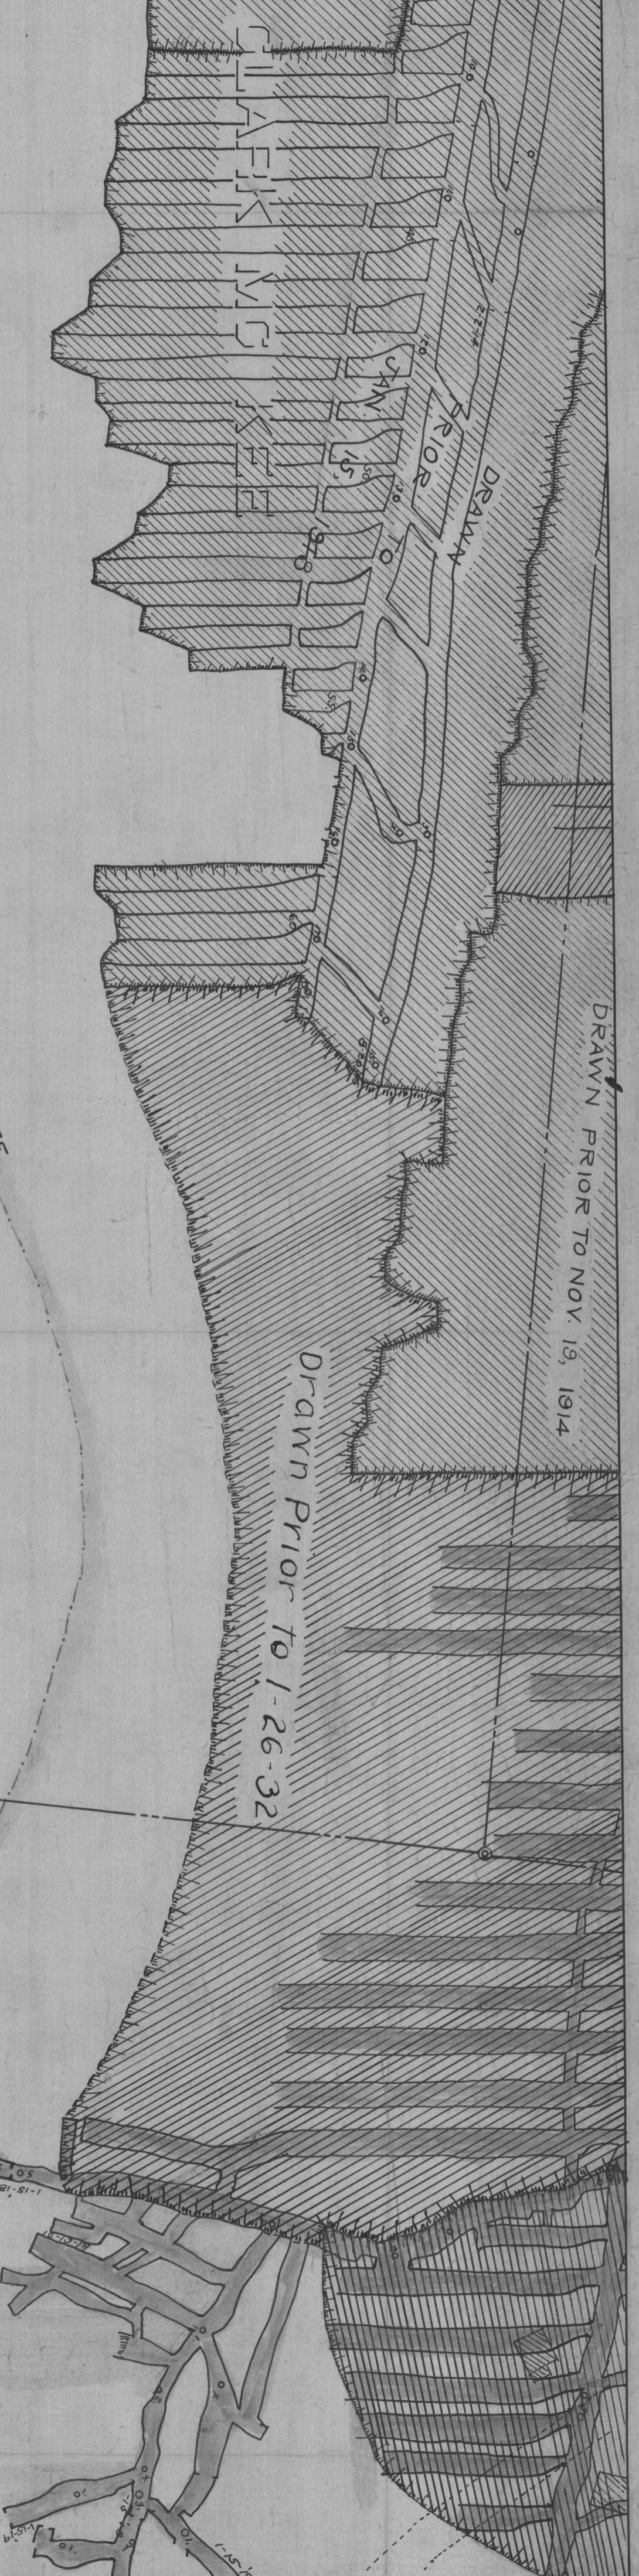

Note: Work east of this Border shown on Frances N:5 Map