


JOHN ERNST EST

2000.0 East

JOHN ERNST EST.

SHILTZ

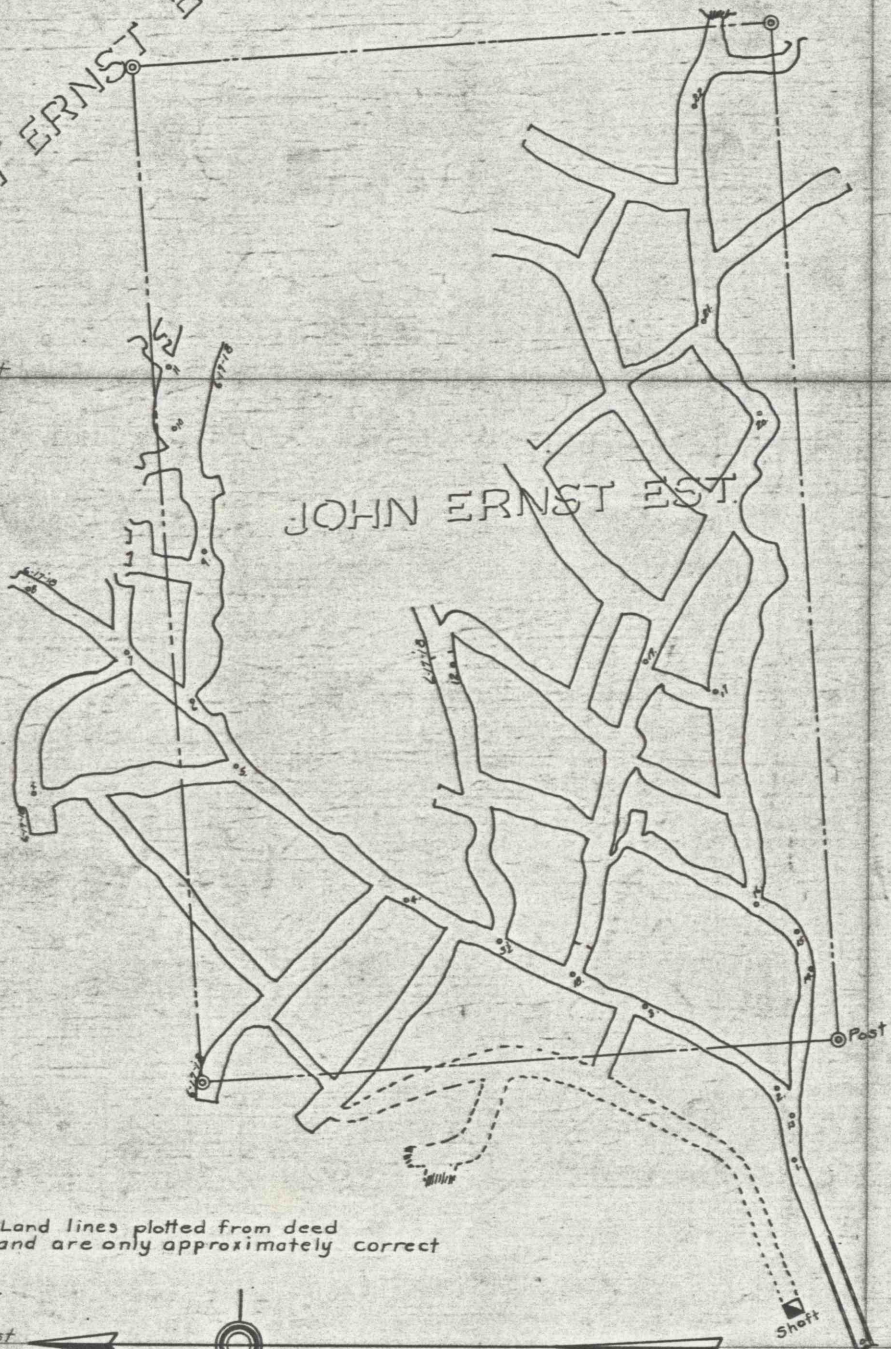

NOTE: Land lines plotted from deed and are only approximately correct

1000.0 East



Shiltz

1000.0 North

ZEDIK & KRUCILOCK
 Coal Mine near Anita, Jefferson Co, Penna.
 Scale 1"=50' H.M. Kanarr Eng'r Punxsutawney, Pa.

1" = 100'

