


Property Line

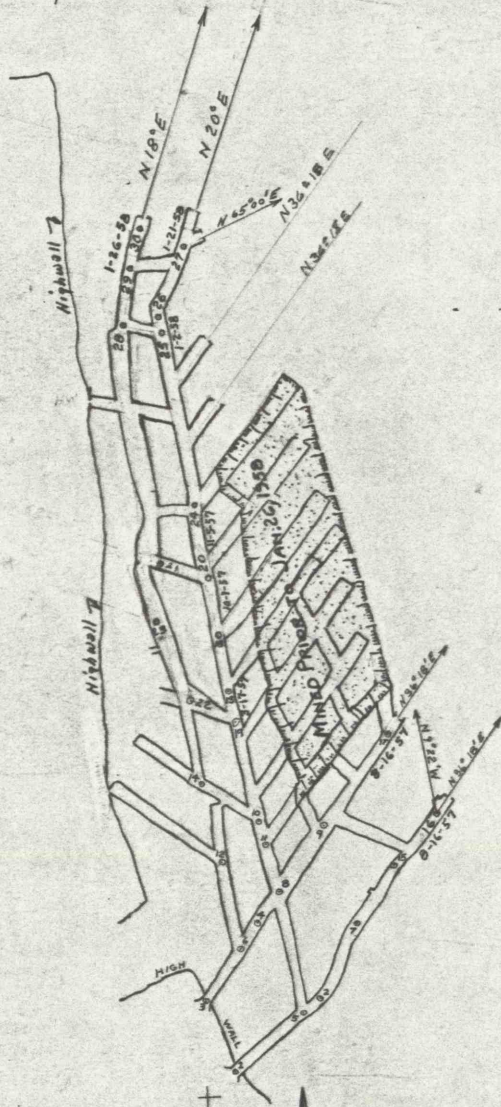

MINE MAP
BARILAR COAL CO., INC.
 MINE No. 1

YOUNG TOWNSHIP, JEFFERSON COUNTY, PA.

SCALE 1" = 100' AUGUST 20, 1957

WALTER J. ZIMMERMAN - SURVEYOR-ENGINEER - PUNKSUTAWNEY, PA.

1" = 200'

2-D-19

2-D-19