


1-B-109

MINE MAP BARILAR COAL CO. MINE

YOUNG TOWNSHIP, / JEFFERSON COUNTY, PENN'A.
SCALE 1" = 100' JANUARY, 1948
WALTER J. ZIMMERMAN - SURVEYOR - ENGINEER - PUNXSUTAWNEY, PENN'A.



1-B-109

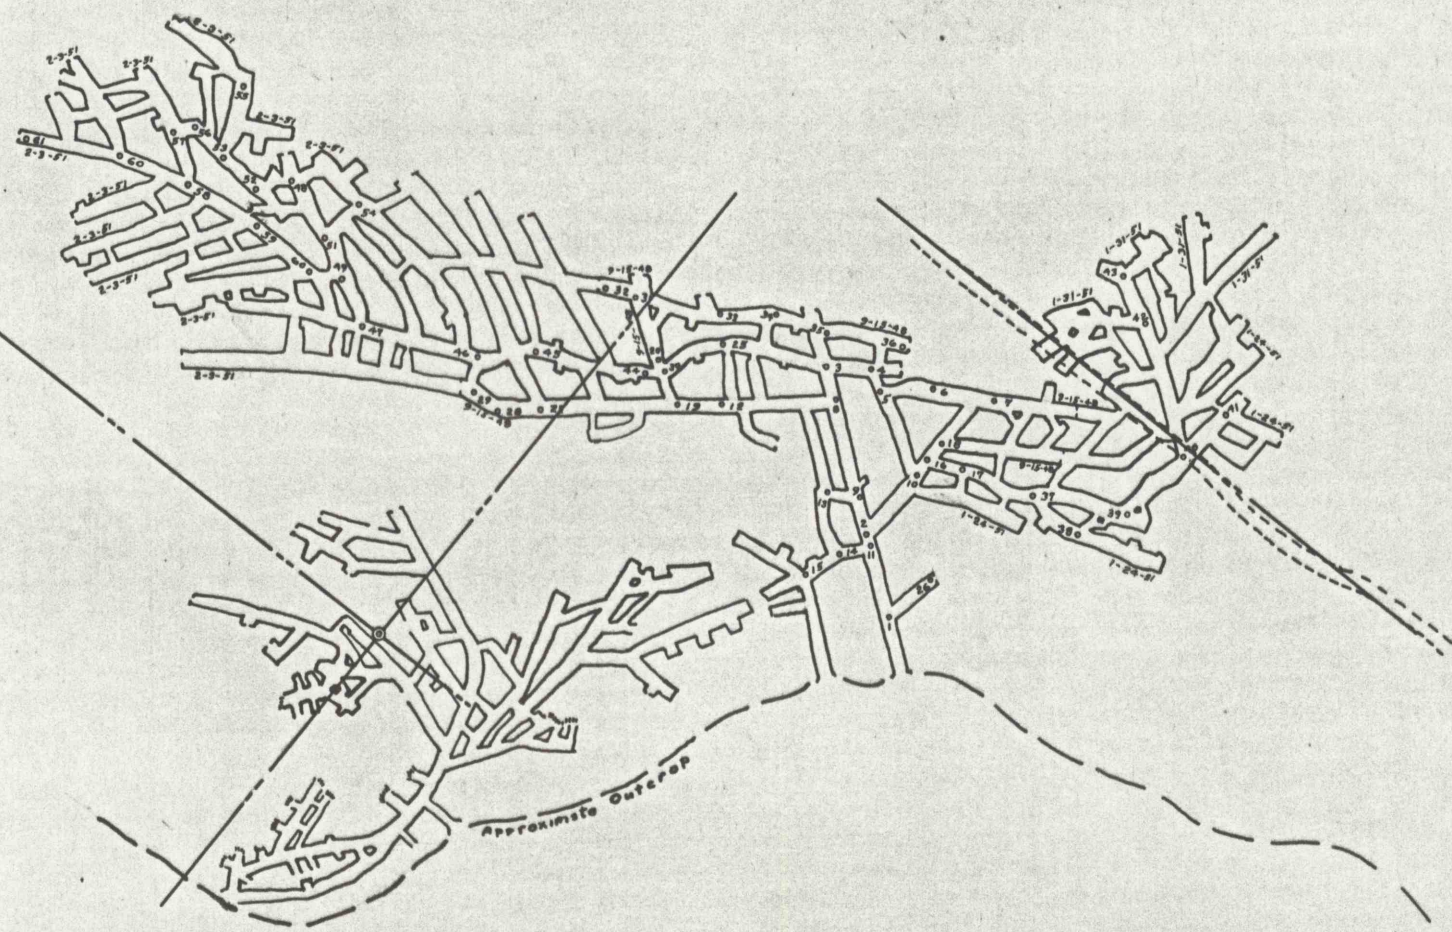

1-B-109

1-B-109