


A-79

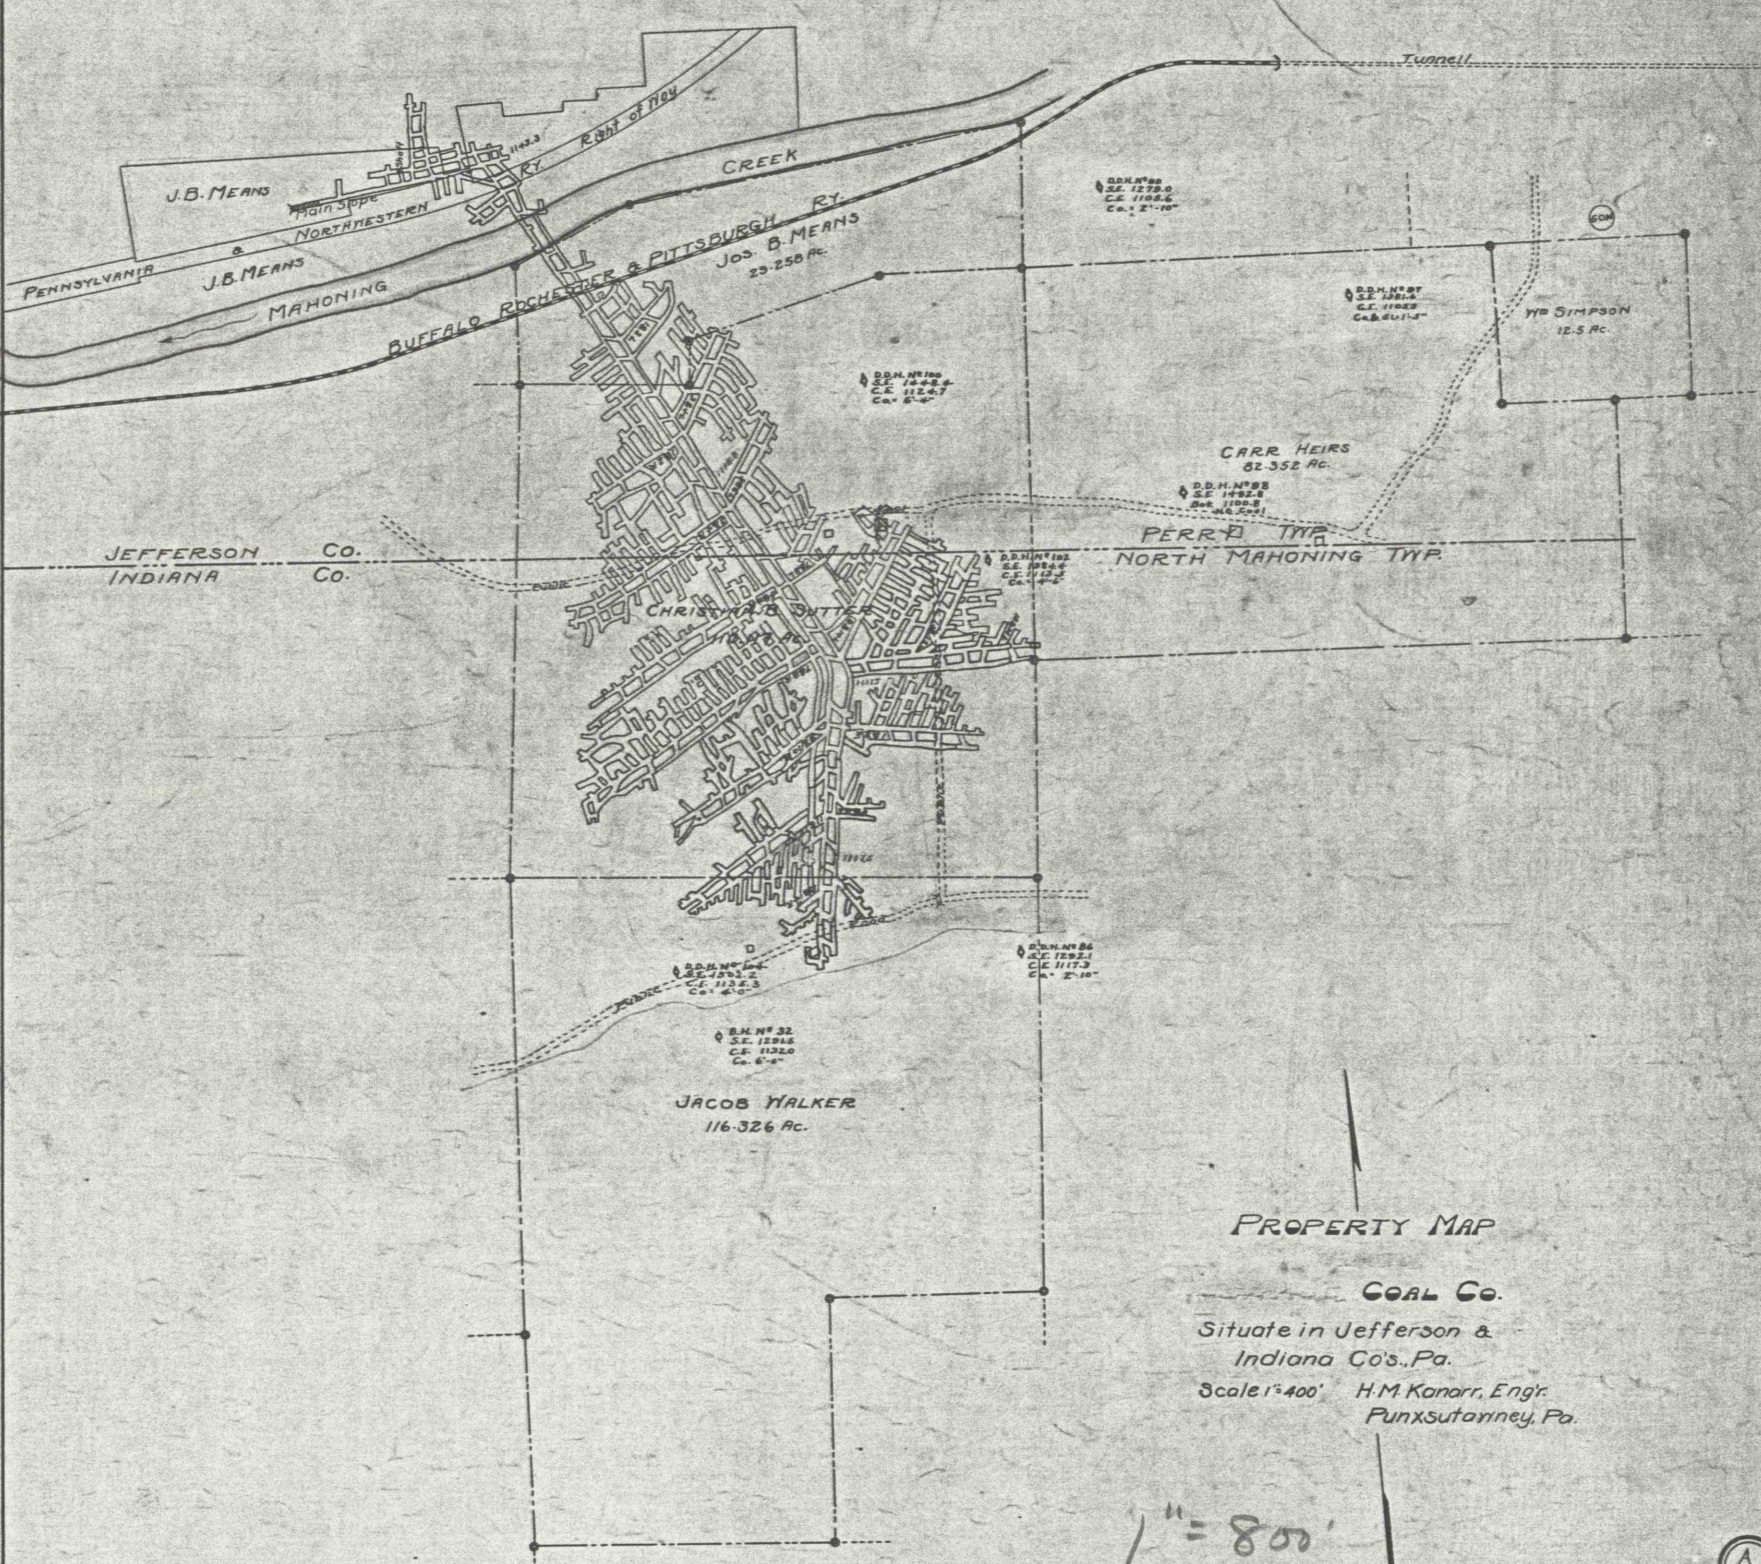

PROPERTY MAP

COAL Co.
 Situate in Jefferson &
 Indiana Co's., Pa.
 Scale 1"=400' H.M. Kanarr, Engr.
 Punxsutawney, Pa.

1" = 800'