


1-D-22

1-B-03

1-B-03

1-B-03

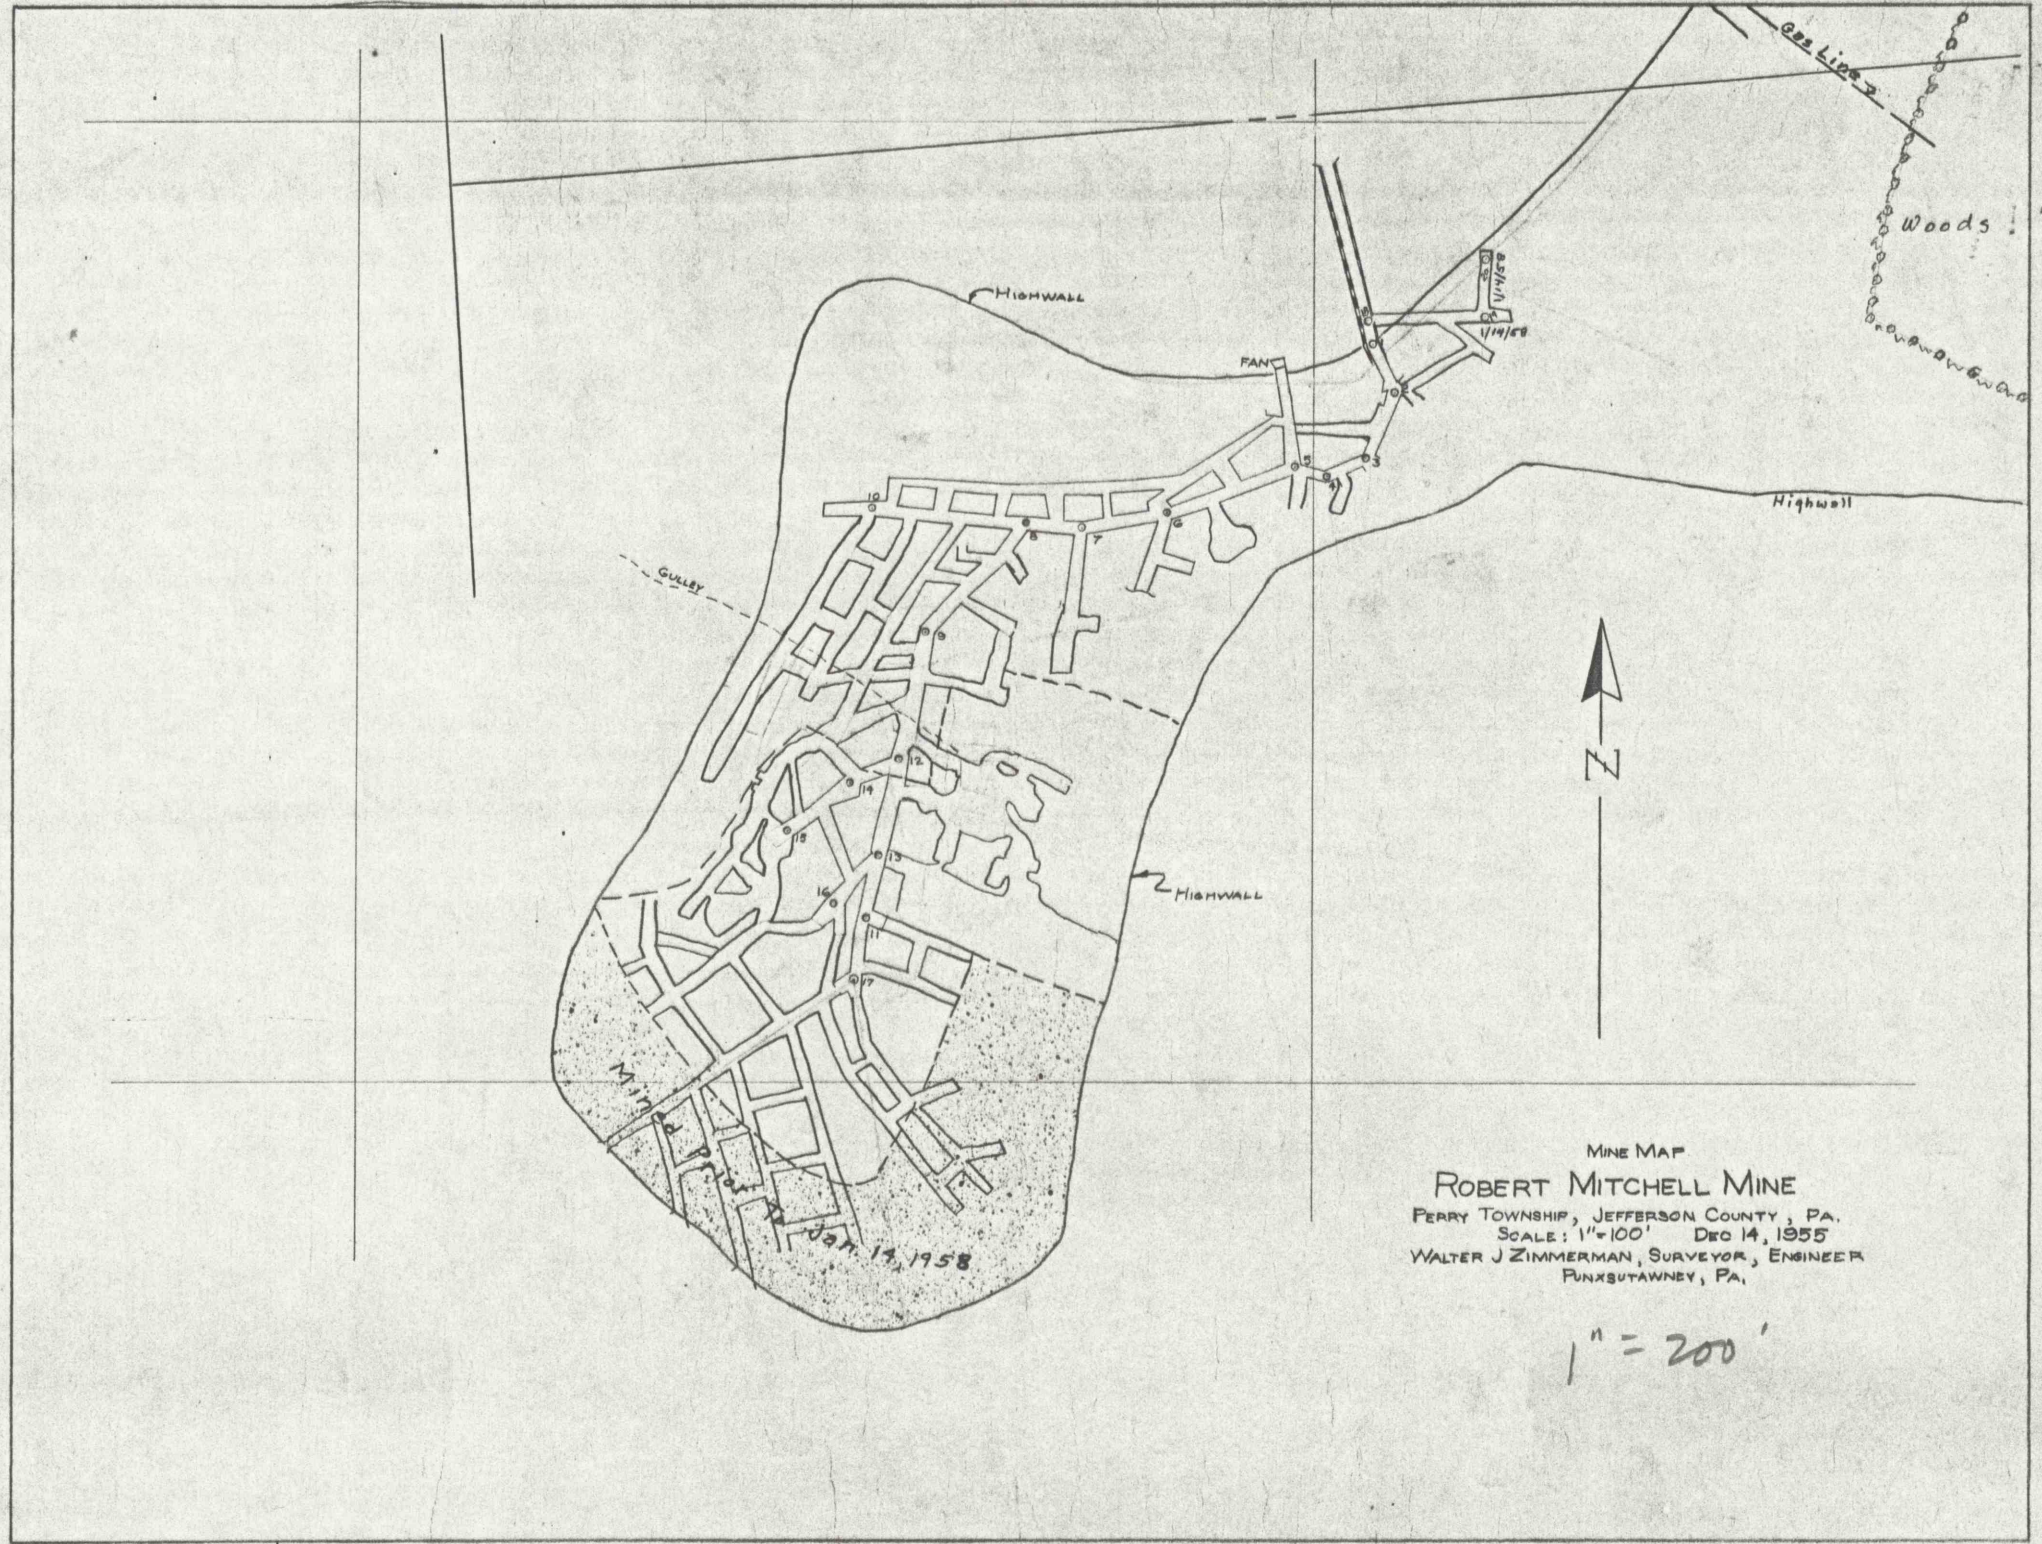

MINE MAP
ROBERT MITCHELL MINE
 PERRY TOWNSHIP, JEFFERSON COUNTY, PA.
 SCALE: 1"=100' DEC 14, 1955
 WALTER J ZIMMERMAN, SURVEYOR, ENGINEER
 PUNXSUTAWNEY, PA.

1" = 200'

1-B-03