

DENNISON

WORKED OUT

L. S. ROSS

Outcrop

Approximate

Actual

MINE MAP

OF THE


BLACK COAL CO.

Washington Trwp, Jeff Co., Pa.

Scale 1 in = 100 ft. H.M. Kanarr

Engr. Punxsutanney, Pa.

March 1922.

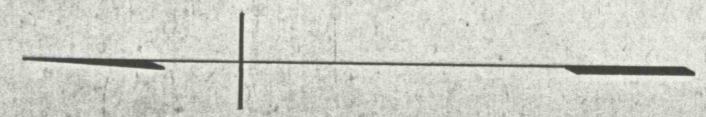

11-200'

