


ANDREW SMITH ESTATE

HUGH MILLEN

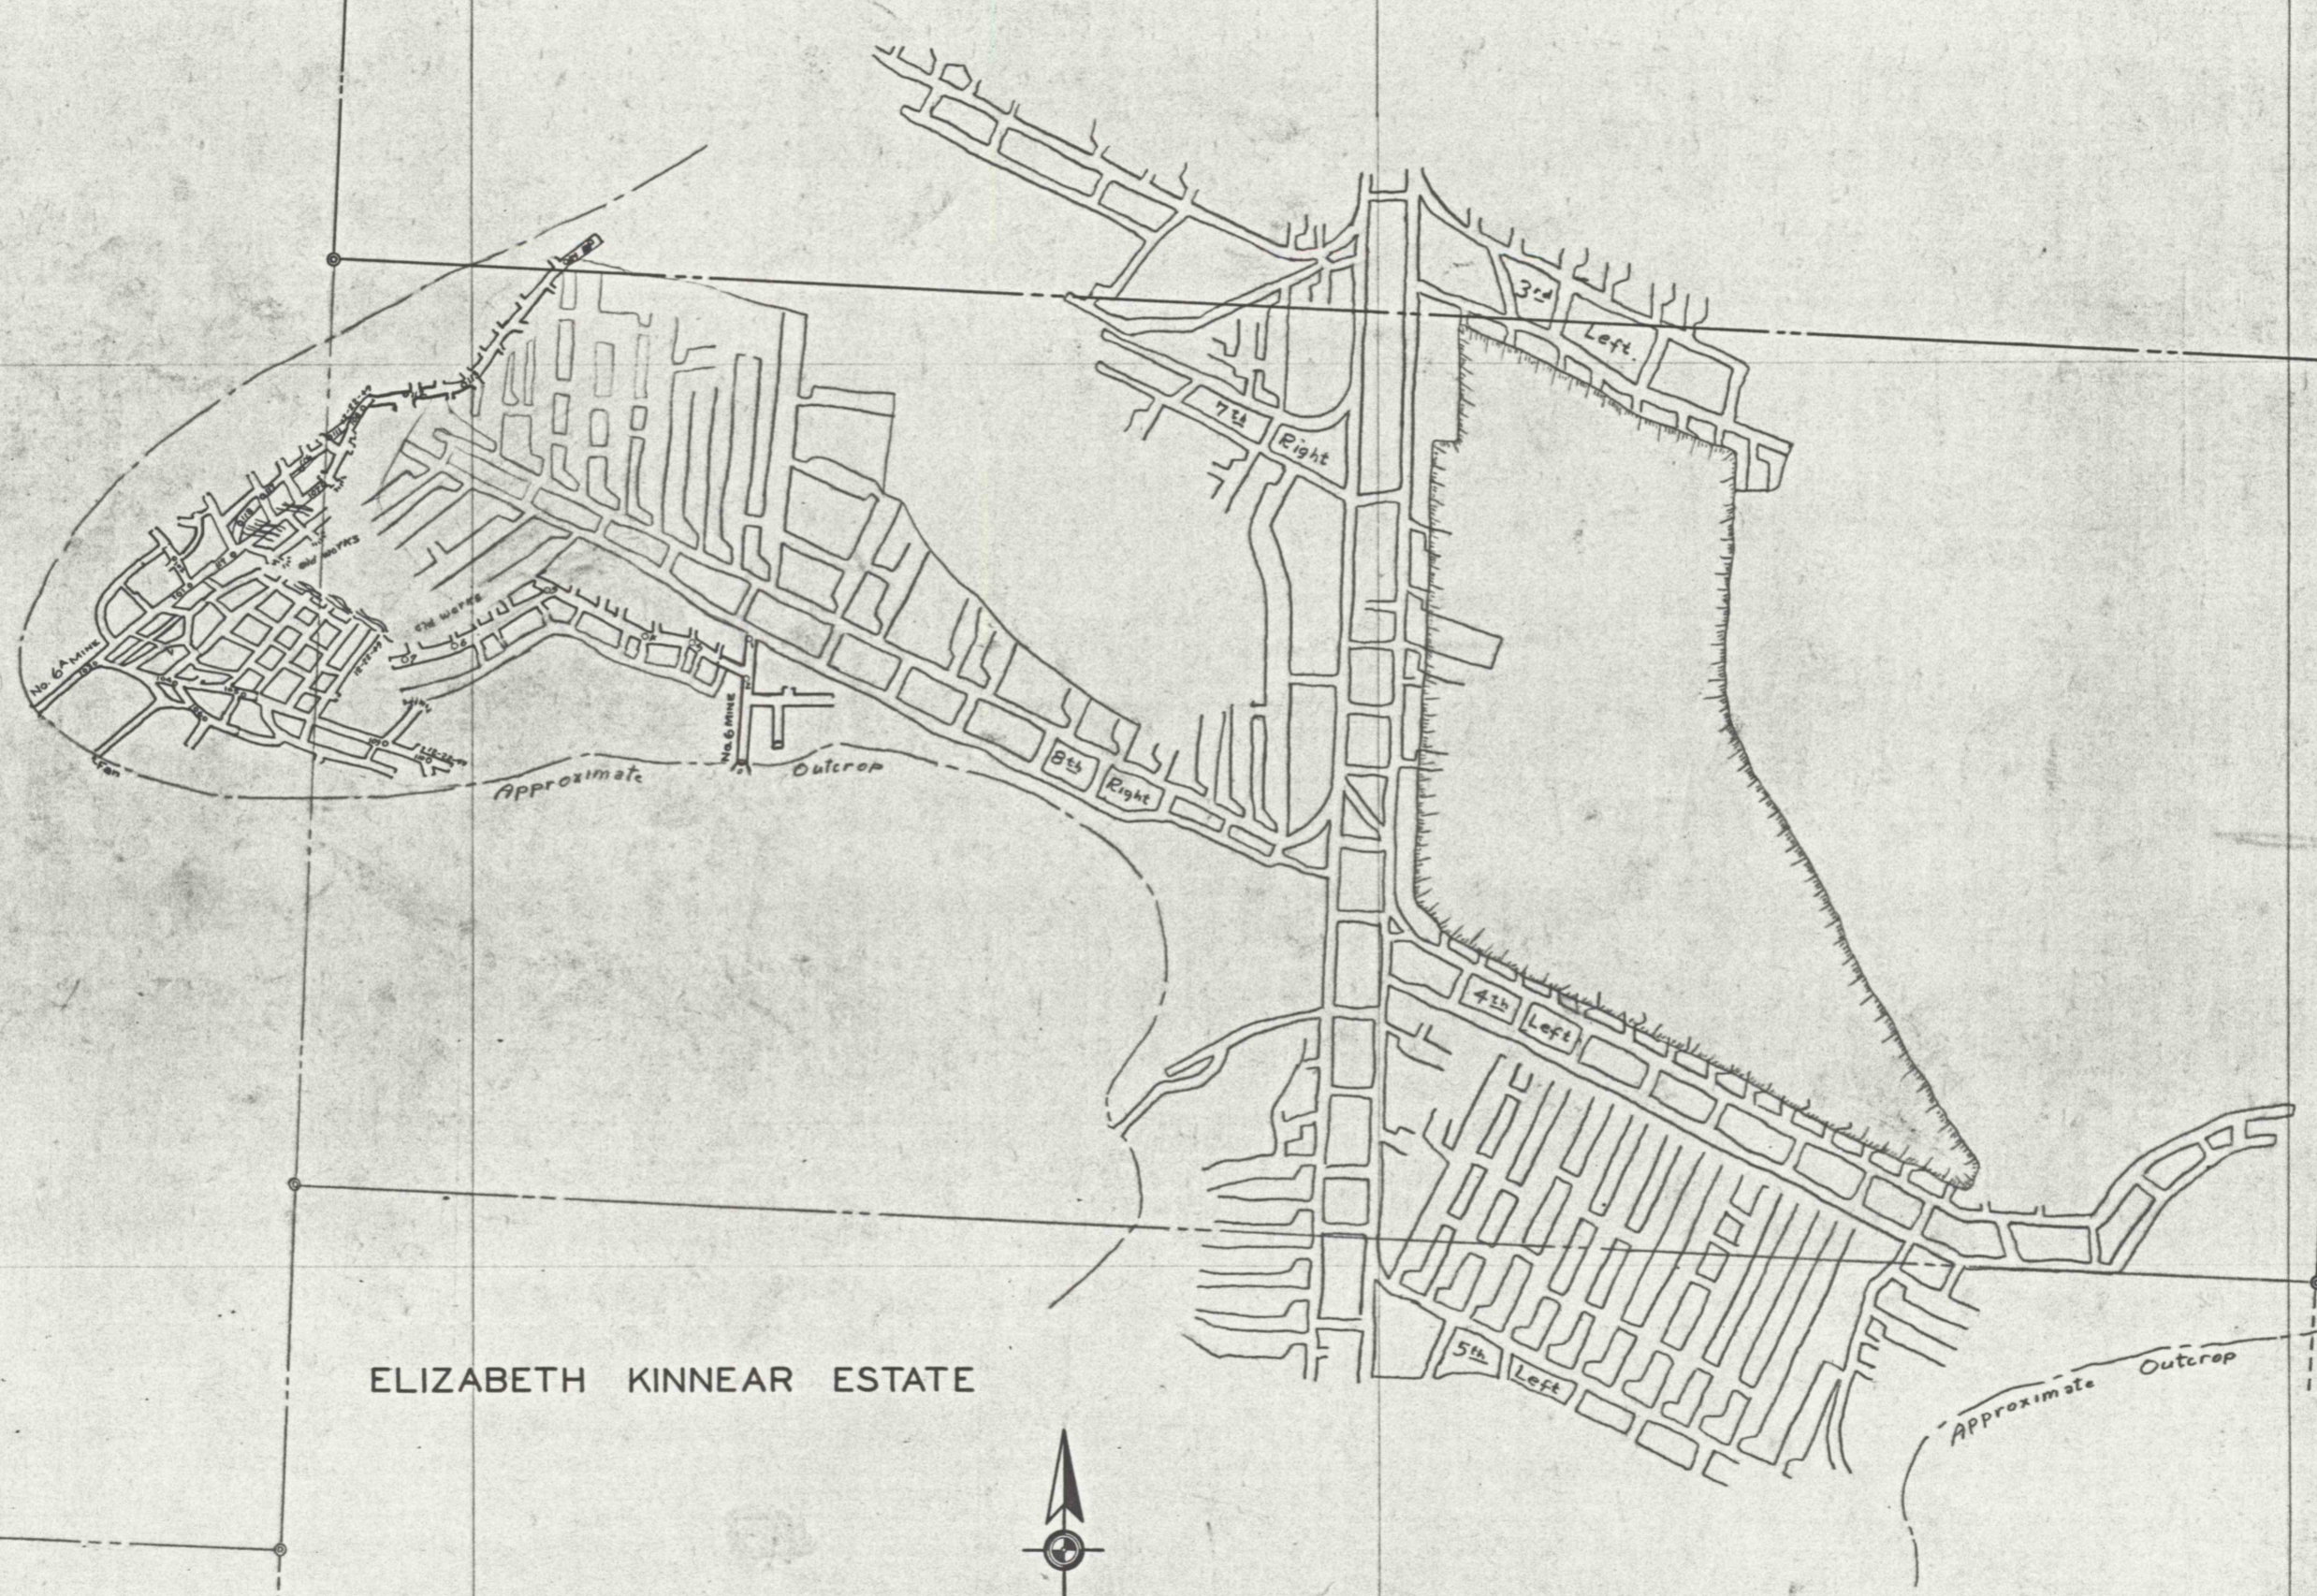

ELIZABETH KINNEAR ESTATE

SMATHERS

DATE OF LAST SURVEY
FEB. 4, 1948
DEC. 22, 1949

MAP OF
 R. A. BECKMAN
 COAL MINE NO. 6
 OLIVER TOWNSHIP, JEFFERSON COUNTY, PA.

WALTER J. ZIMMERMAN SURVEYOR PUNXSUTAWNEY, PA.

SCALE 1 INCH = 100 FEET

1" = 200'

1-B-88

29-19-195