


JESSE MARTZ

JOHN H. MILLIRON

C. MILLIRON

SARAH HOWARD

J. M. SHAFFER

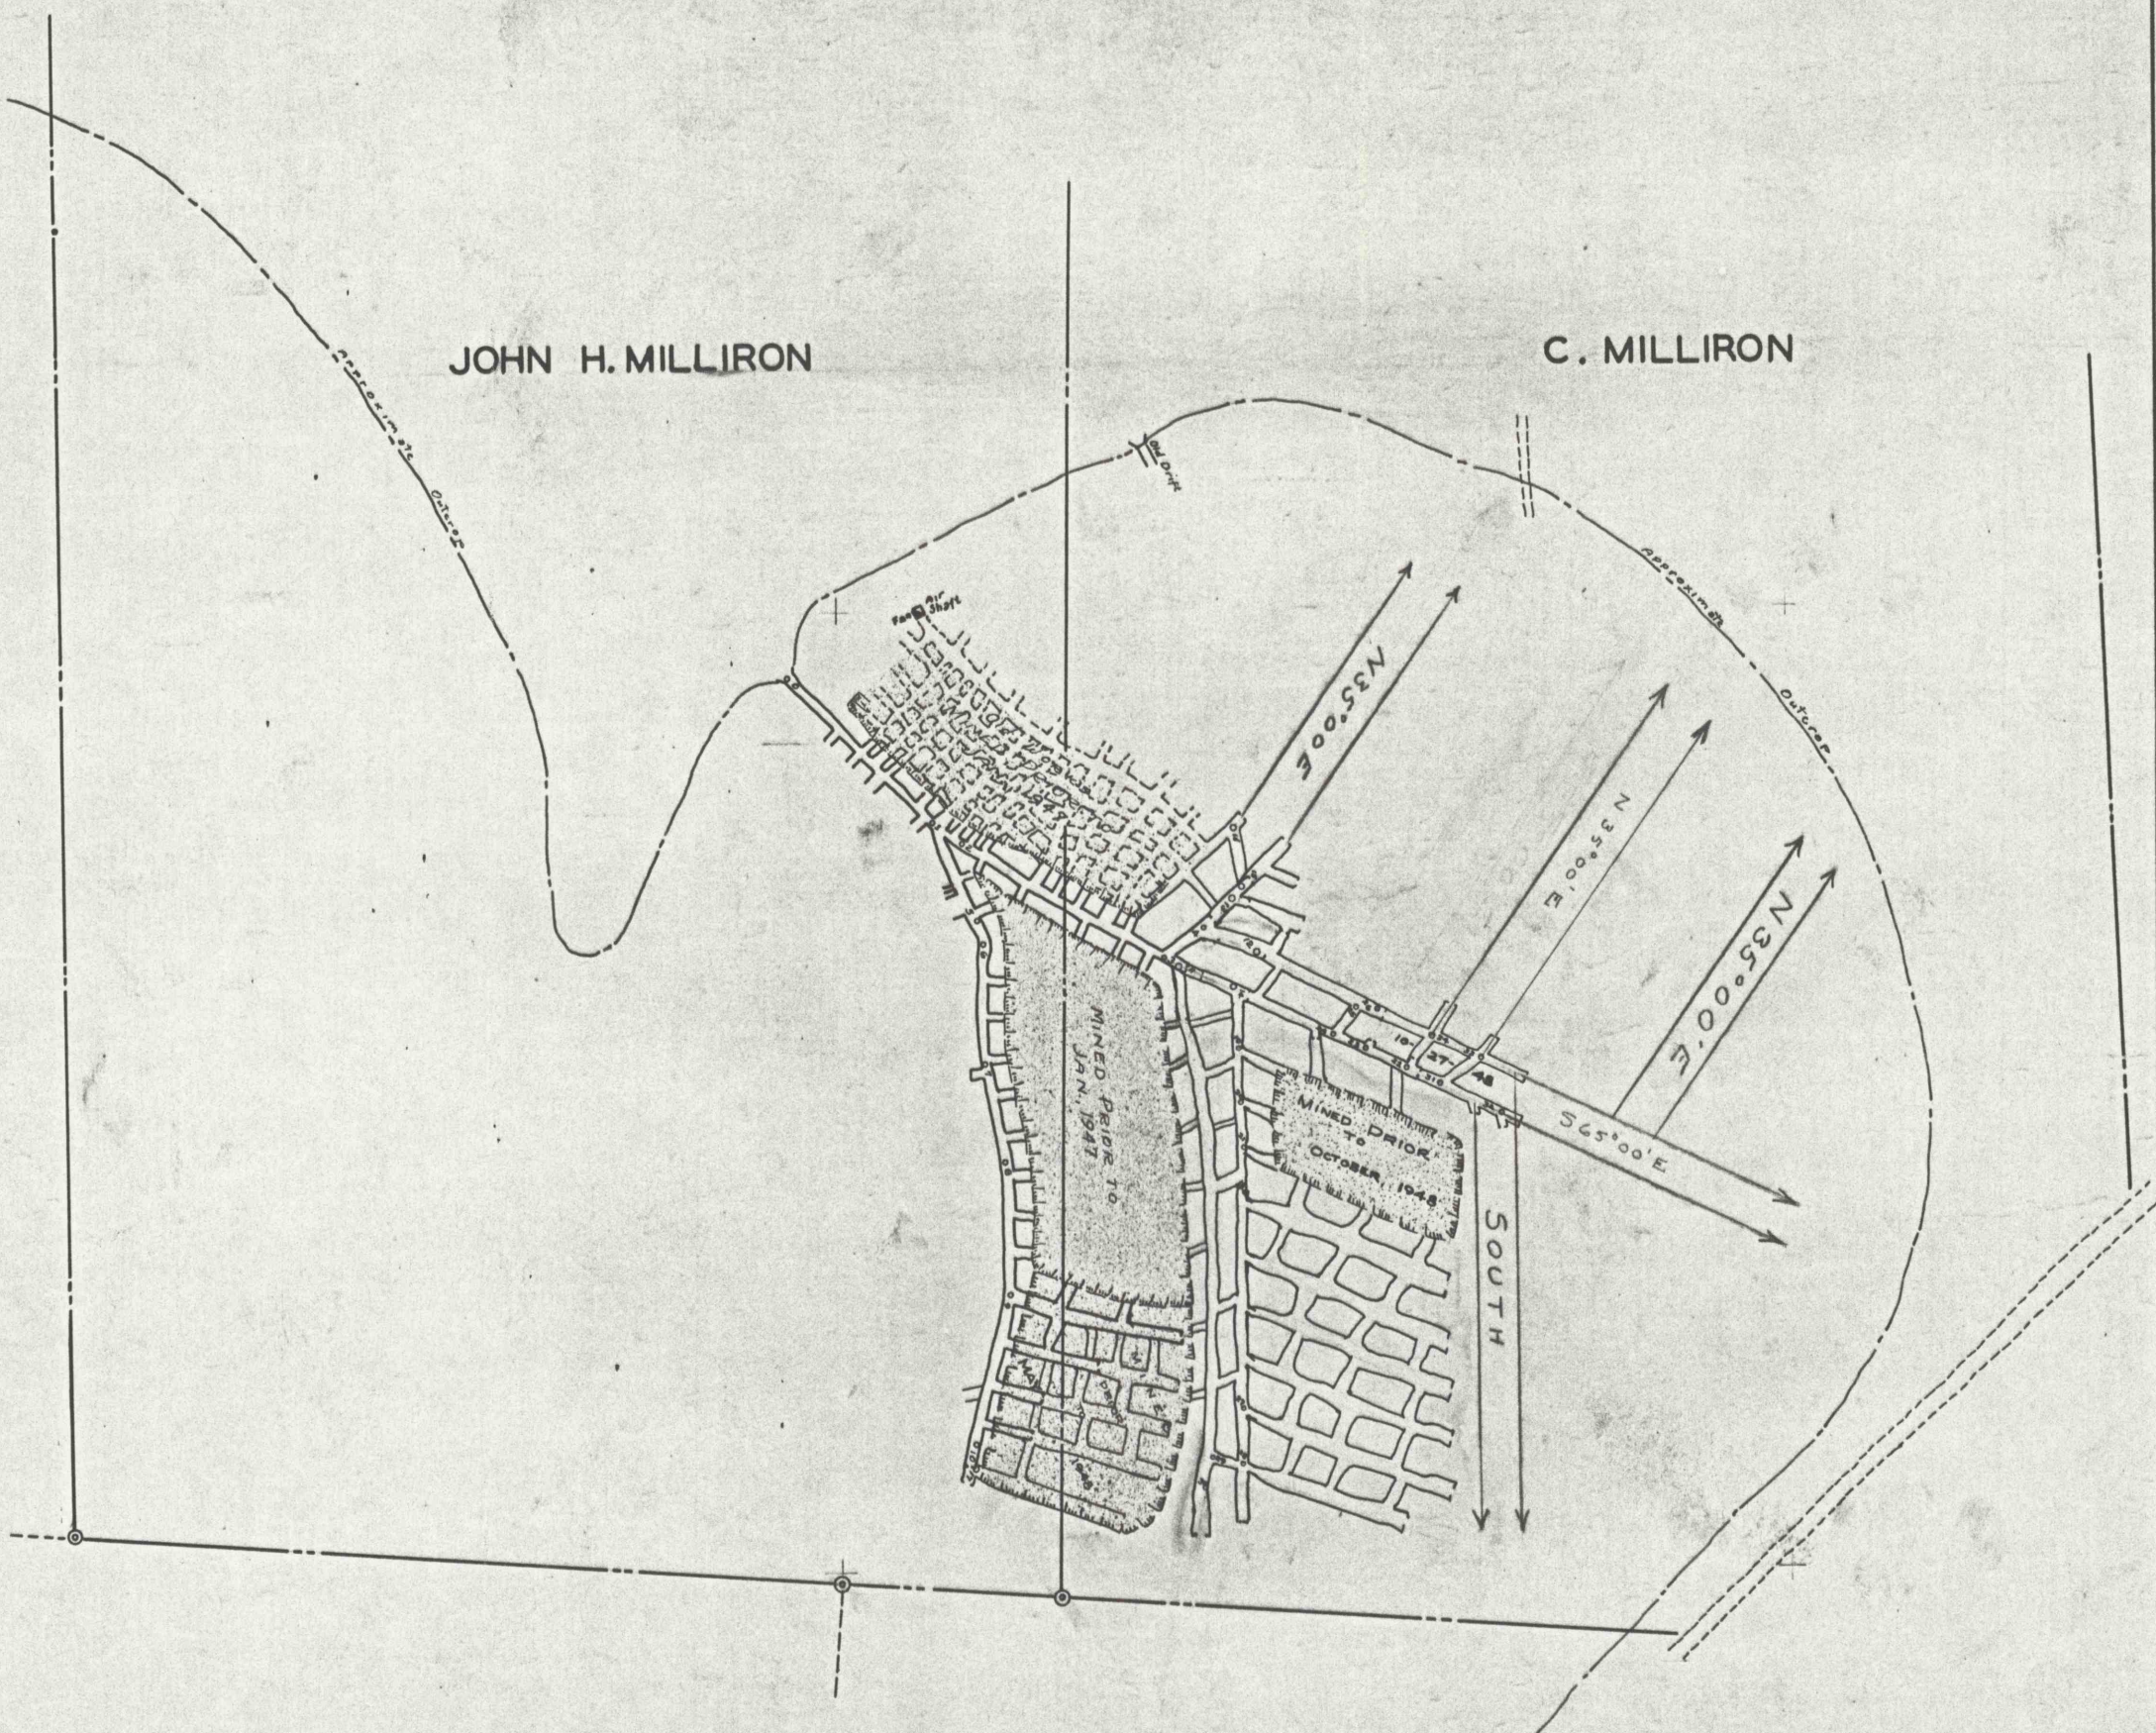

**BYRON MILLIRON
MINE**

PORTER TOWNSHIP, JEFFERSON COUNTY, PA.

SCALE: 1 IN=100 FT.

JAN., 1947

WALTER J. ZIMMERMAN

SURVEYOR, PUNXSUTAWNEY, PA.

1" = 200'