

BARNETTE

Mined Prior to Jan. 28, 1953

Highwall 2  
Auger Mined By Others

Mined Prior to Oct. 18, 1955  
Mined Prior to Oct. 18, 1955

Mined Prior to Oct. 18, 1955  
March 23, 1954

MINED OUT PRIOR TO AUG. 27, 1952

Mined out Prior to March 23, 1954

MINED OUT PRIOR TO AUG. 27, 1952

MINED OUT PRIOR TO AUG. 27, 1952

RAYBUCK

Mined Prior to Jan. 28, 1953

MINED PRIOR

GEIST

GEIST

SPENCER AND MAUK COAL CO., INC.  
WORTHVILLE COAL CO. INC.  
MINE


WORTHVILLE COAL CO. INC.  
SURFACE

RINGGOLD TOWNSHIP, JEFFERSON COUNTY, PENNA.  
SCALE: ONE INCH = ONE HUNDRED FEET  
JULY, 1945

1" = 200'



BODDORF ESTATE

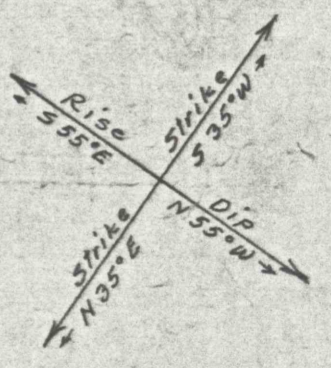

Date of Survey

July 11, 1953  
October 16, 1955

MINED  
1-B-119