


JAS. MEKEE HRS.

RESERVE

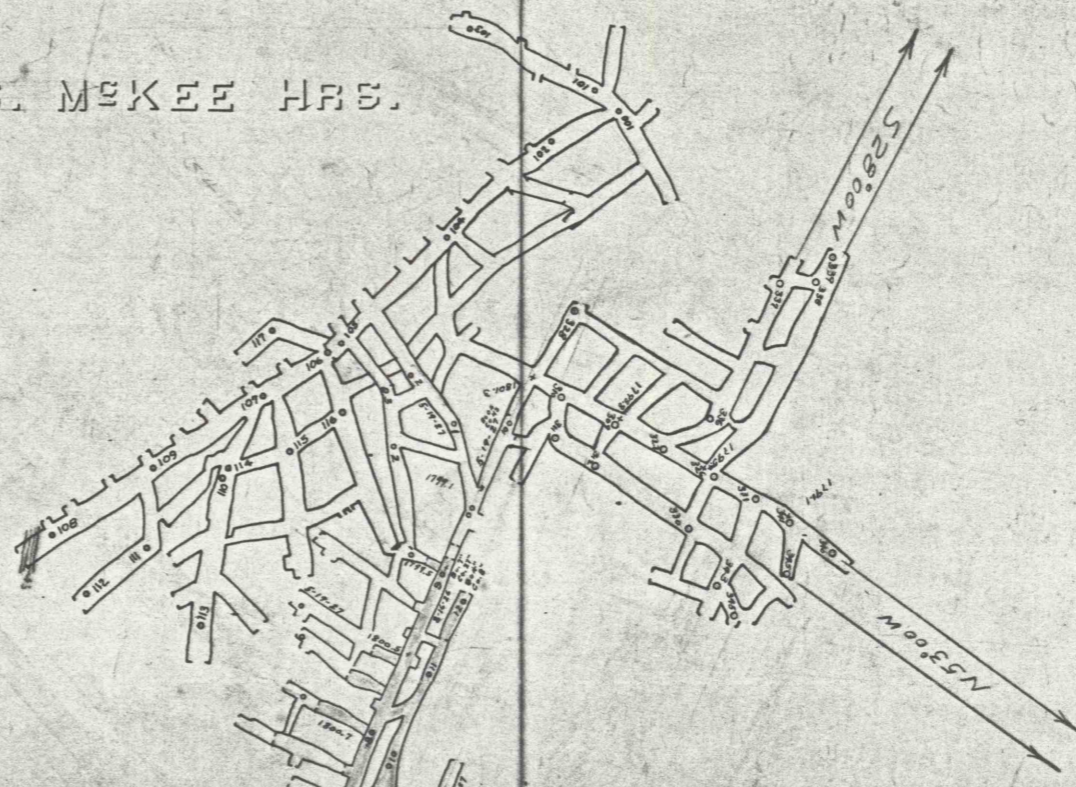

# MINE MAP

OF

## PRATT COAL CO.

Scale 1"=100'  

H.M. Kanarr  
Engineer

1"=200'

