


PAVING AND SITE WORK

PENIT CENTRAL

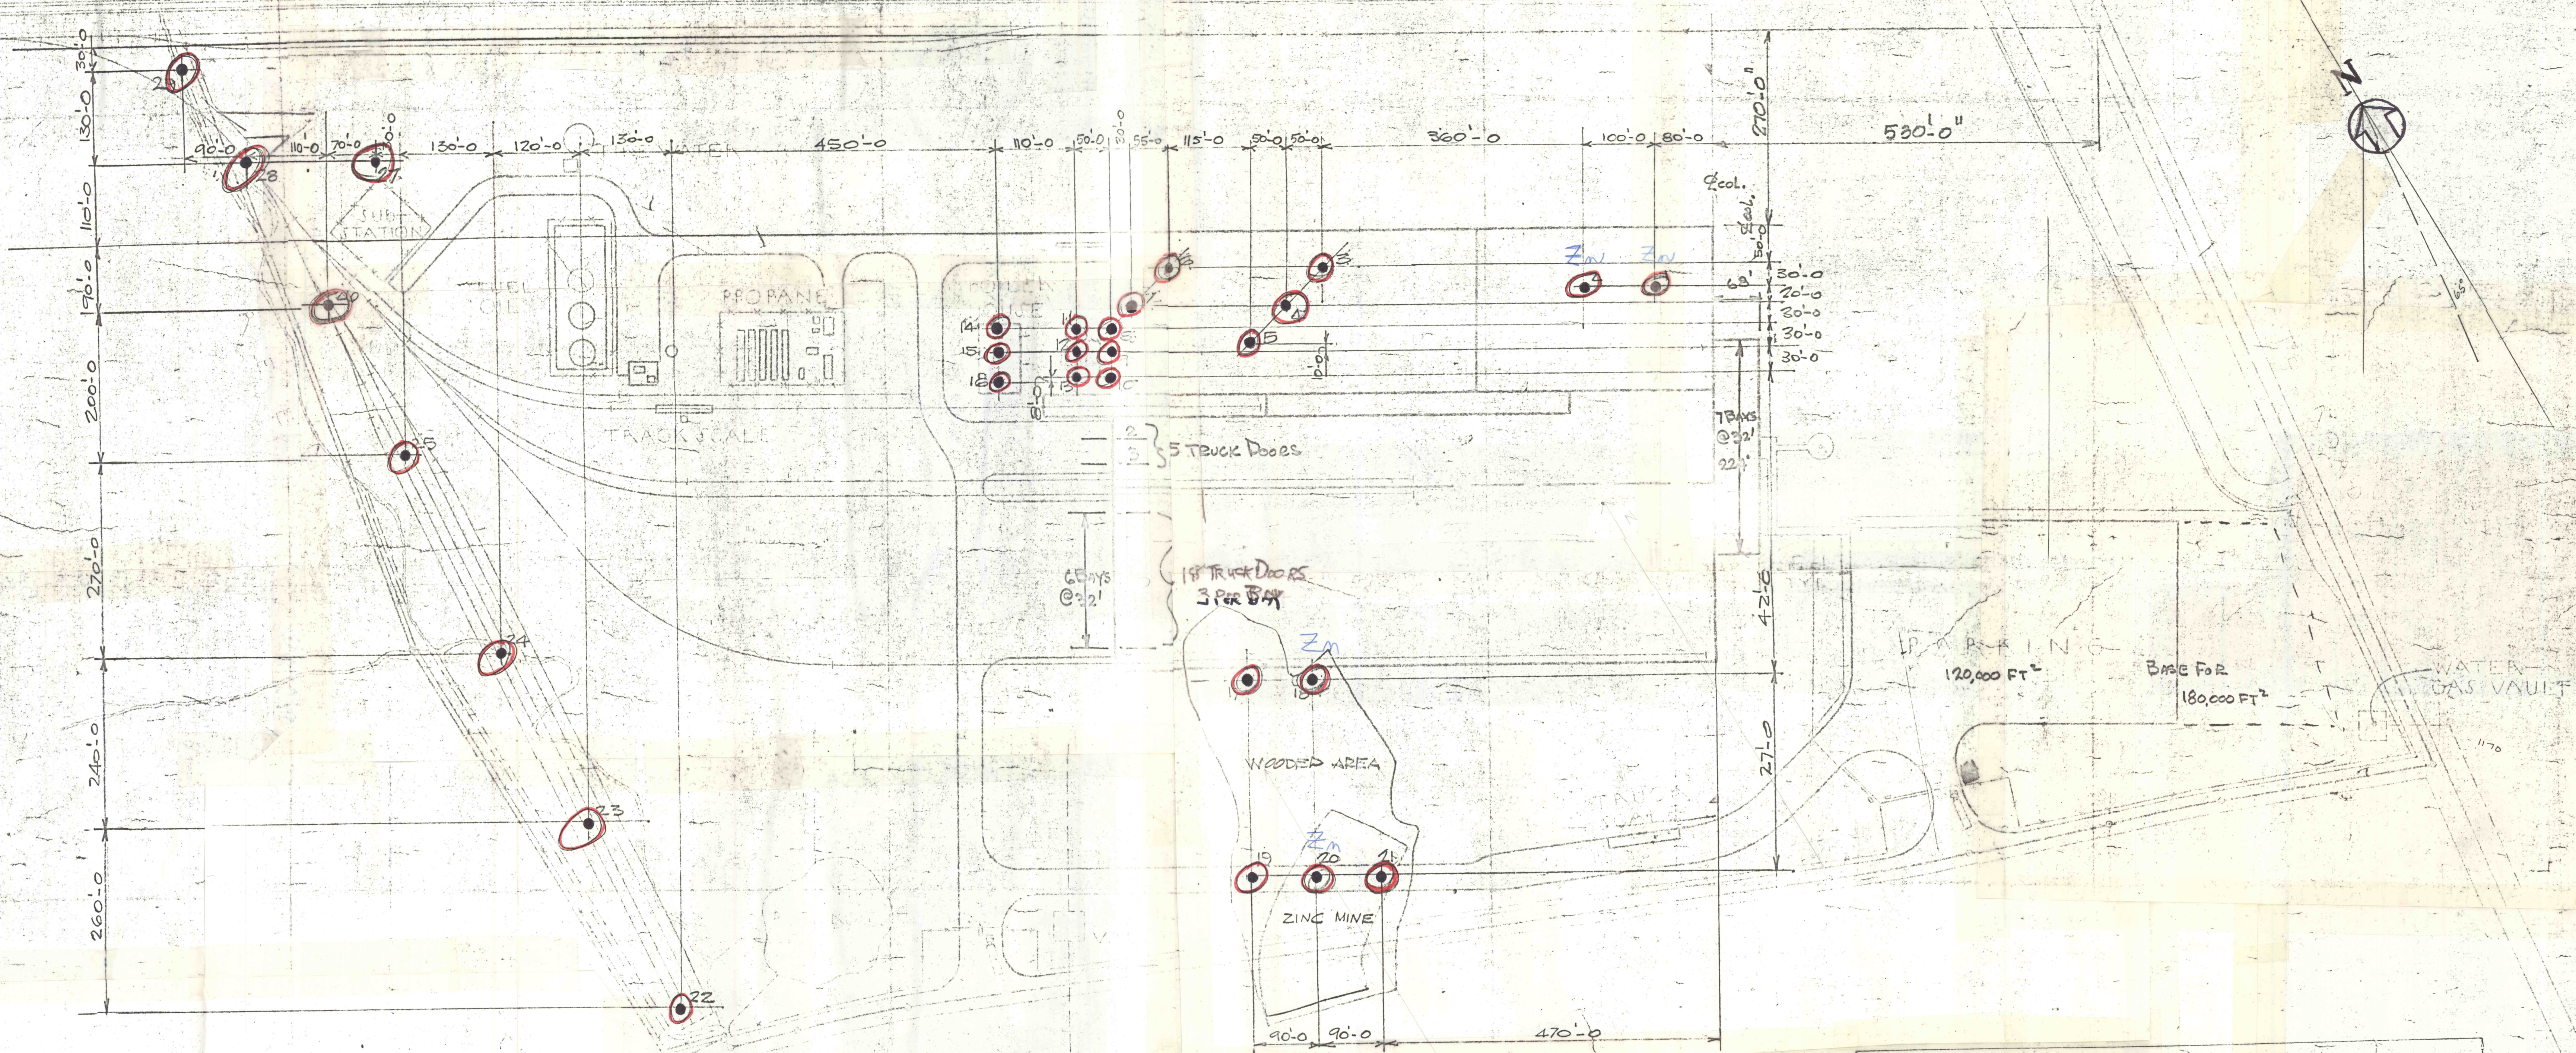

SOIL BORING LOCATION DIAGRAM

3.25.1974

NEW BORINGS TO BE DRILLED SHOWN THUS ○


SITE PLAN
 DENLINGER-SITE
 BREAKFAST FOOD MFG. PLANT
 LANCASTER, PENNSYLVANIA.

Kellogg Company
 BATTLE CREEK, MICHIGAN

3-25-74

SB-1