

FORMERLY VANPORT STONE NOW MEDUSA

587°16E 1411.67

DRILL
STEEL

IRON PIN

IRON PIN

FORMERLY MORROW NOW MEDUSA

MEDUSA

PUBLIC ROAD T-432

35 ACRES AFFECTED DURING 1964



HIGH WALL
TOP VEIN


HIGH WALL
TOP VEIN

AREA AFFECTED
35 ACRES

HIGH WALL - BOTTOM VEIN

TOE OF SLOPE

TOE OF SLOPE

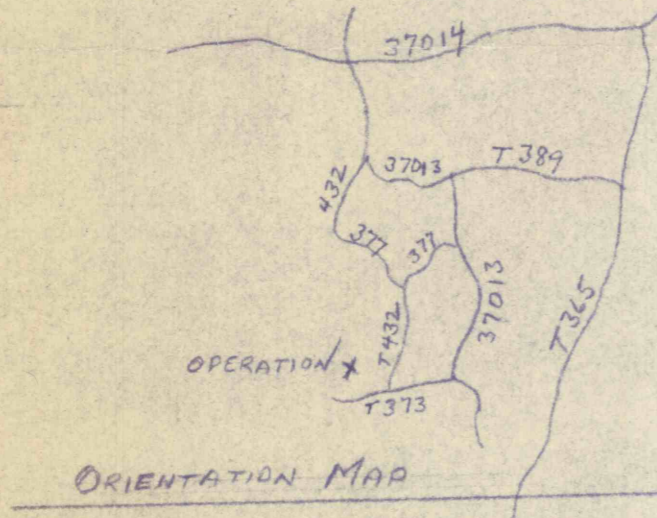

ORIENTATION MAP

MEDUSA

MEDUSA PORTLAND CEMENT CO

ANNUAL REPORT

SHENANGO TWP - LAWRENCE CO - PA

Scale 1:200 Jan 1965

W.L. Wilson, Engr

T-373

T-432

To 37013

309-