



North limit Folio E-6C

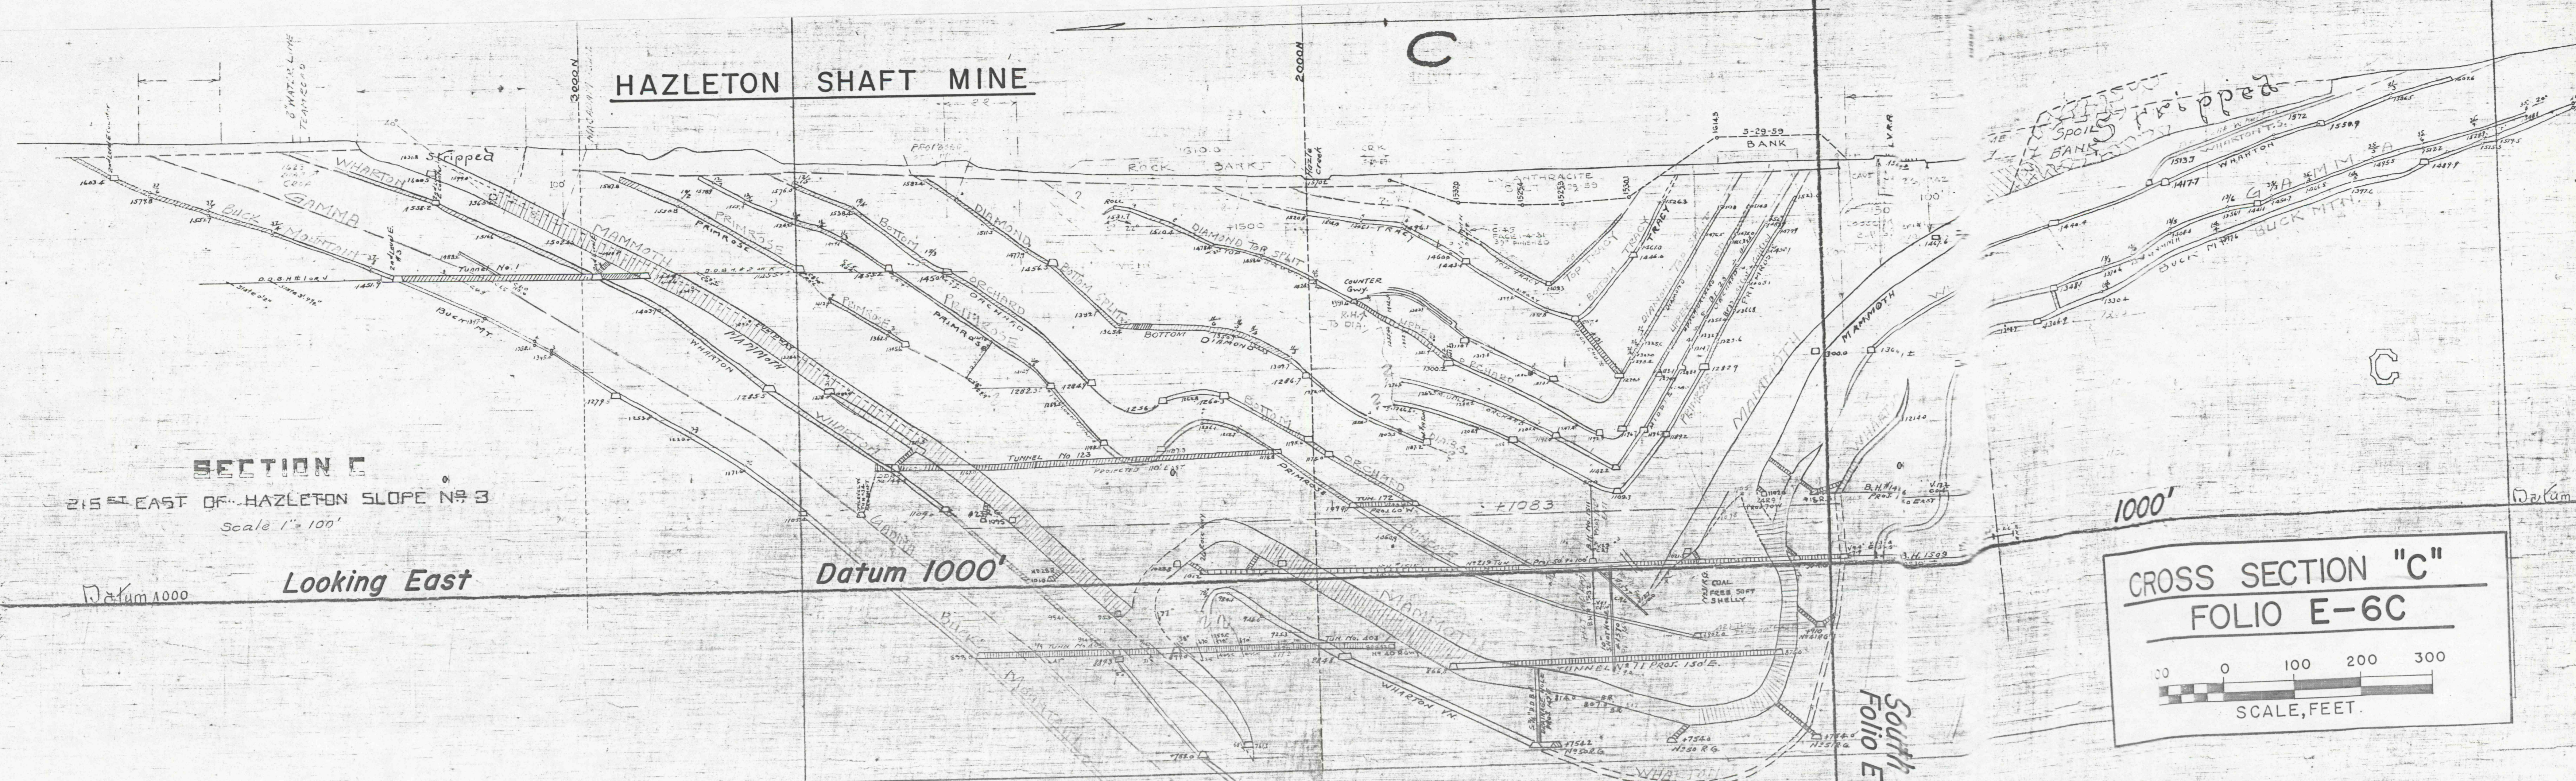

CROSS SECTION "C"
FOLIO E-6C
SCALE, FEET
0 100 200 300

North limit Folio E-6C

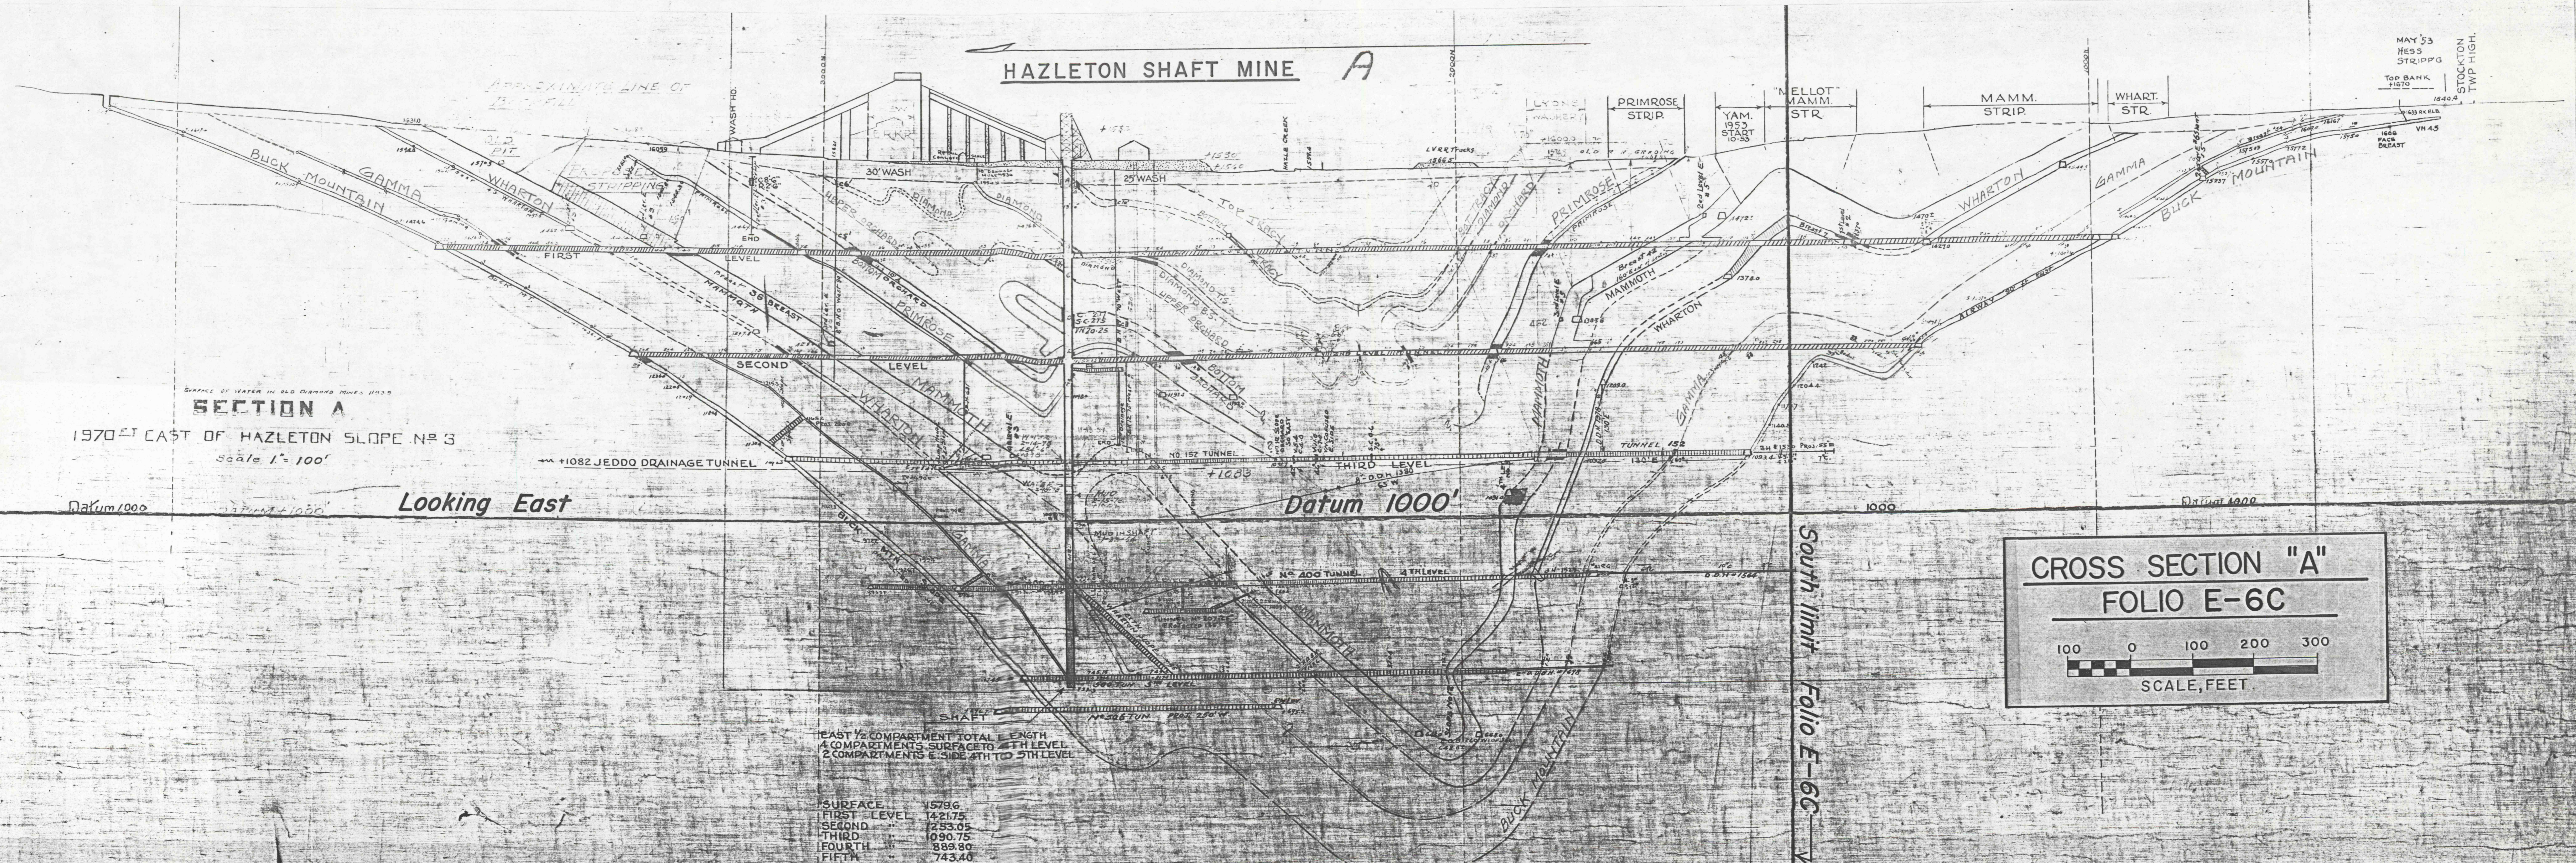

CROSS SECTION "A"
FOLIO E-6C
SCALE, FEET
0 100 200 300