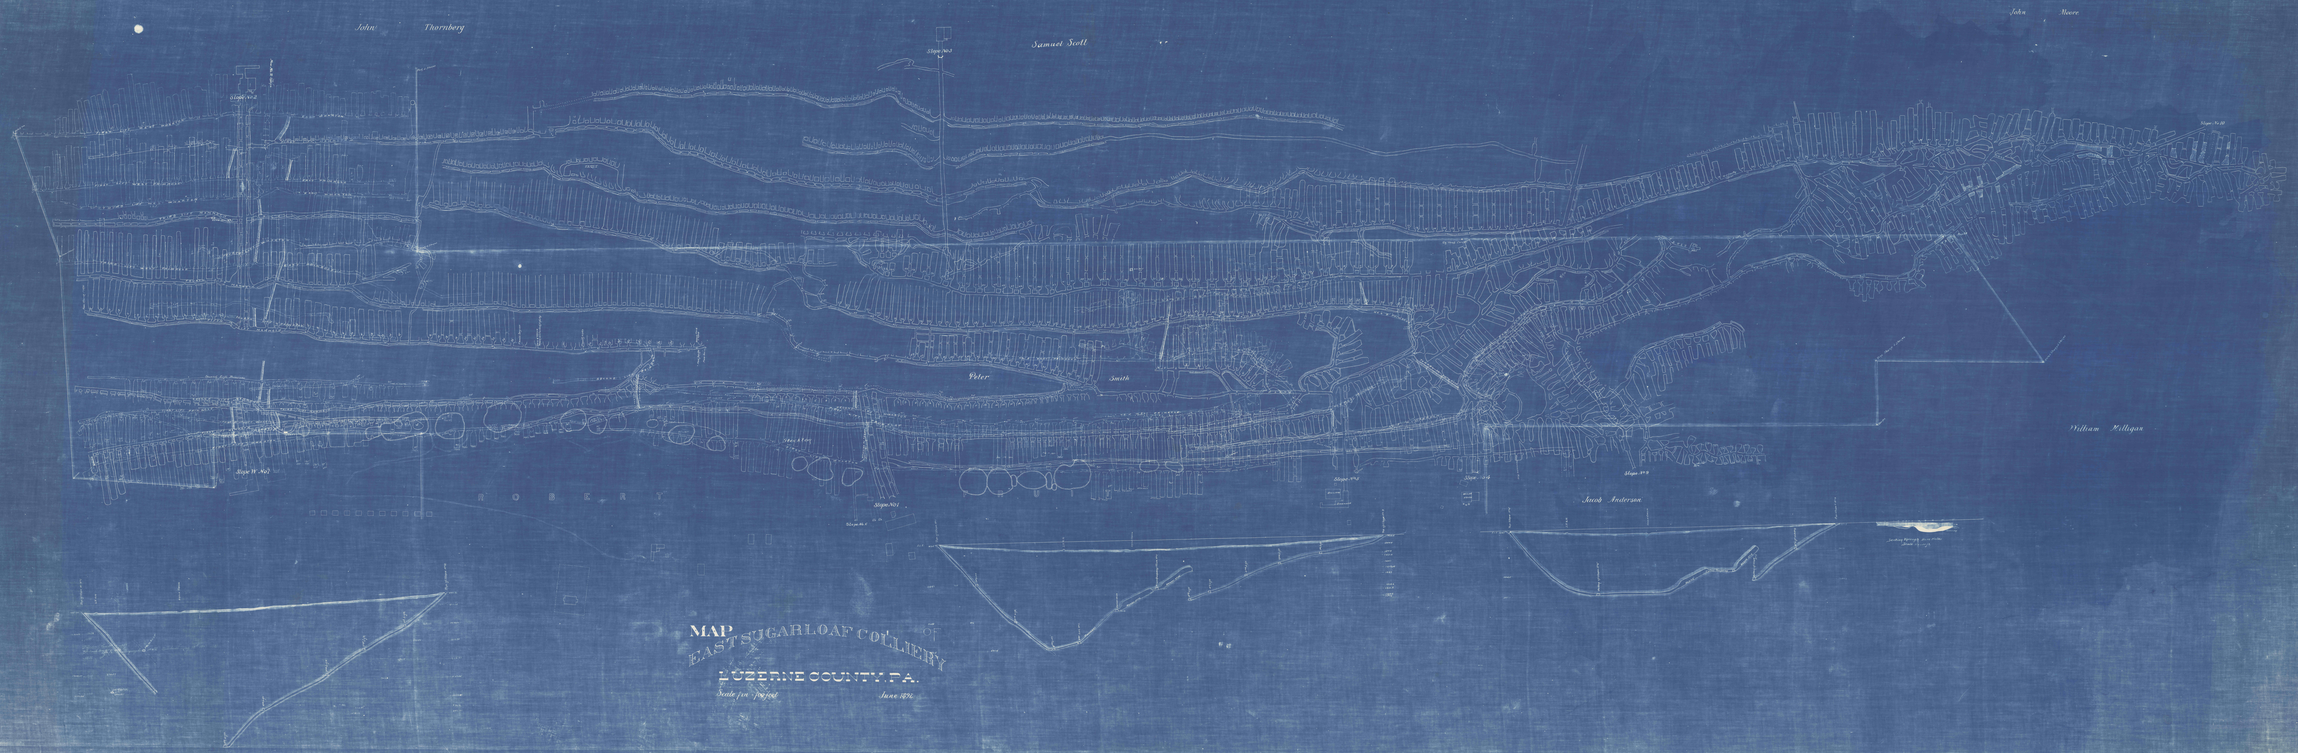


MAP
OF
EAST SUGARLOAF COLLIERY
LUZERNE COUNTY, PA.

Scale 100 - 1 inch June 1874