

*600' Marsh Check
700' Pattern*

Decallement


*Approximate
line of
X-section*

*250' and
Marsh Check
from Bergin I-Map*

*#1 P. Good
United Production Co. well
T.D. 7583'*

Mapped, edited, and published by the Geological Survey
Control by USGS and USC&GS
Topography from aerial photographs by multiplex methods
Aerial photographs taken 1942. Field check 1947
Polyconic projection. 1927 North American datum
10,000-foot grid based on Pennsylvania coordinate system,
north zone
Red tint indicates areas in which only
landmark buildings are shown
Contours in strip mine and mine dump areas
compiled from 1942 photography
1000-meter Universal Transverse Mercator grid ticks,
zone 18, shown in blue

TRIPLE NORTH
MAGNETIC NORTH
APPROXIMATE MEAN
DECLINATION, 1947

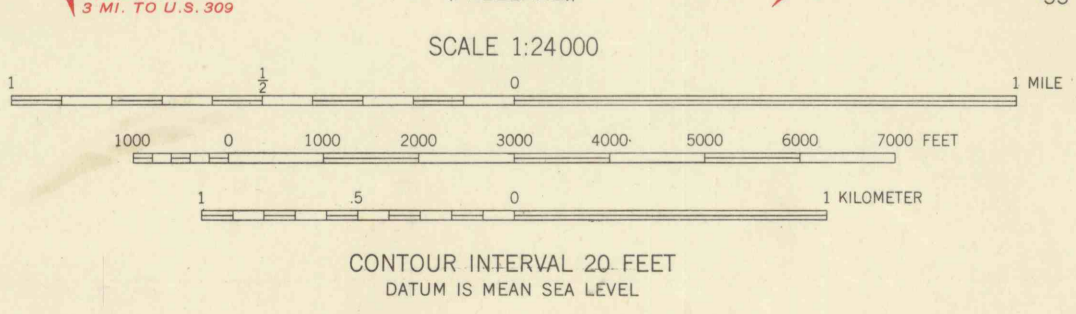

ROAD CLASSIFICATION

HARD-SURFACE ALL WEATHER ROADS	DRY WEATHER ROADS
Heavy-duty	IMPROVED DIRT
Medium-duty	UNIMPROVED DIRT
Loose-surface, graded, or narrow hard-surface	
U. S. Route	State Route

WILKES-BARRE WEST, PA.
NW/4 WILKES-BARRE 15' QUADRANGLE
N4107.5-W7552.5/7.5
1947

THIS MAP COMPLIES WITH NATIONAL MAP ACCURACY STANDARDS
FOR SALE BY U. S. GEOLOGICAL SURVEY, WASHINGTON 25, D. C.
A FOLDER DESCRIBING TOPOGRAPHIC MAPS AND SYMBOLS IS AVAILABLE ON REQUEST