
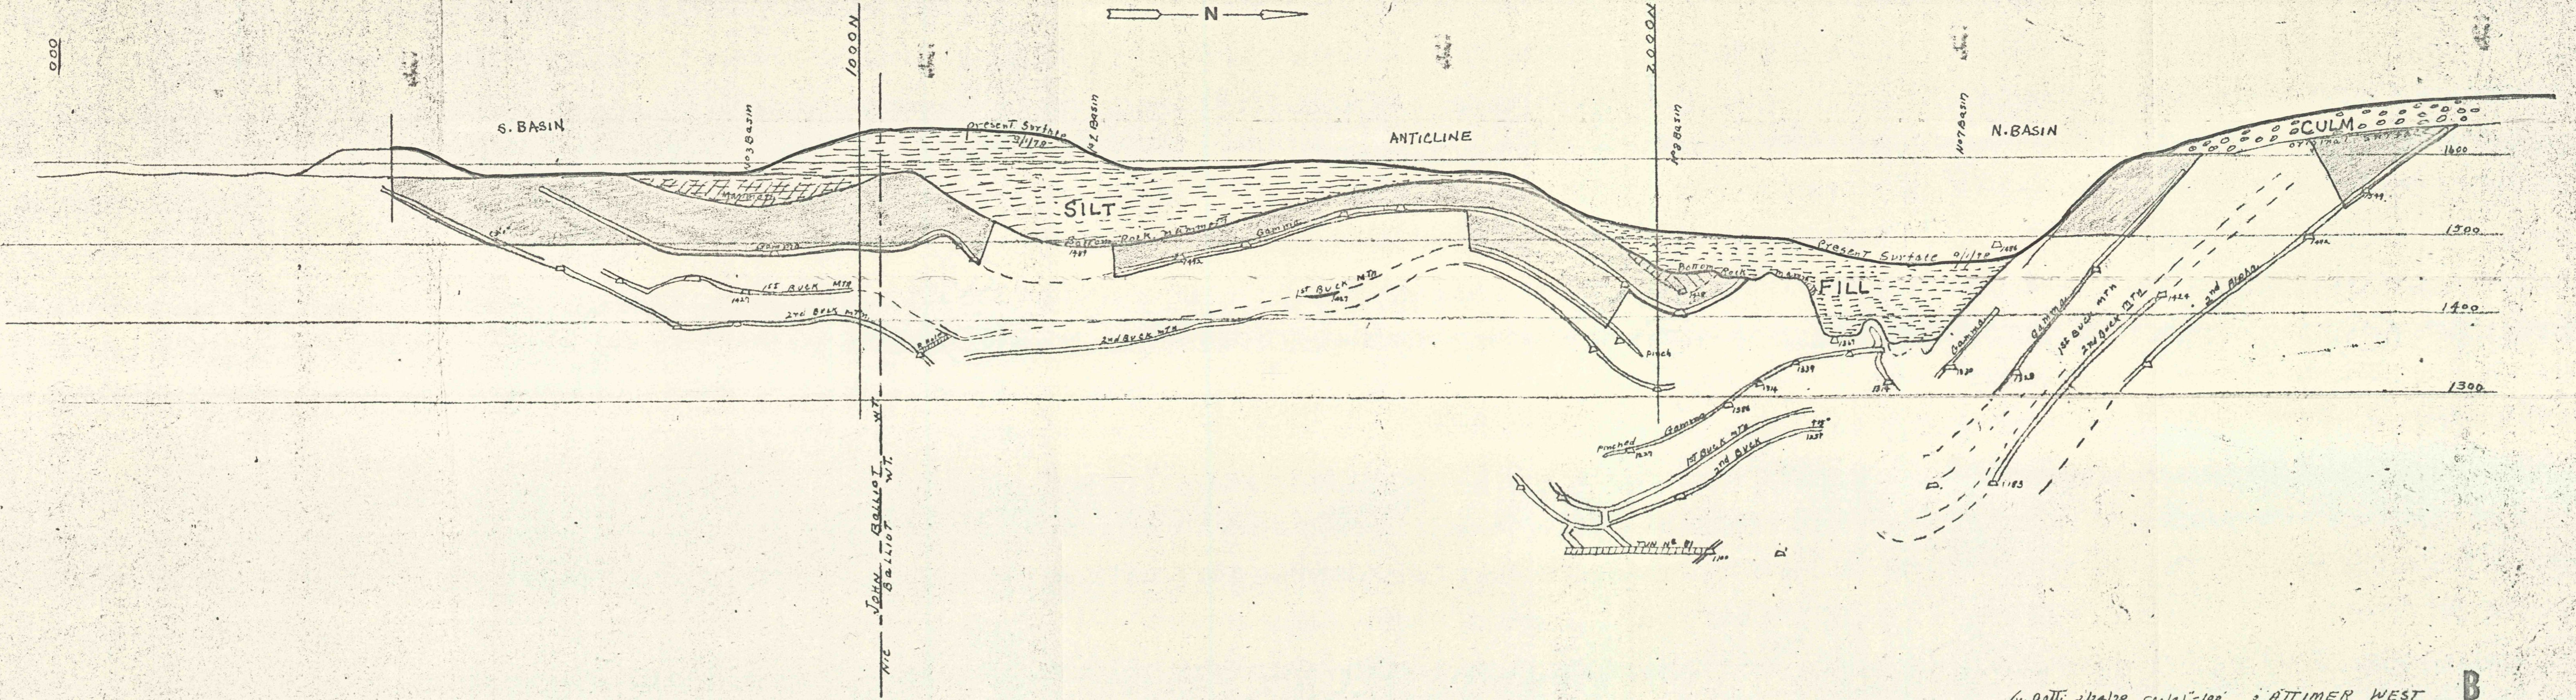


B

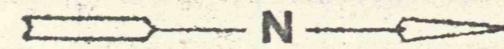

By Gatti 2/24/28 Scale 1"=100' ATTIMER WEST

B