


6792

WARRANT 4359

STATE GAME LANDS NO 75

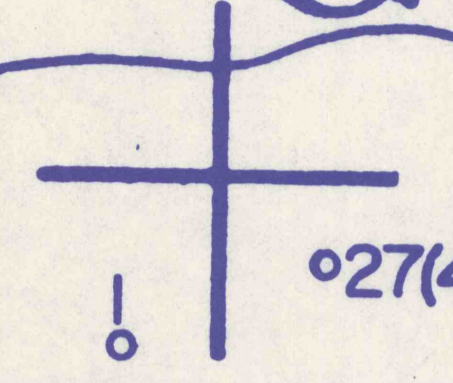

2A(3.4) 3A(3.5) 4A(4.7)

1A(3.0)

28° 27(4.6)

29(5.4)

36(5.5)

35(6.1)

34(5.3)

1600 33(3.2)

17(4.7)

18(5.2)

19(4.8)

31(3.7) 20

30(3.8)

21

26

23

16

22(5.2)

25(3.9)

14

15

11 13(5.6)

12

10(4.2)

24(5.0)

Strip Mine

Strip Mines

WARRANT 1632

WARRANT 1631

5A(6.3) APPROXIMATE DEEP

MINE LIMITS

LIMIT OF STRIP MINE OPERATIONS

8A

9A(6.2)

6A

7A

Strip Mines

1640

1598

R-i-d-g-e

* LIMIT OF STRIP MINE OPERATIONS