

1" = 400'

# Thomas Bros. Coal Mine


English Center PA.

Composite of January 1949 map  
and more recent undated map

By Glen Thomas

Original 1" = 100'

1" = 100' - Boyer Karte (after) 1957

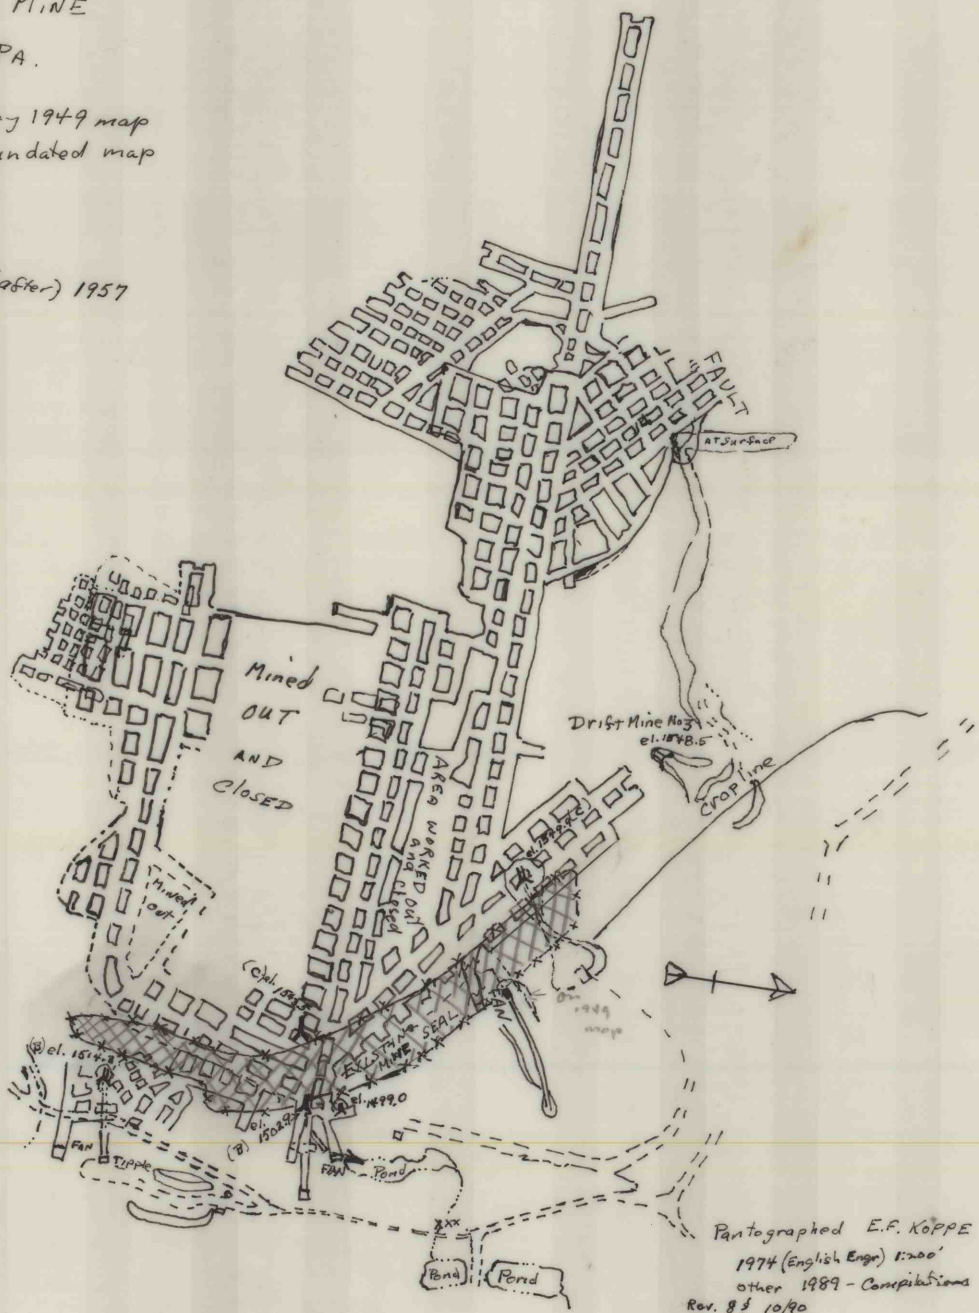

Composite of  
different maps  
(best fit)

Pantographed E.F. KOPPE  
1974 (English Engr) 1:200'  
other 1989 - Computations  
Rev. 8/10/90