

Warrant No 1582.

North

Location	Geological Section.
On Line H going south, Station 7, 700.	Top Covering 9' 1"
	Brown Slate
On Line D going south, Sta. 39, 55, thence west 100 feet.	Rock 36" 6 inches
	Dark Slate 1'-0"
	CUSHI VEIN 2' 5" coal
	Conglomerate 3' 10 Feet.
	Light colored sandy shale 1'-0"
	Black Slate 4'-6"
	White Fire Clay 3'-6"
	Black Slate 1'-5"
	Light blue Slate 13' 8"
	Black Slate 1'-4"
BLOSS VEIN 5' 4" coal	
On Line B going south, Sta. 15, 35, thence west 200'	Fine Clay 3'-0"
	Light colored Slate 13 feet
	Lower Conglomerate

Scale of Section

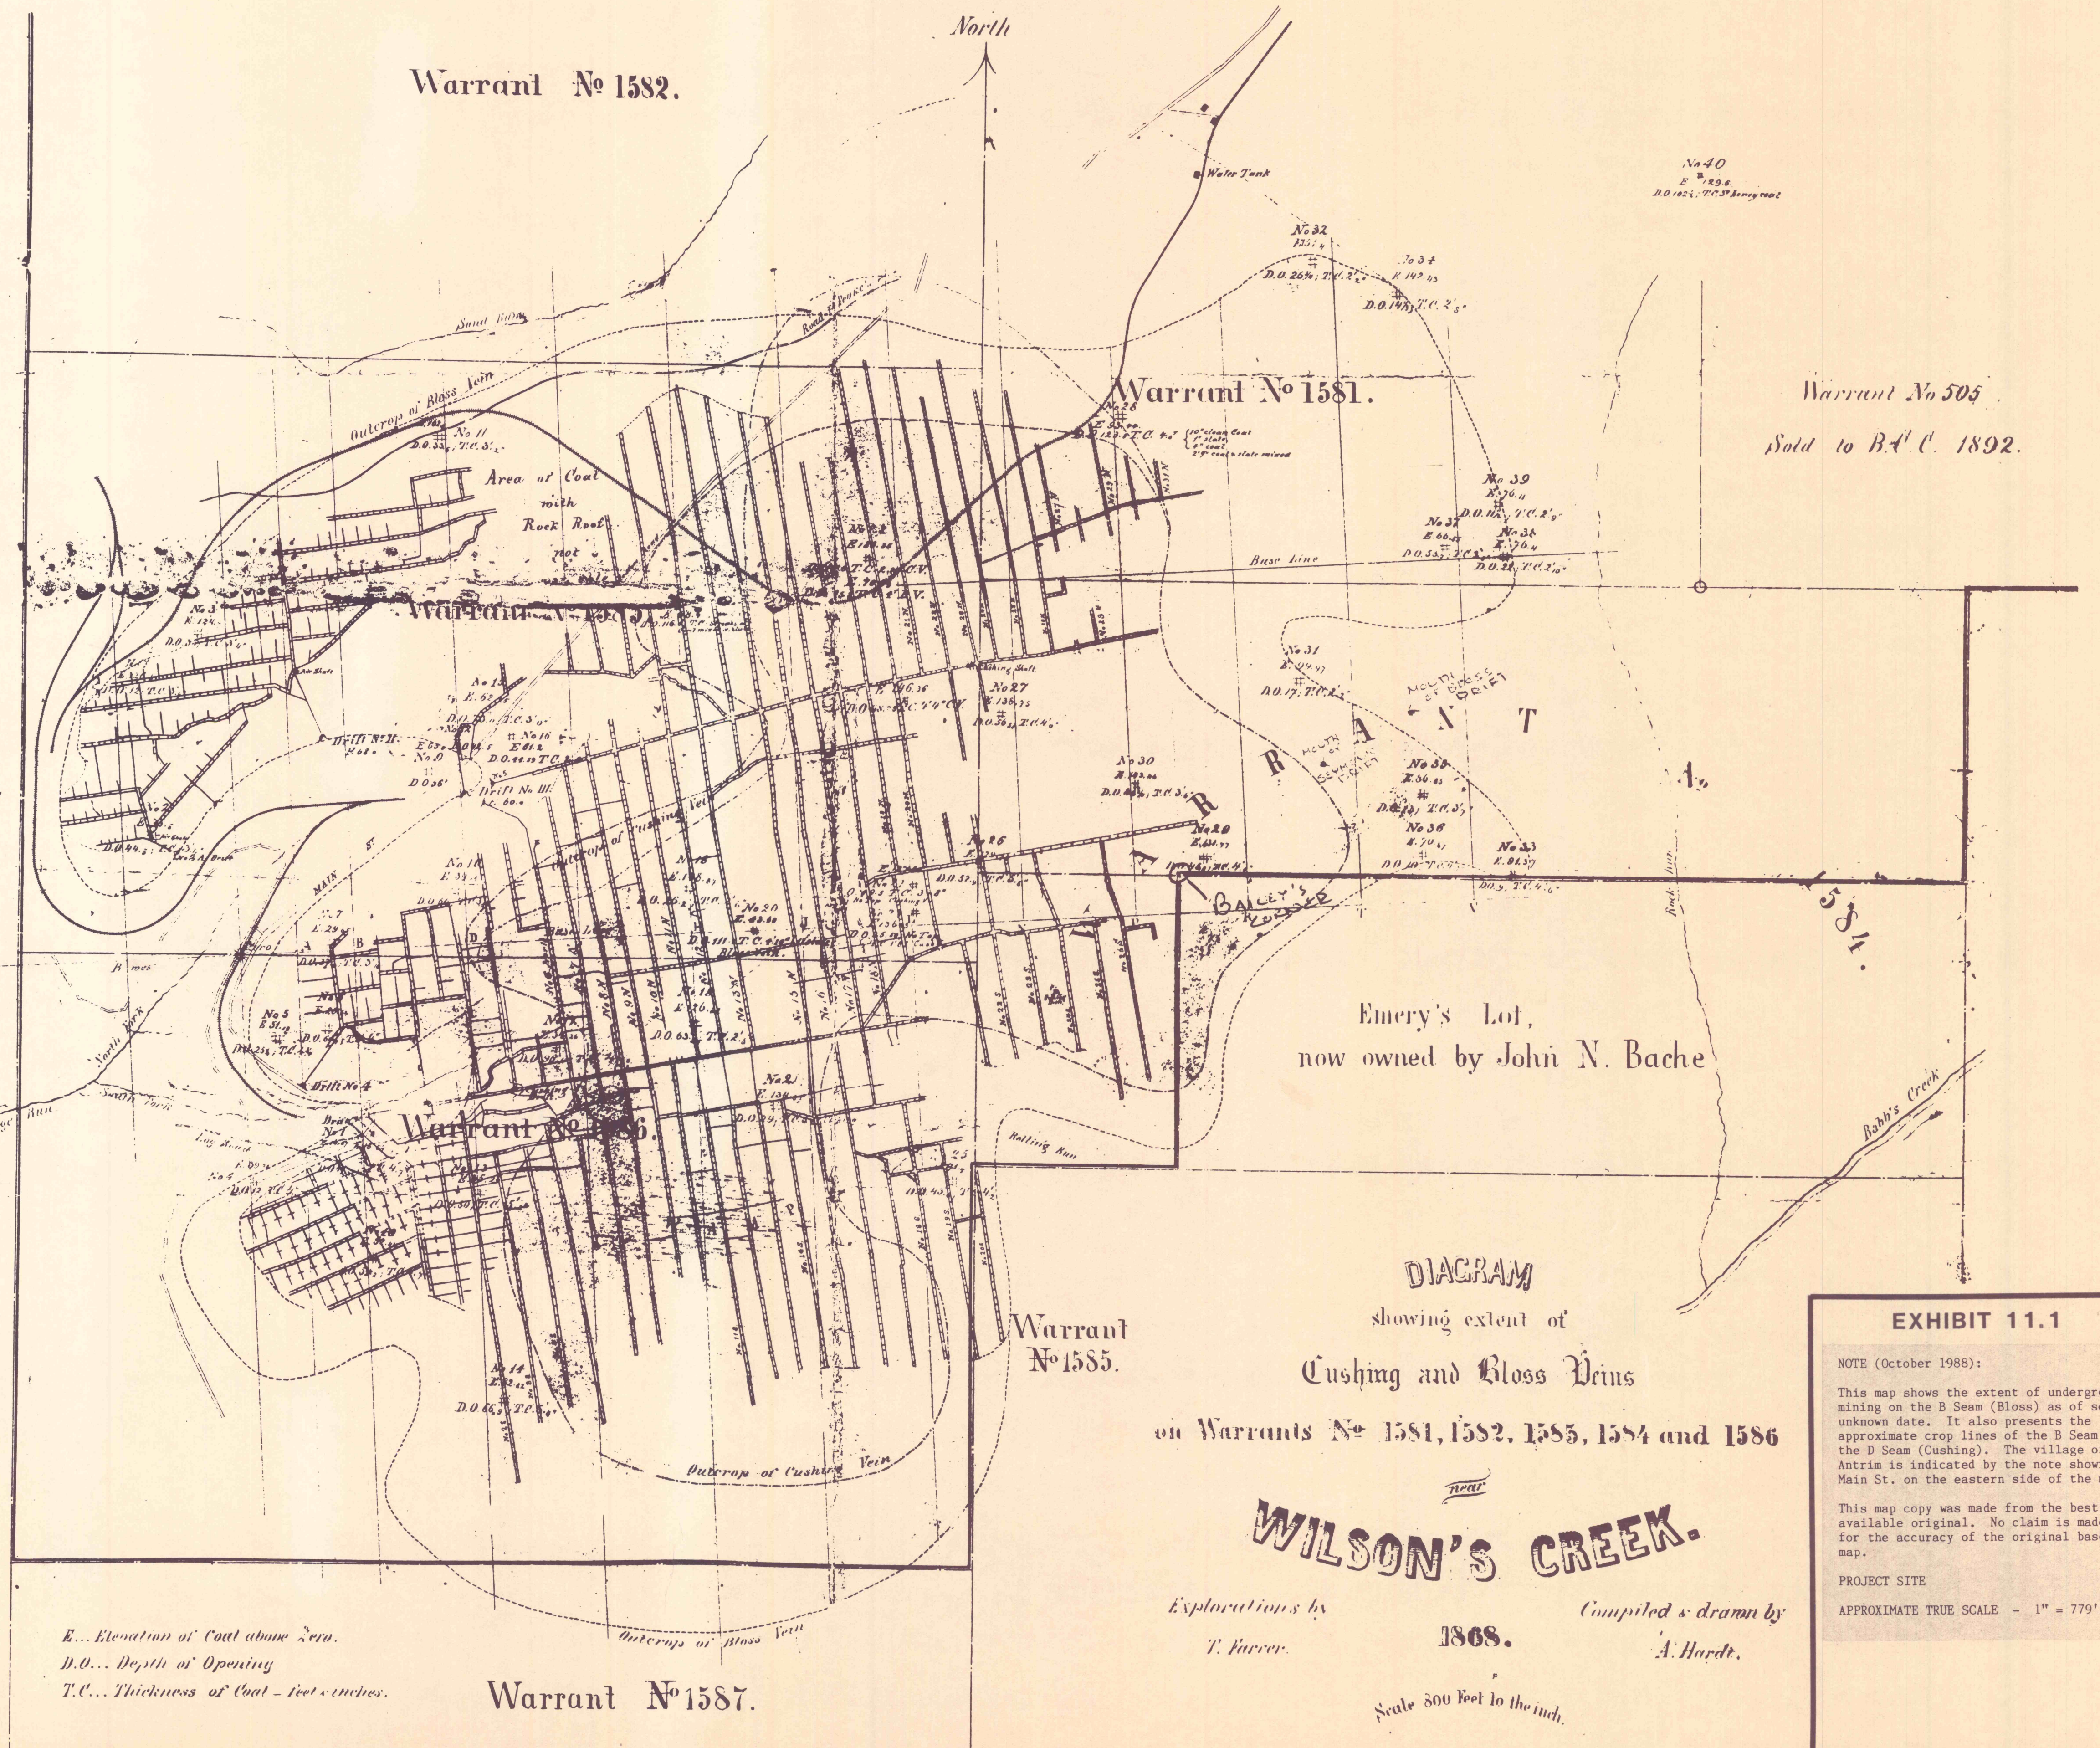


DIAGRAM
showing extent of
Cushing and Bloss Veins
on Warrants No. 1581, 1582, 1585, 1584 and 1586

near
WILSON'S CREEK.

Explorations by
T. Harver.
1868.
Compiled & drawn by
A. Harde.

Scale 300 Feet to the inch.

Warrant No 505
Sold to B.A.C. 1892.

EXHIBIT 11.1

NOTE (October 1988):
This map shows the extent of underground mining on the B Seam (Bloss) as of some unknown date. It also presents the approximate crop lines of the B Seam and the D Seam (Cushing). The village of Antrim is indicated by the note showing Main St. on the eastern side of the map.

This map copy was made from the best available original. No claim is made for the accuracy of the original base map.

PROJECT SITE
APPROXIMATE TRUE SCALE - 1" = 779'

E... Elevation of Coal above Zero.
D.O... Depth of Opening
T.C... Thickness of Coal - feet & inches.

Warrant No 1587.