

NOTE: ALSO SEE INDEX MAP

H 6

DOCT. OF ENV. RESOURCES  
HAWK RUN DISTRICT OFFICE  
NOV 3 1994  
RECEIVED

REVISIONS	
9/80	HYDRAULIC SEALS DELETED-SUPPORT AREA INCREASED.
8/22/91	MINOR BOUNDARY CORRECTION-2.5 AC. - MINING
9/29/94	MINOR BOUNDARY CORRECTION 8.98 ± AC. - SUPPORT SMP-41870101

NOTES	
ASH POND G.W. MONITOR SITES	A1 A2
STRIKE AND DIP	

LEGEND	
PROPOSED PERMIT	--- PROPOSED PERMIT
EXISTING PERMIT 41850101	--- EXISTING PERMIT 41850101
EXISTING PERMIT 4770BSH10	--- EXISTING PERMIT 4770BSH10
EXISTING HAUL ROADS	--- EXISTING HAUL ROADS
SLOPE MEASUREMENT	--- SLOPE MEASUREMENT
ESTIMATED LIMIT OF DEEP MINE POOL	--- ESTIMATED LIMIT OF DEEP MINE POOL
TEST HOLE	○ TEST HOLE
STRIKE AND DIP	--- STRIKE AND DIP
KITTANNING (A) CROPLINE	--- KITTANNING (A) CROPLINE
MIDDLE KITTANNING (C) CROPLINE	--- MIDDLE KITTANNING (C) CROPLINE
LOWER FREEPORT (D) CROPLINE	--- LOWER FREEPORT (D) CROPLINE
COAL (STRIPPED OUT)	--- COAL (STRIPPED OUT)
GROUND WATER FLOW	--- GROUND WATER FLOW
PRIVATE WELL (FISHER)	○ PRIVATE WELL (FISHER)
MONITORING POINT (A10 See Index Map)	○ MONITORING POINT (A10 See Index Map)
OVERBURDEN ANALYSIS TEST HOLES	○ OVERBURDEN ANALYSIS TEST HOLES
PROPOSED PERMIT SUPPORT AREA	--- PROPOSED PERMIT SUPPORT AREA
IRON BOGS	□ IRON BOGS
FLOWS ABOVE COAL	--- FLOWS ABOVE COAL
SEEP LINE	--- SEEP LINE
UNDERGROUND MINED	--- UNDERGROUND MINED
SURFACE MINED	--- SURFACE MINED

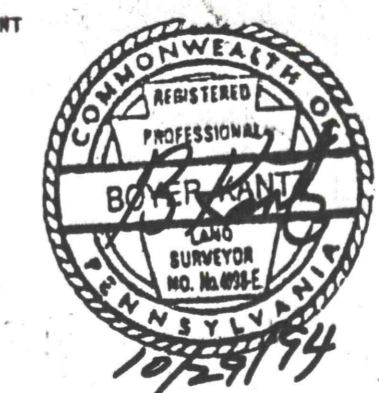


EXHIBIT 6.2 ENVIRONMENTAL RESOURCES MAP  
FISHER MINING CO. INC. SMP 41840101 AND SMP 41870101  
PINE TOWNSHIP, LYCOMING COUNTY, PENNSYLVANIA  
SCALE 1" = 200 FEET CONTOUR INTERVAL = 10 FEET  
PREPARED BY  
BOYER KANTZ AND ASSOCIATES  
EDWIN F. KOPPE, GEOLOGIST  
MAY 1984  
MSHA ID# 36-02703

41870101