
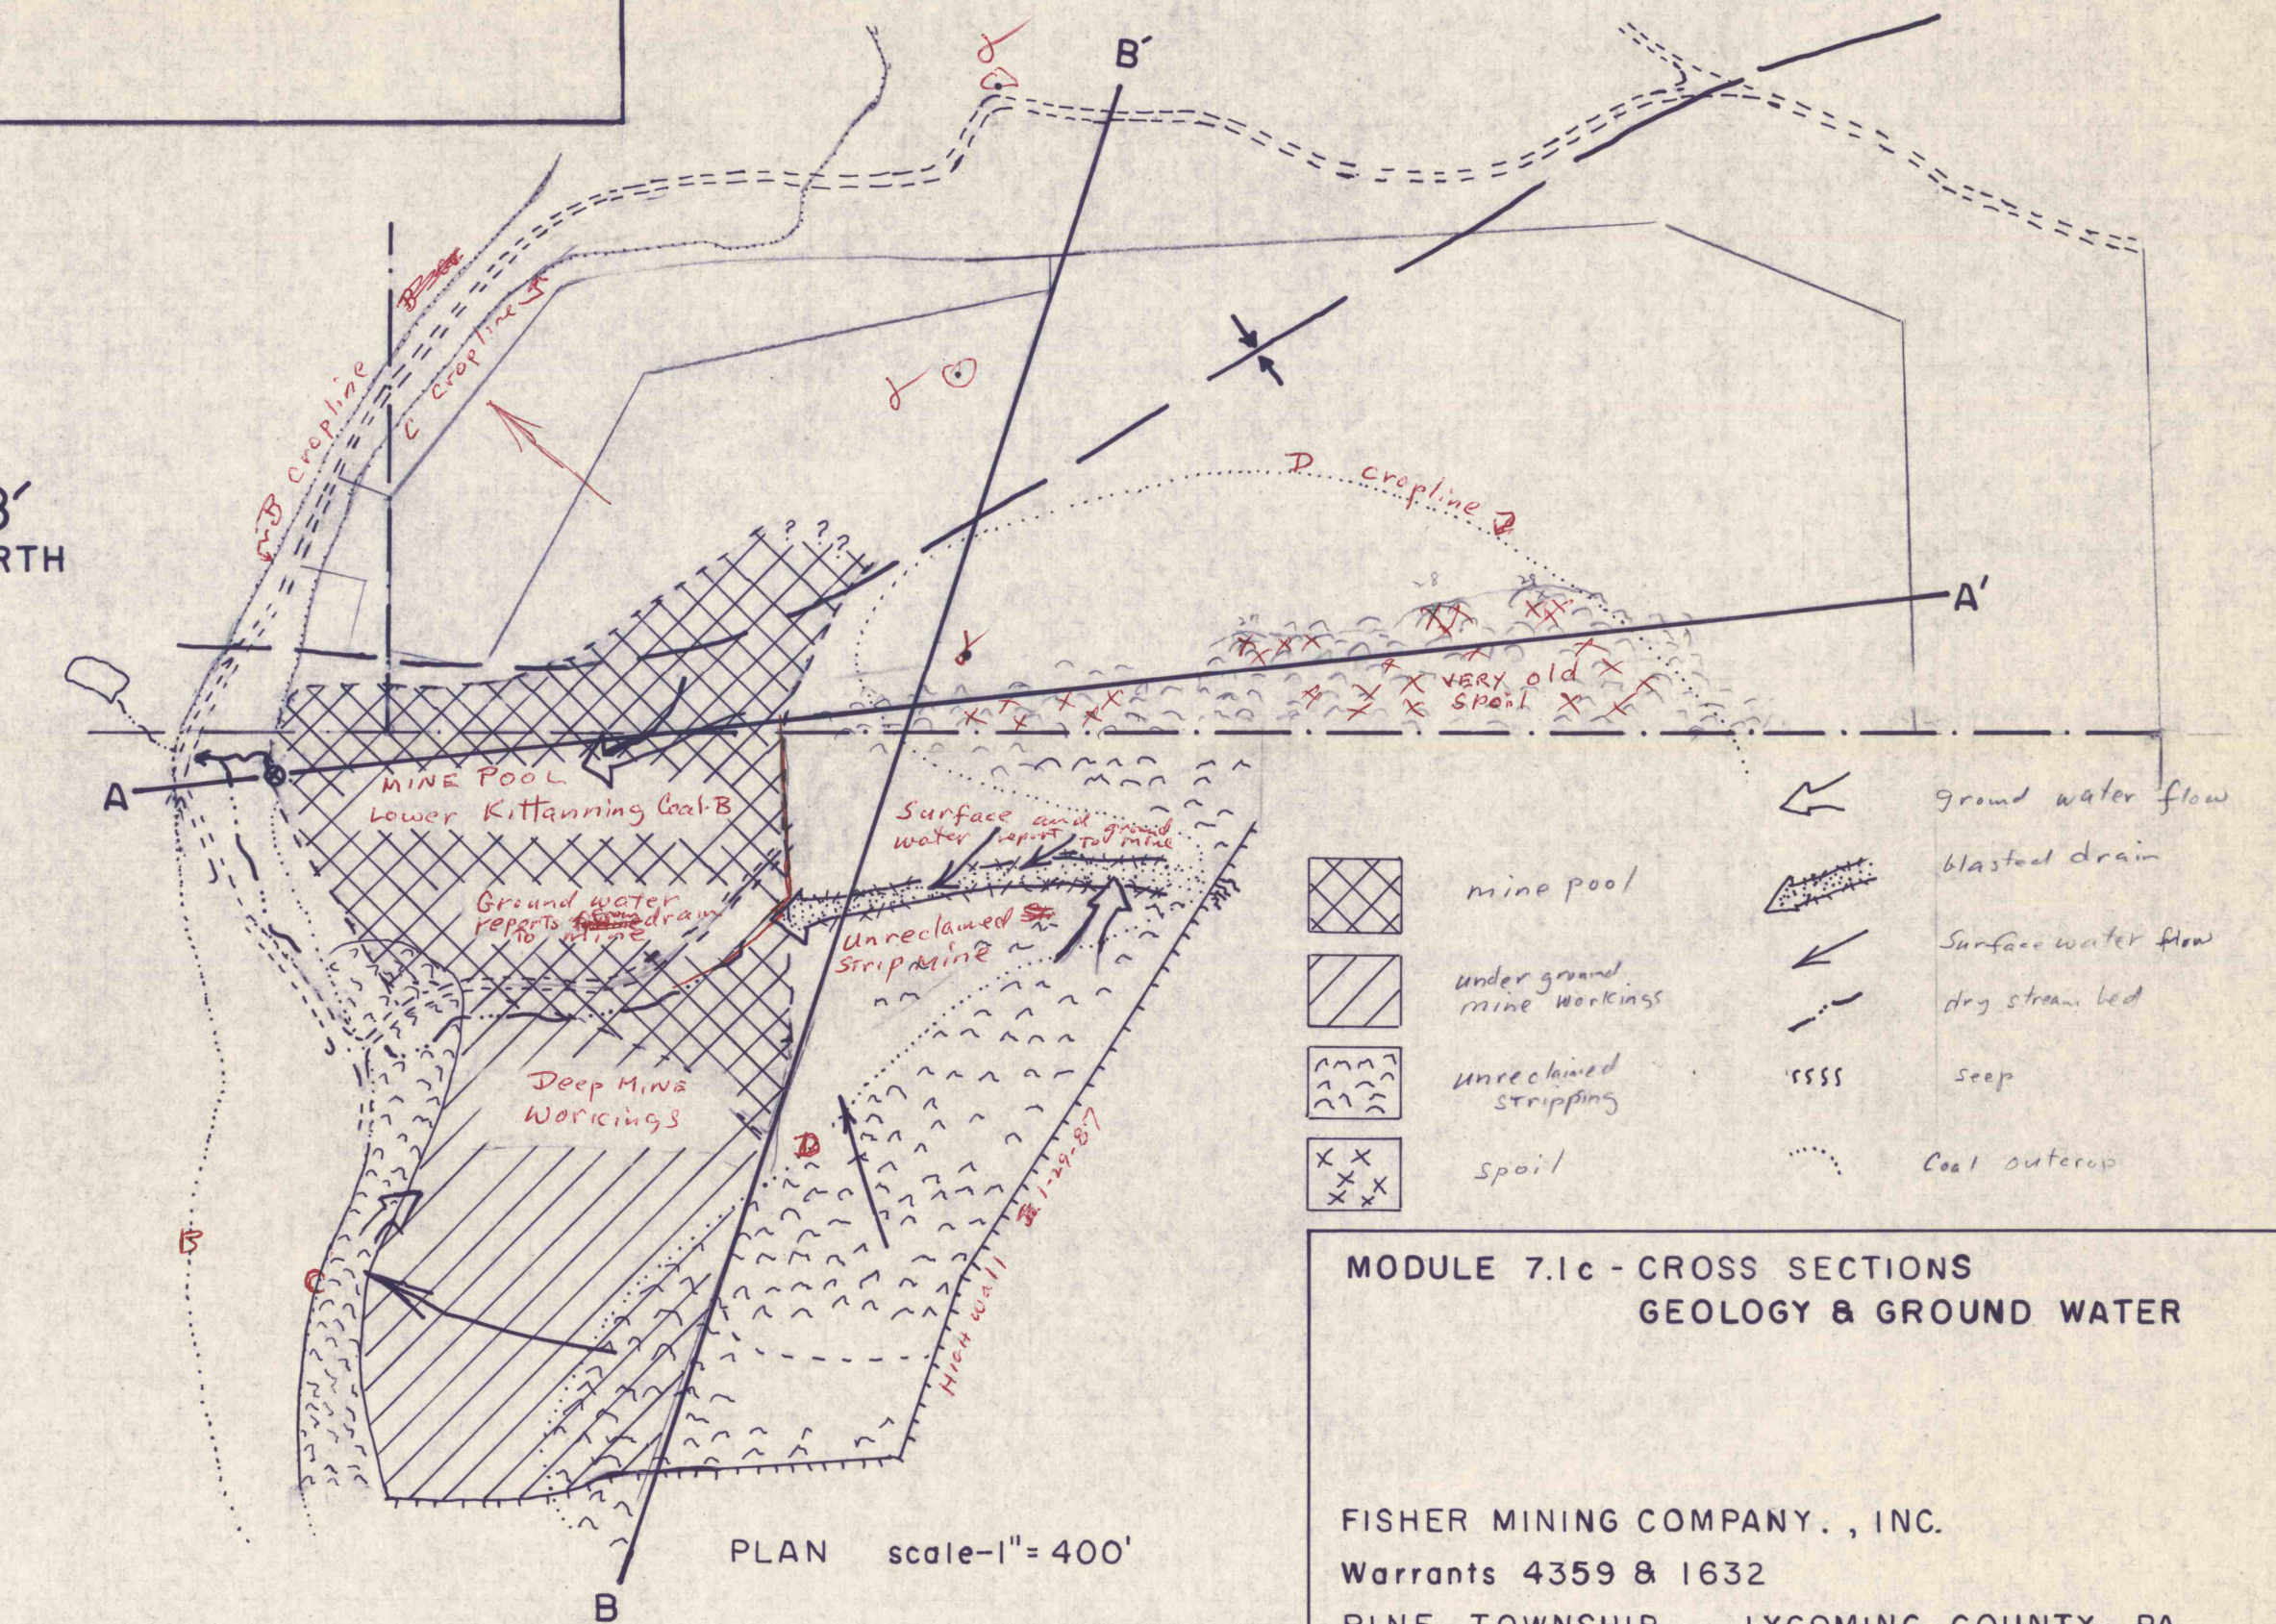
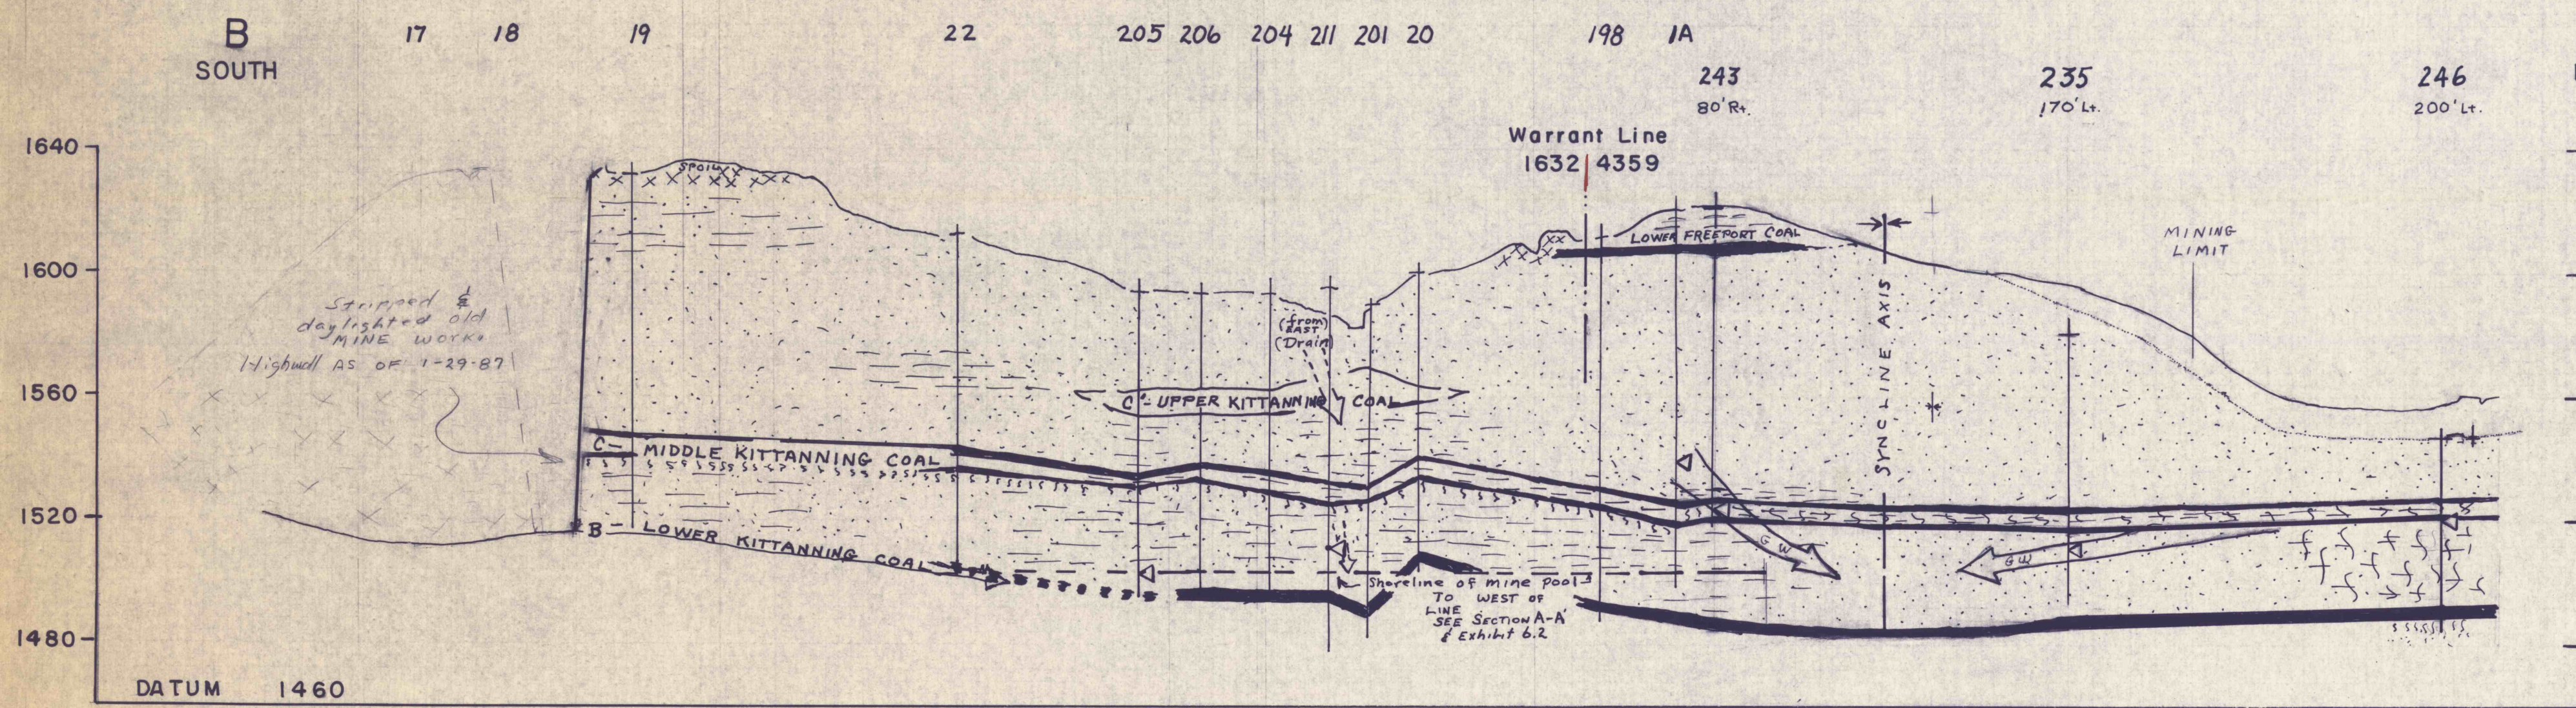


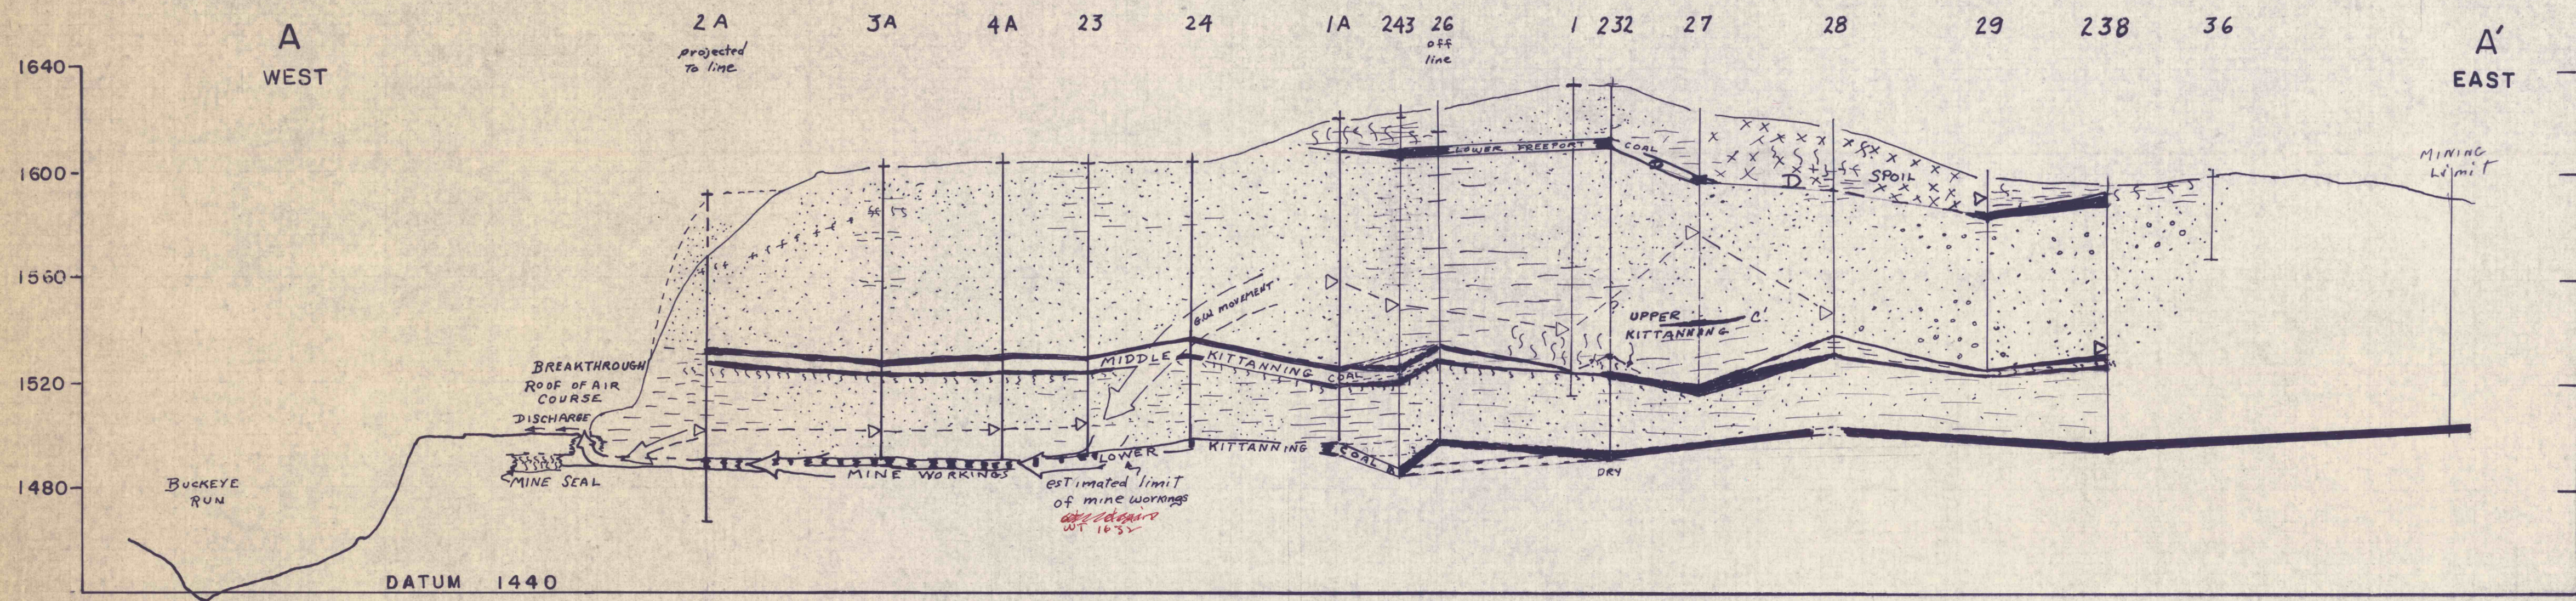

scale horizontal 1" = 200'
vertical 1" = 40'

- LEGEND**
- SANDSTONE
 - SANDSTONE SHALE OR SANDY SHALE
 - SHALE
 - CLAY-CLAYSTONE
 - COAL
 - MINE SPOIL
 - Groundwater level
 - DIRECTION OF FLOW GROUND WATER

COAL CORRELATIONS		
NAME	Standard letter designation	Local Name
Low. Freeport coal	D	E
Upper Kittanning coal	Ci	D
Middle Kittanning coal	upper Bed	C, C', C'' Split
	lower Bed	
Lower Kittanning coal	B	B

daylighted as shown in old diagrams

**MODULE 7.1c - CROSS SECTIONS
GEOLOGY & GROUND WATER**

FISHER MINING COMPANY, INC.
Warrants 4359 & 1632
PINE TOWNSHIP LYCOMING COUNTY, PA.

prepared by E.F. Koppe, Consulting Geologist