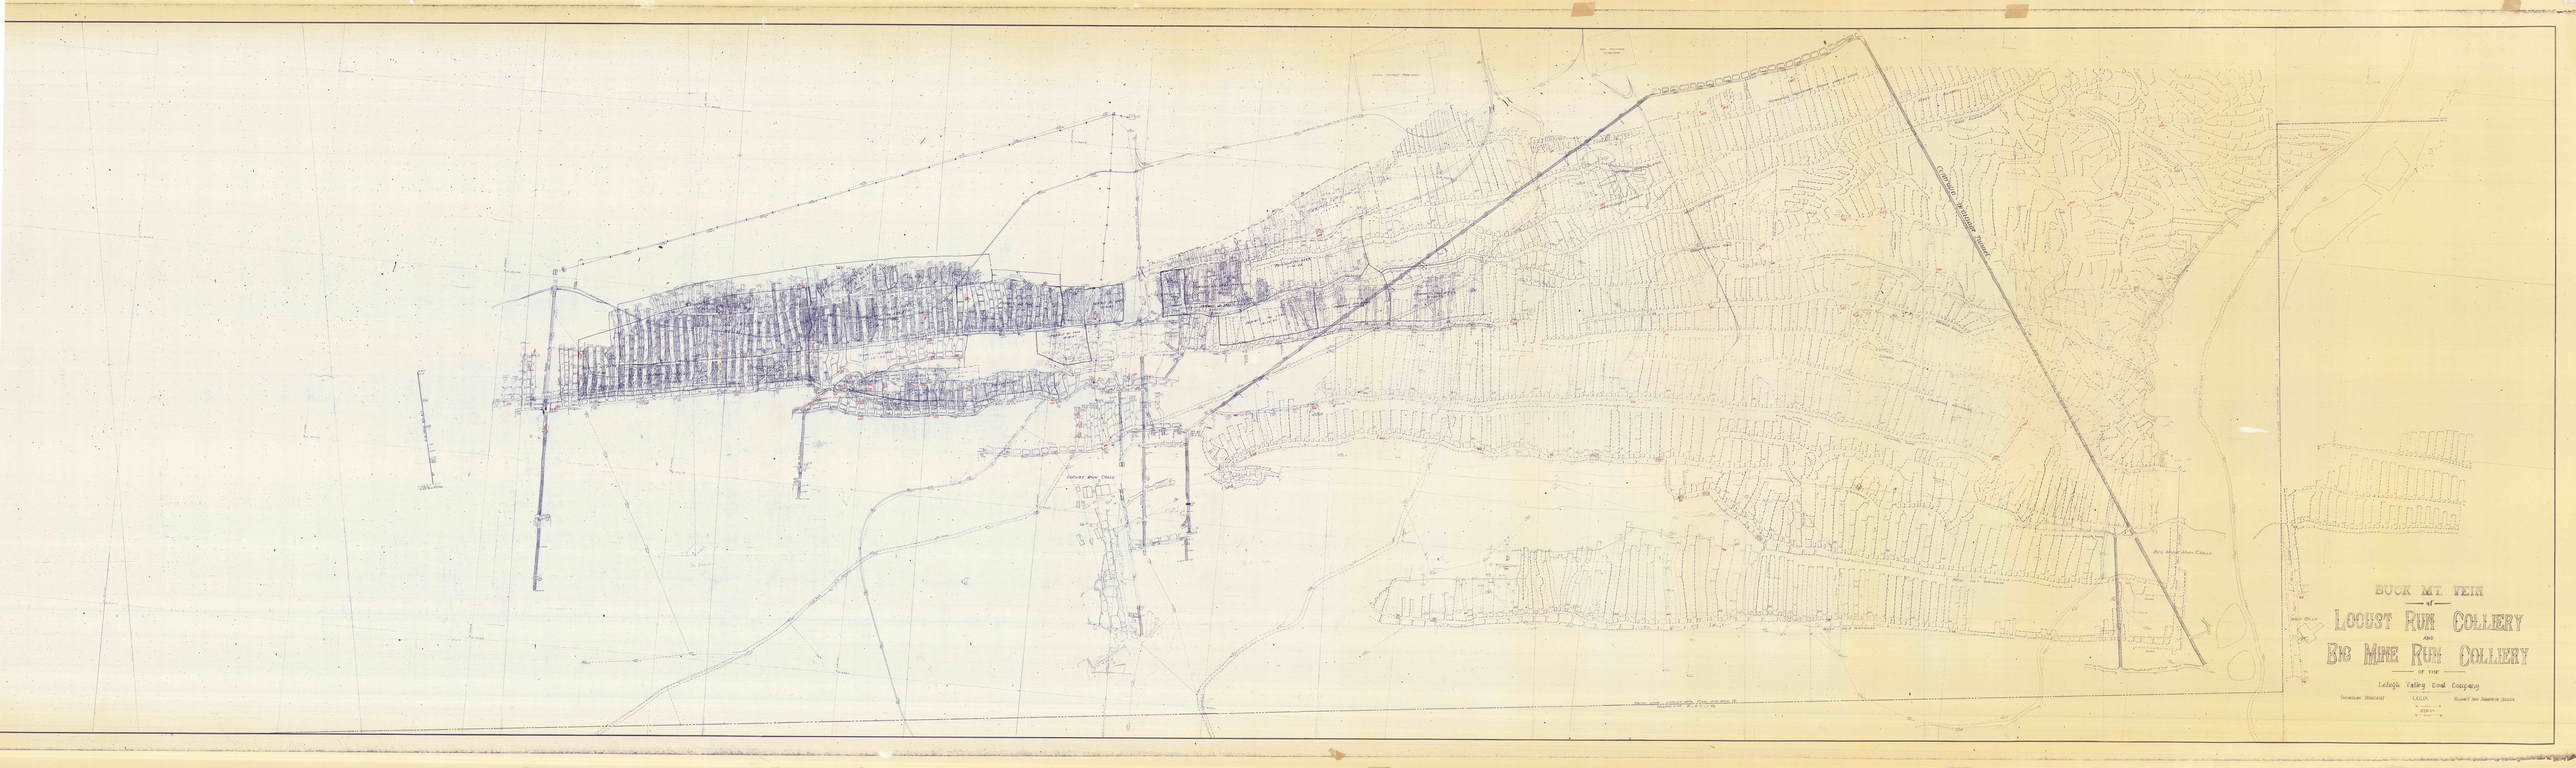

LOCUST RUN CREEK
BIG MINE RUN CREEK
BUCK MT. VEIN
of
LOCUST RUN COLLIERY
AND
BIG MINE RUN COLLIERY
of the
Lehigh Valley Coal Company