1" = 200'
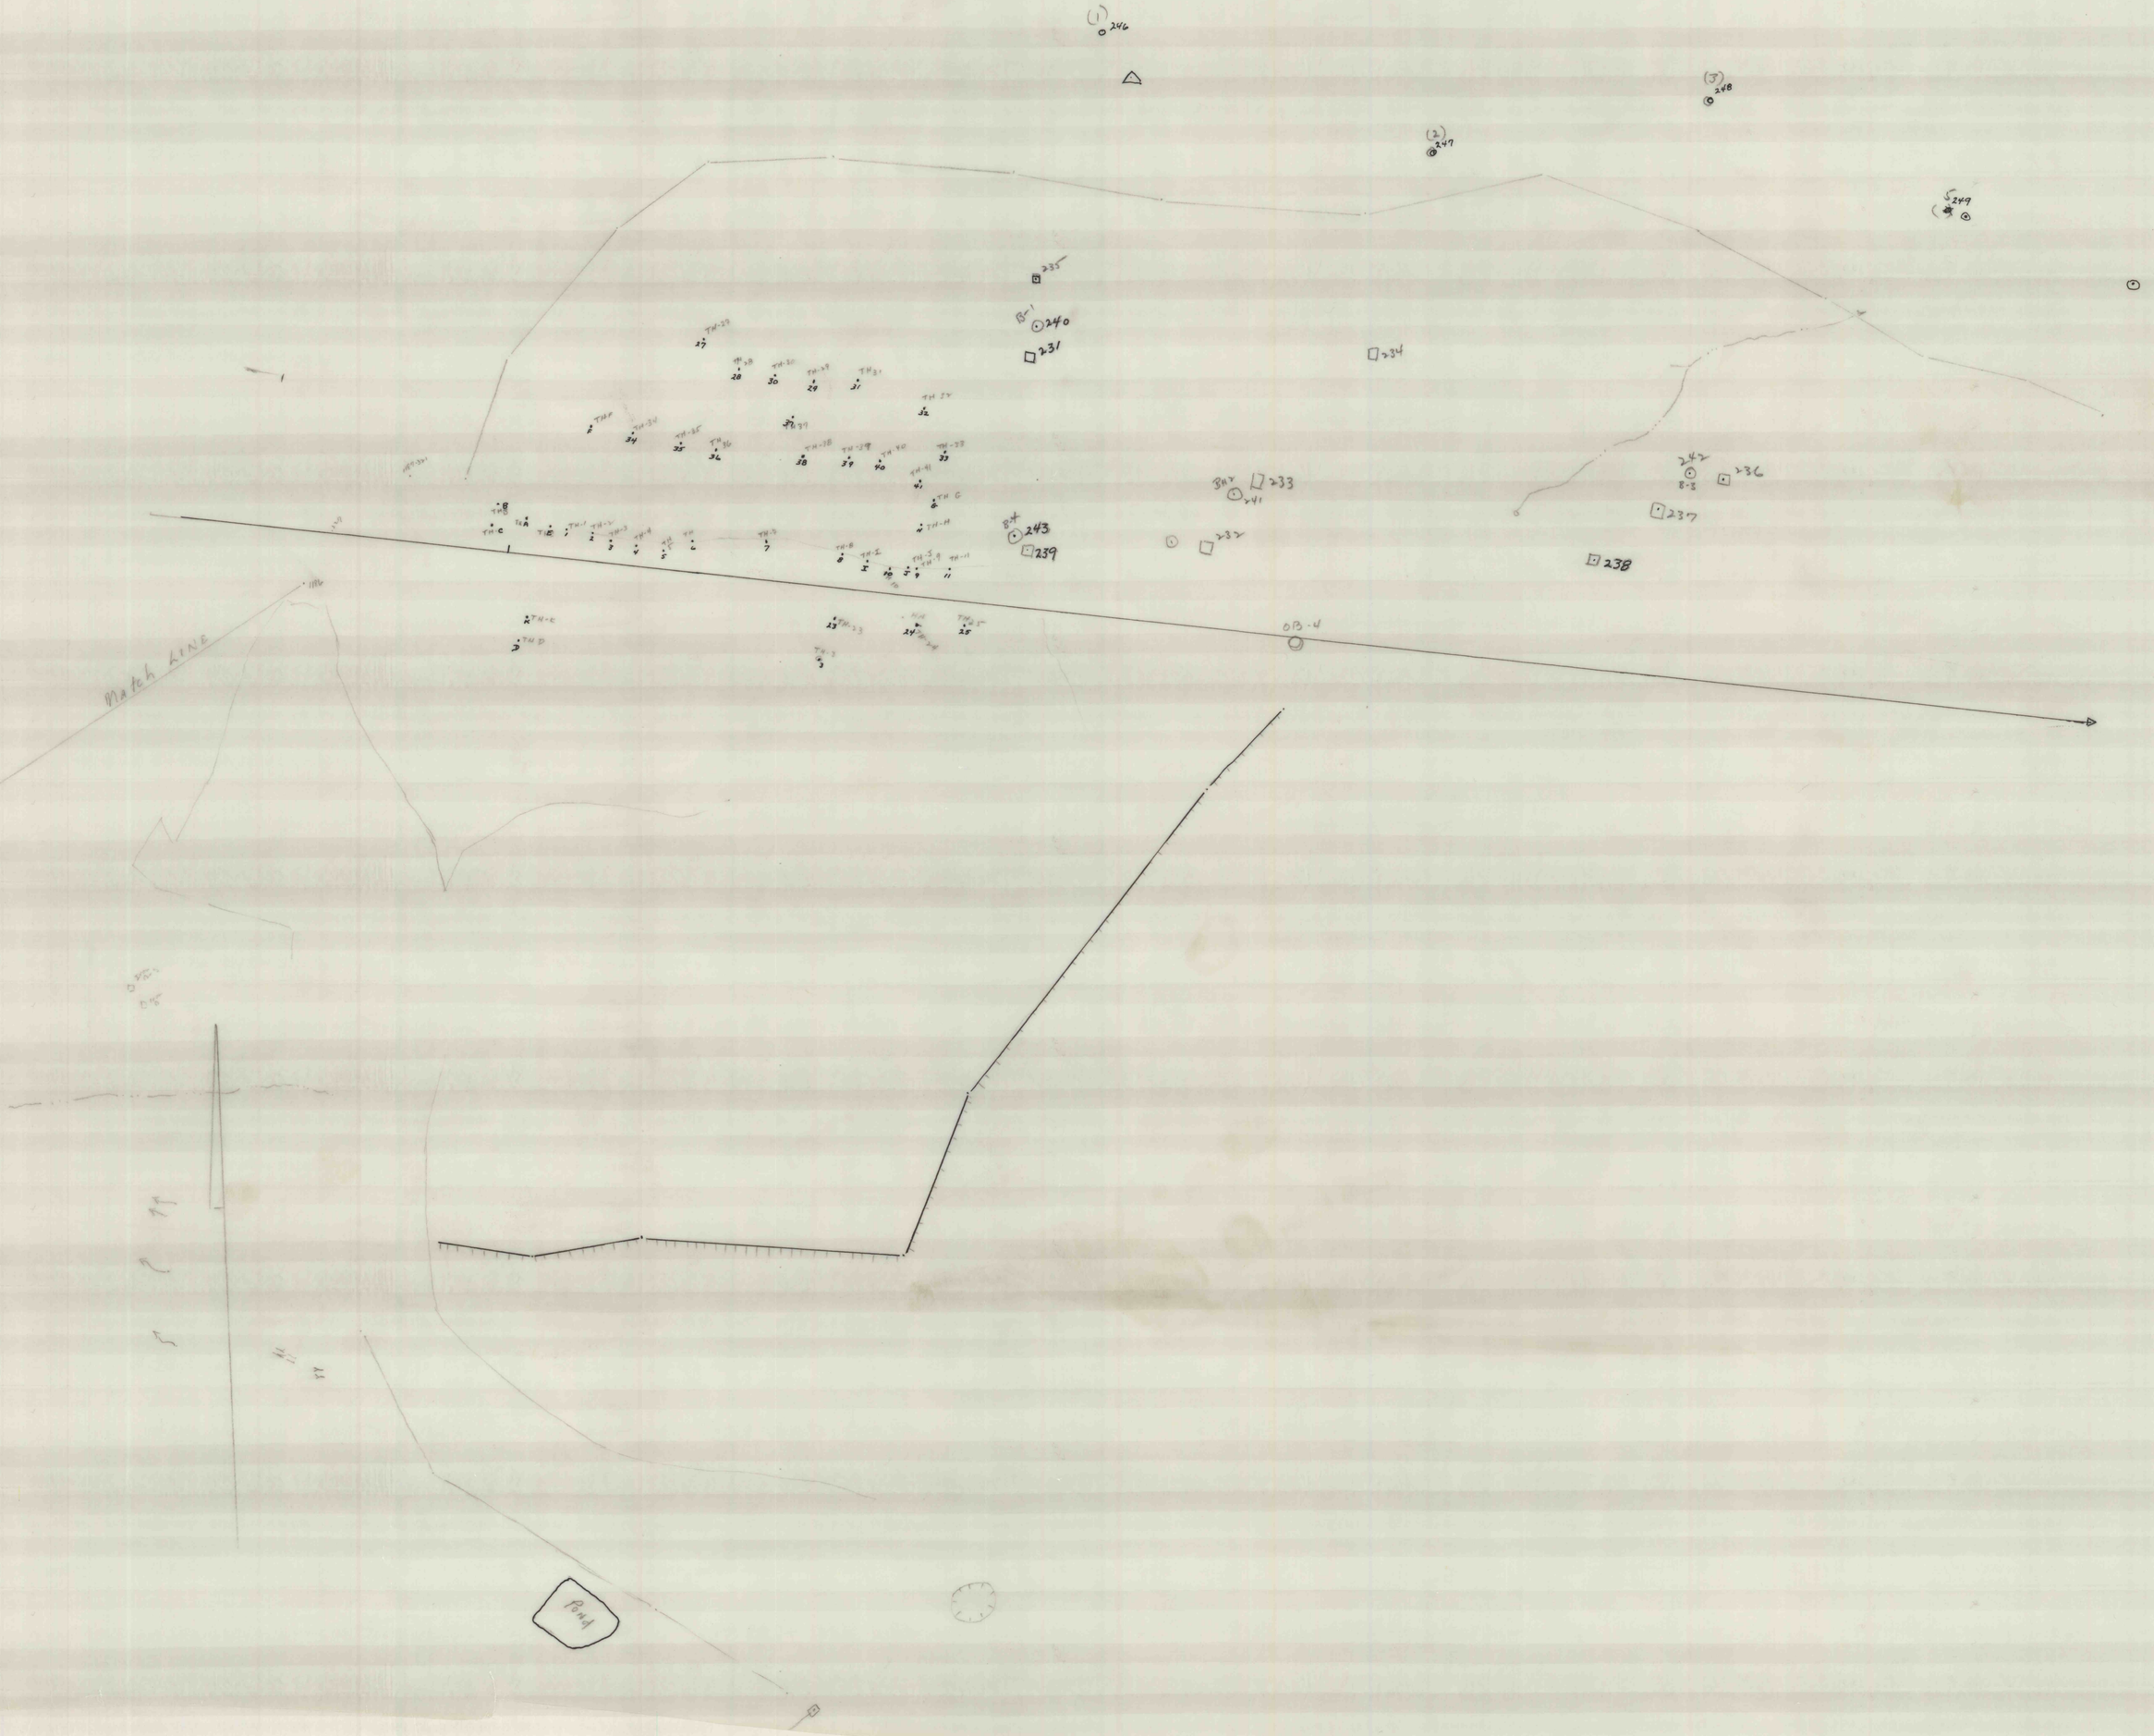
Fisher Mining Co